


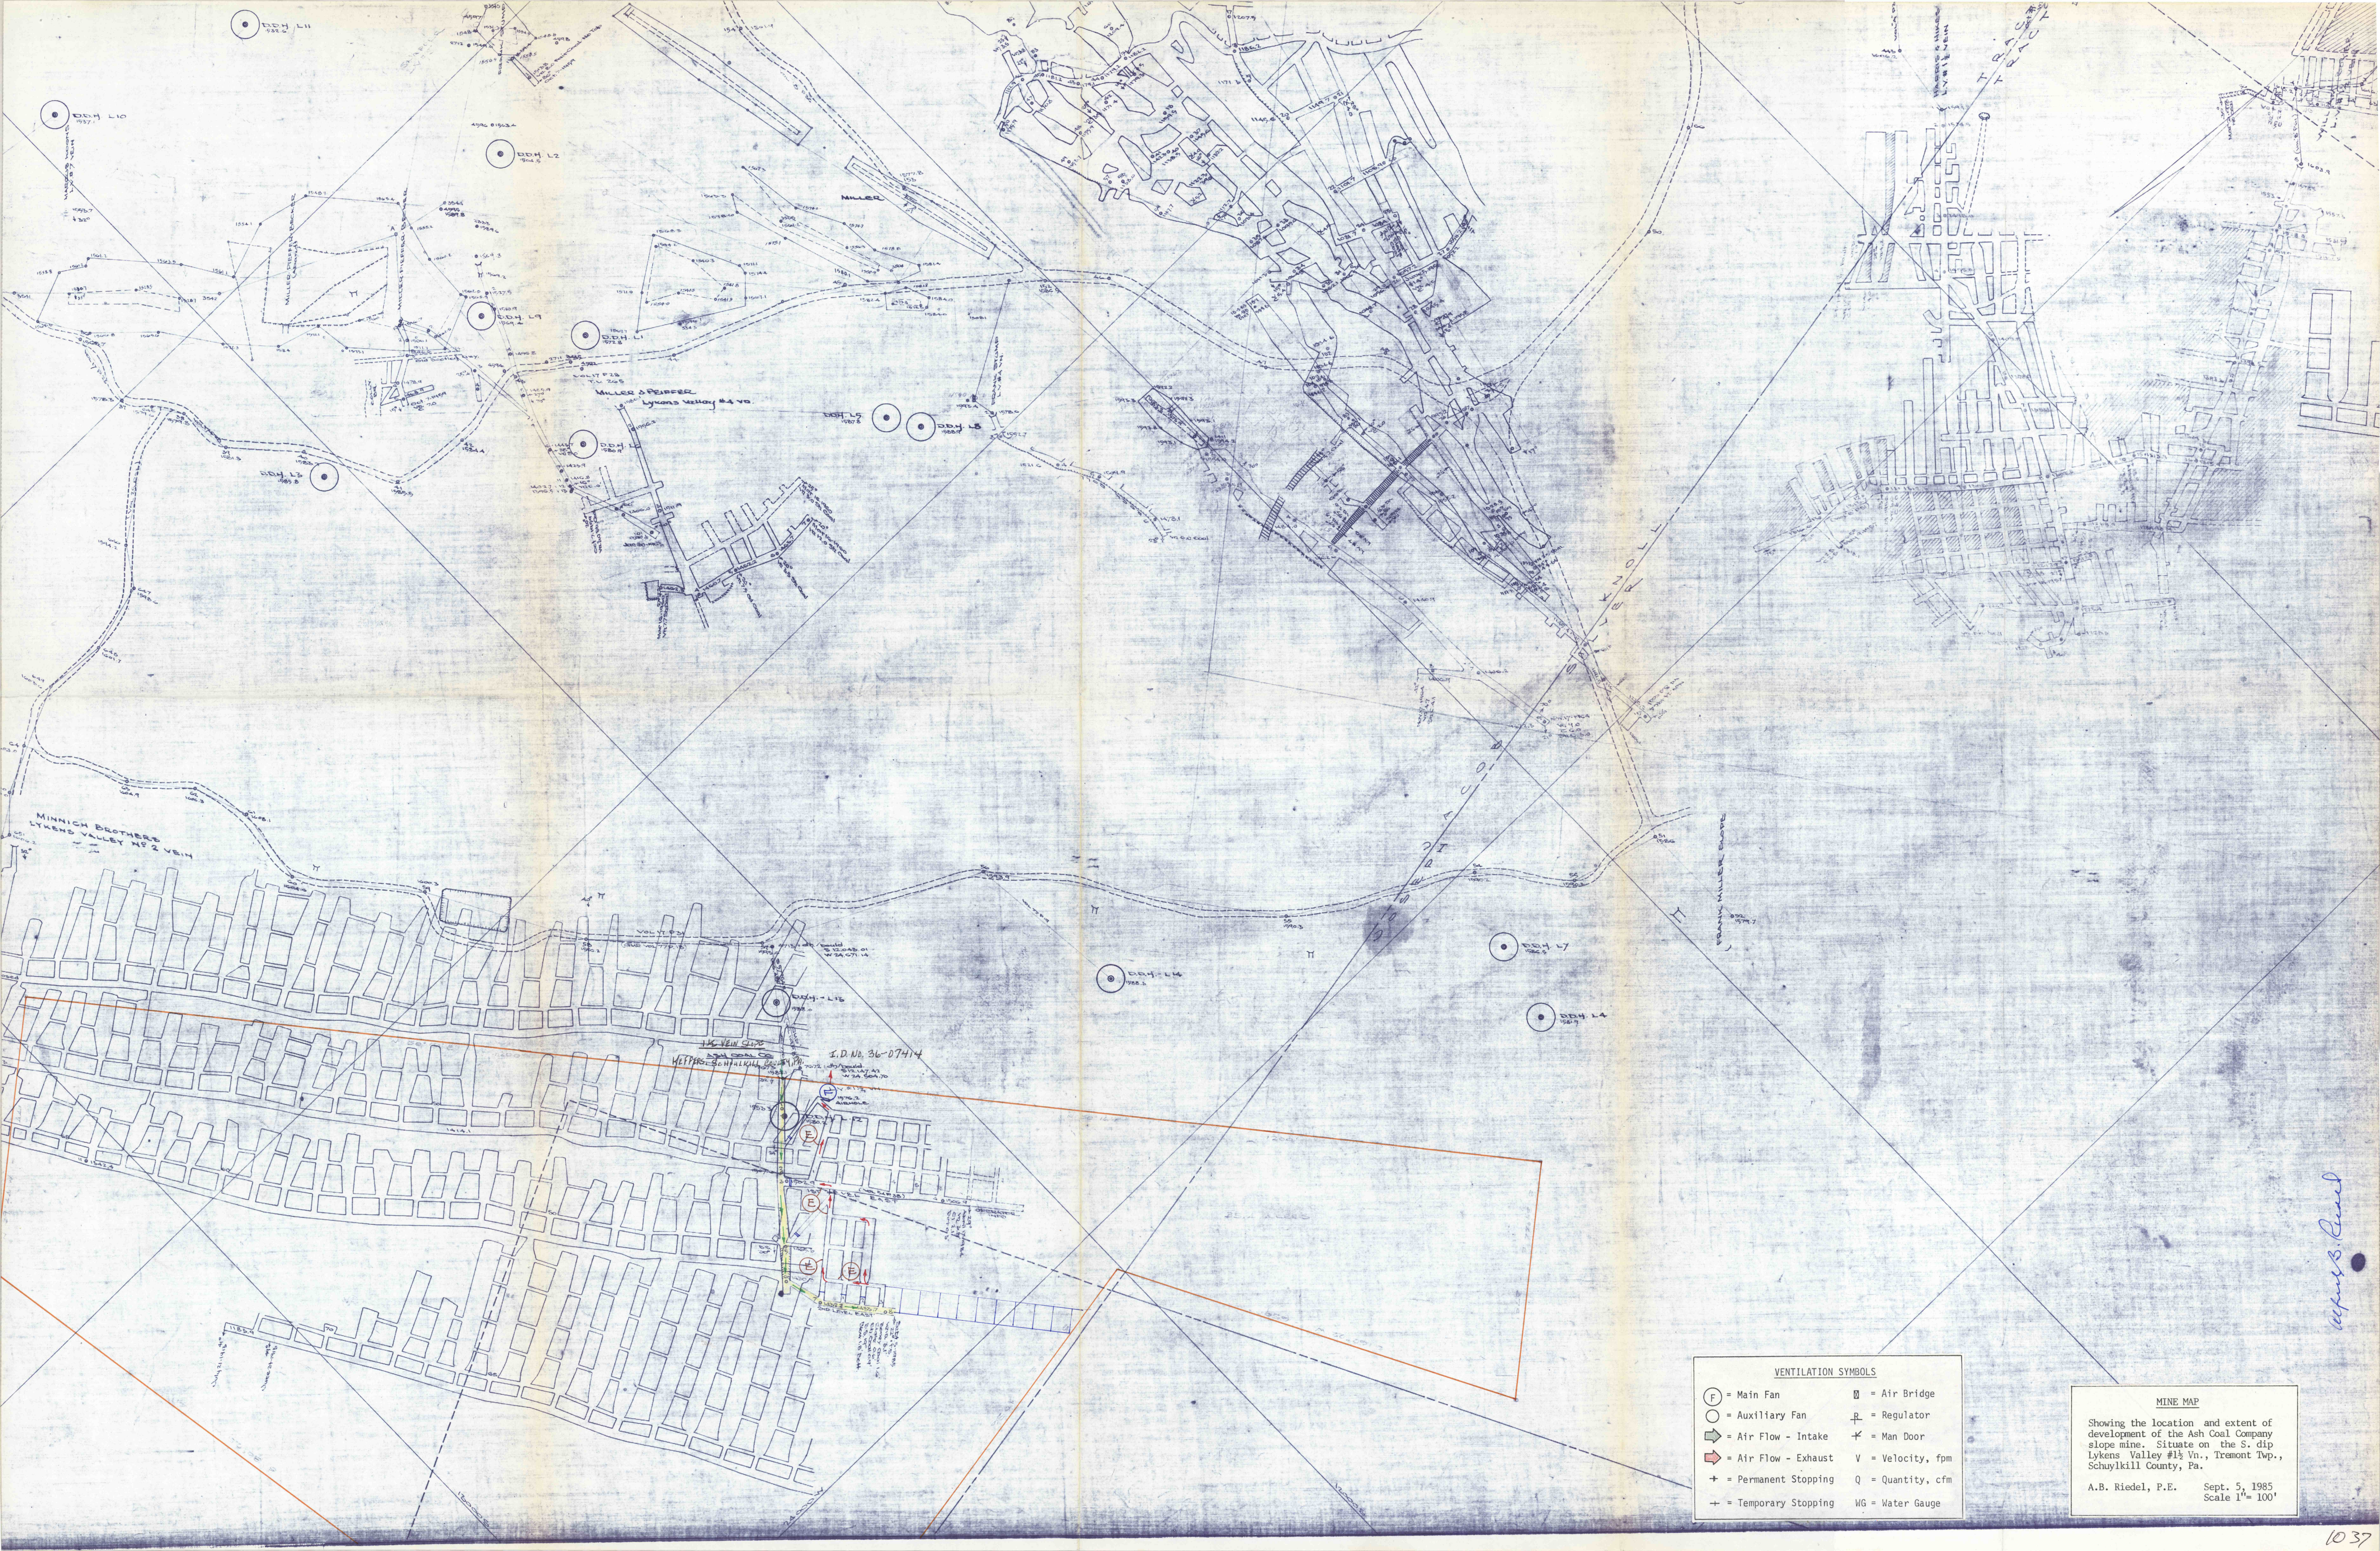

VENTILATION SYMBOLS	
(F) = Main Fan	⊠ = Air Bridge
(O) = Auxiliary Fan	⊥ = Regulator
→ = Air Flow - Intake	⋈ = Man Door
⇨ = Air Flow - Exhaust	V = Velocity, fpm
+ = Permanent Stopping	Q = Quantity, cfm
⊕ = Temporary Stopping	WG = Water Gauge

MINE MAP
Showing the location and extent of development of the Ash Coal Company slope mine. Situate on the S. dip Lykens Valley #1 1/2 Vn., Tremont Twp., Schuylkill County, Pa.
A.B. Riedel, P.E. Sept. 5, 1985
Scale 1" = 100'

april 8, 1986