


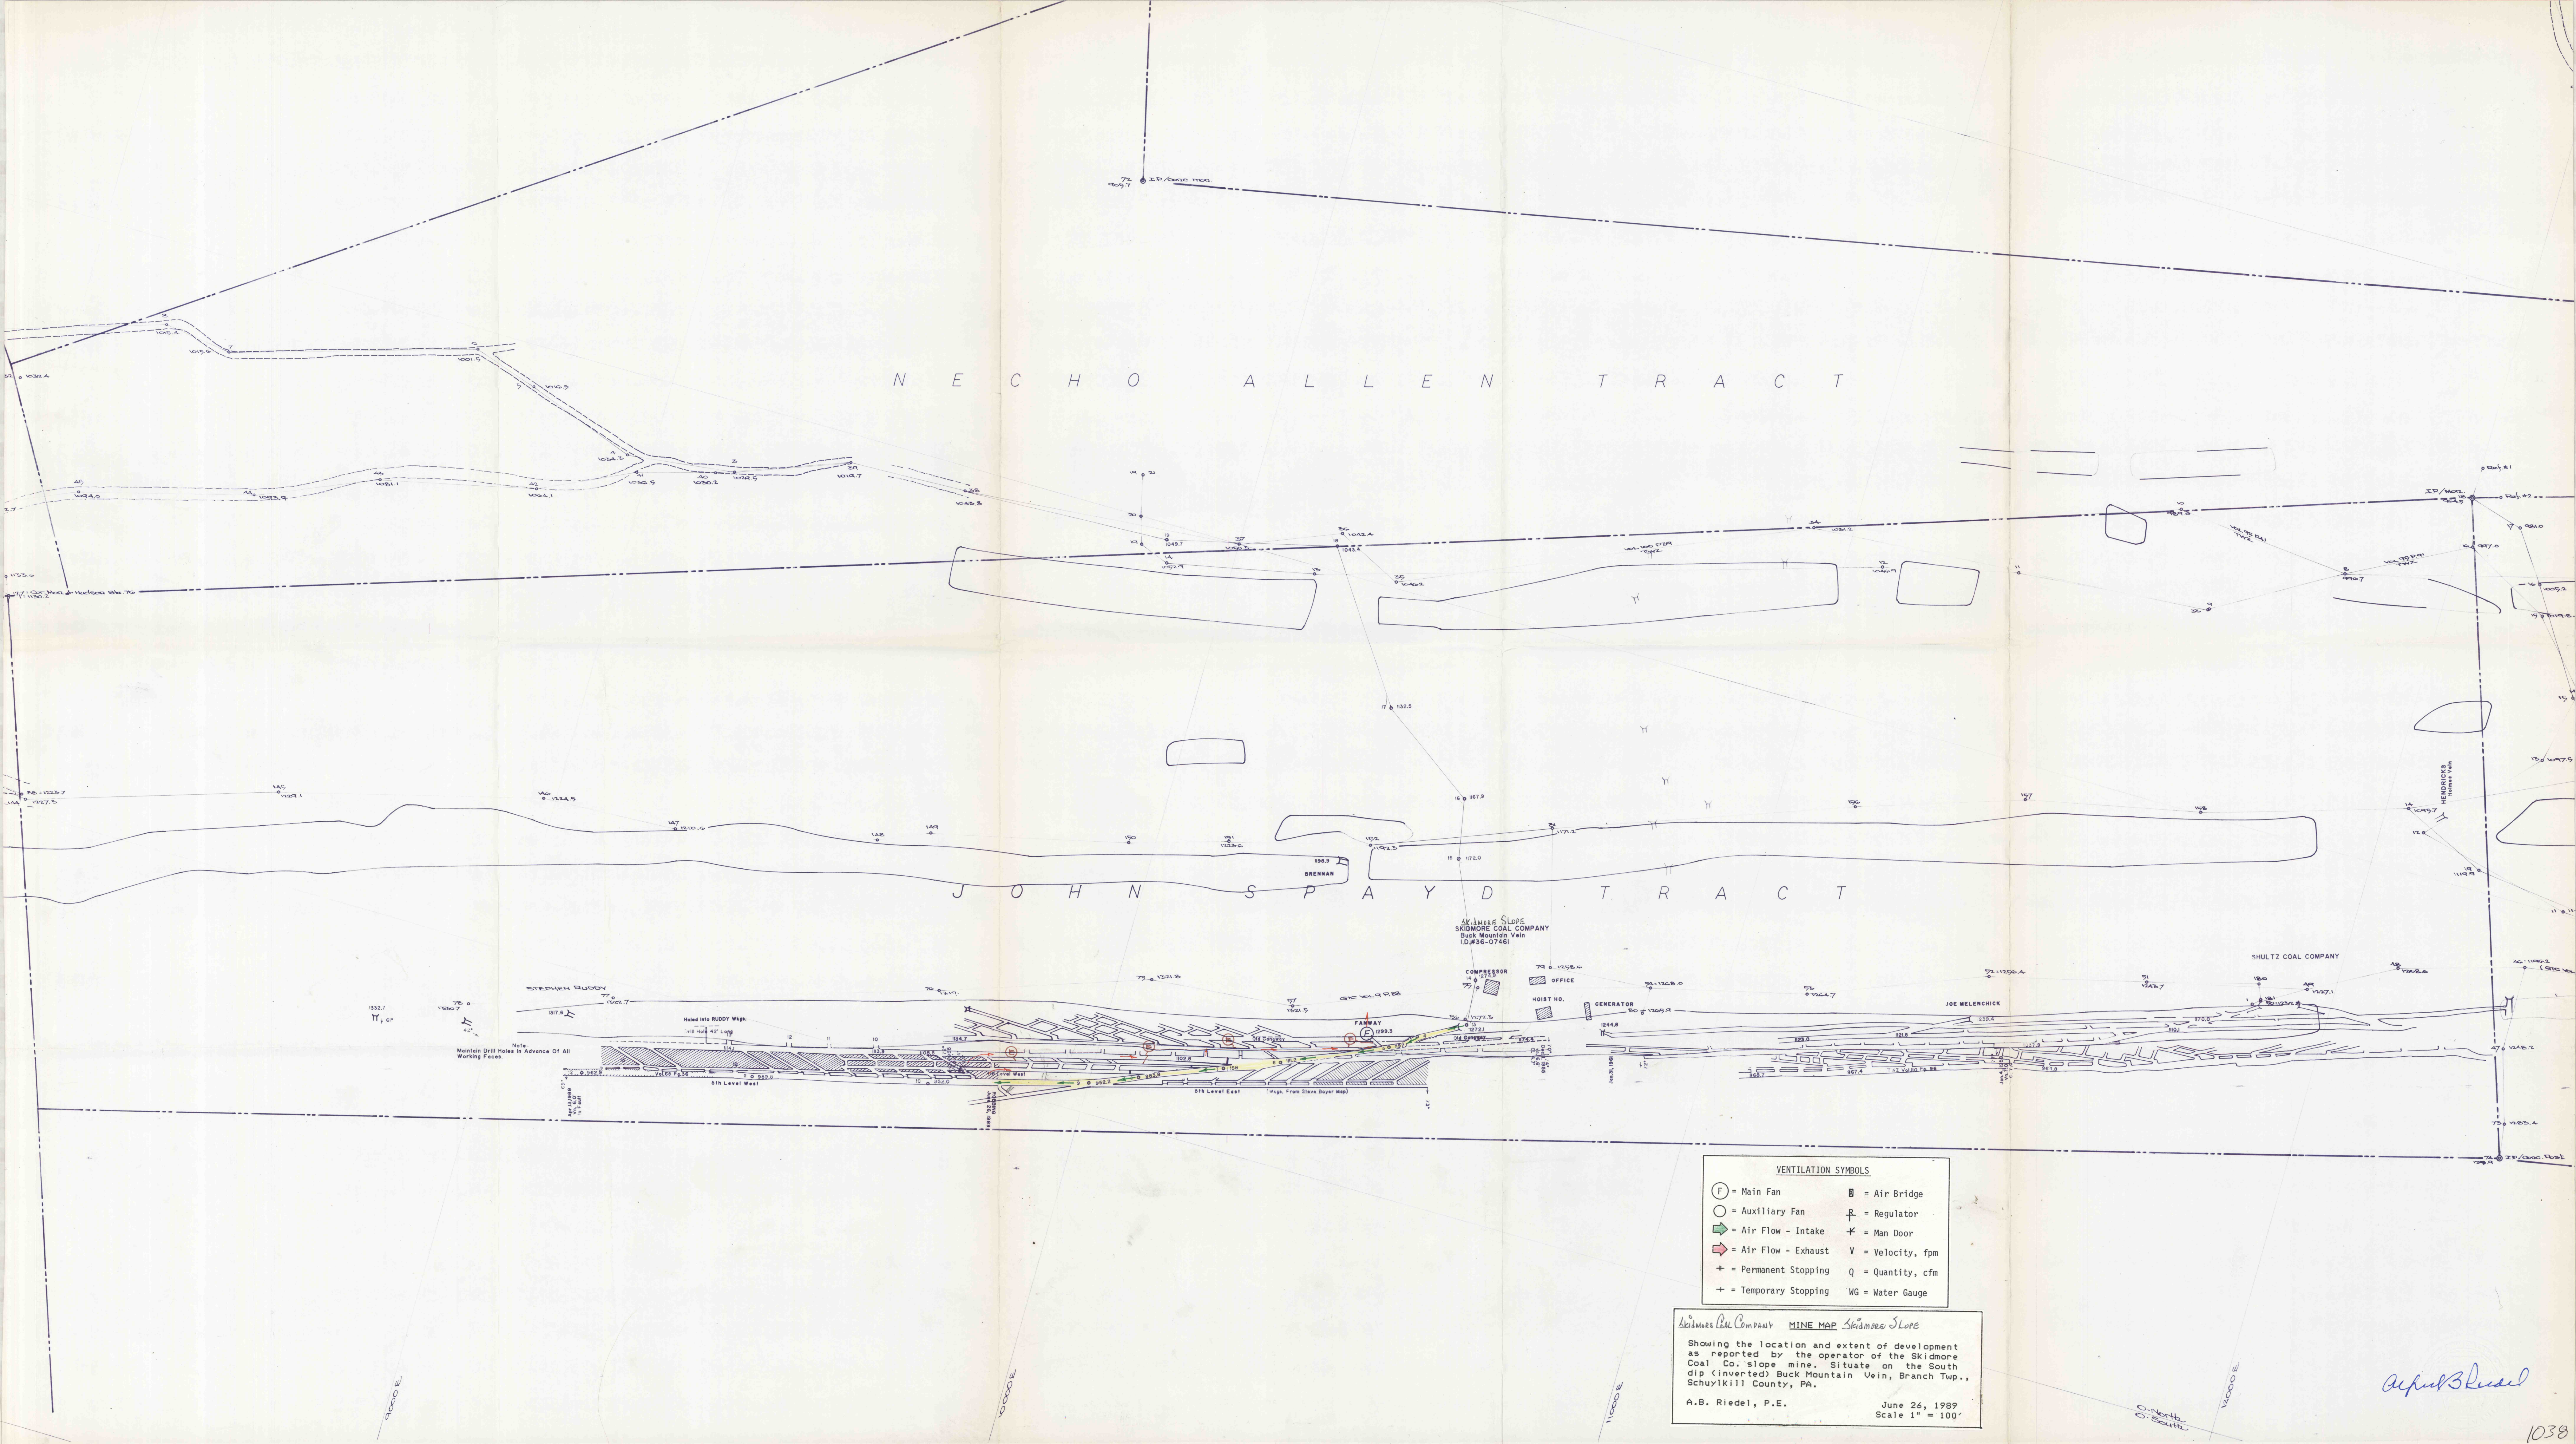

April 3 Read