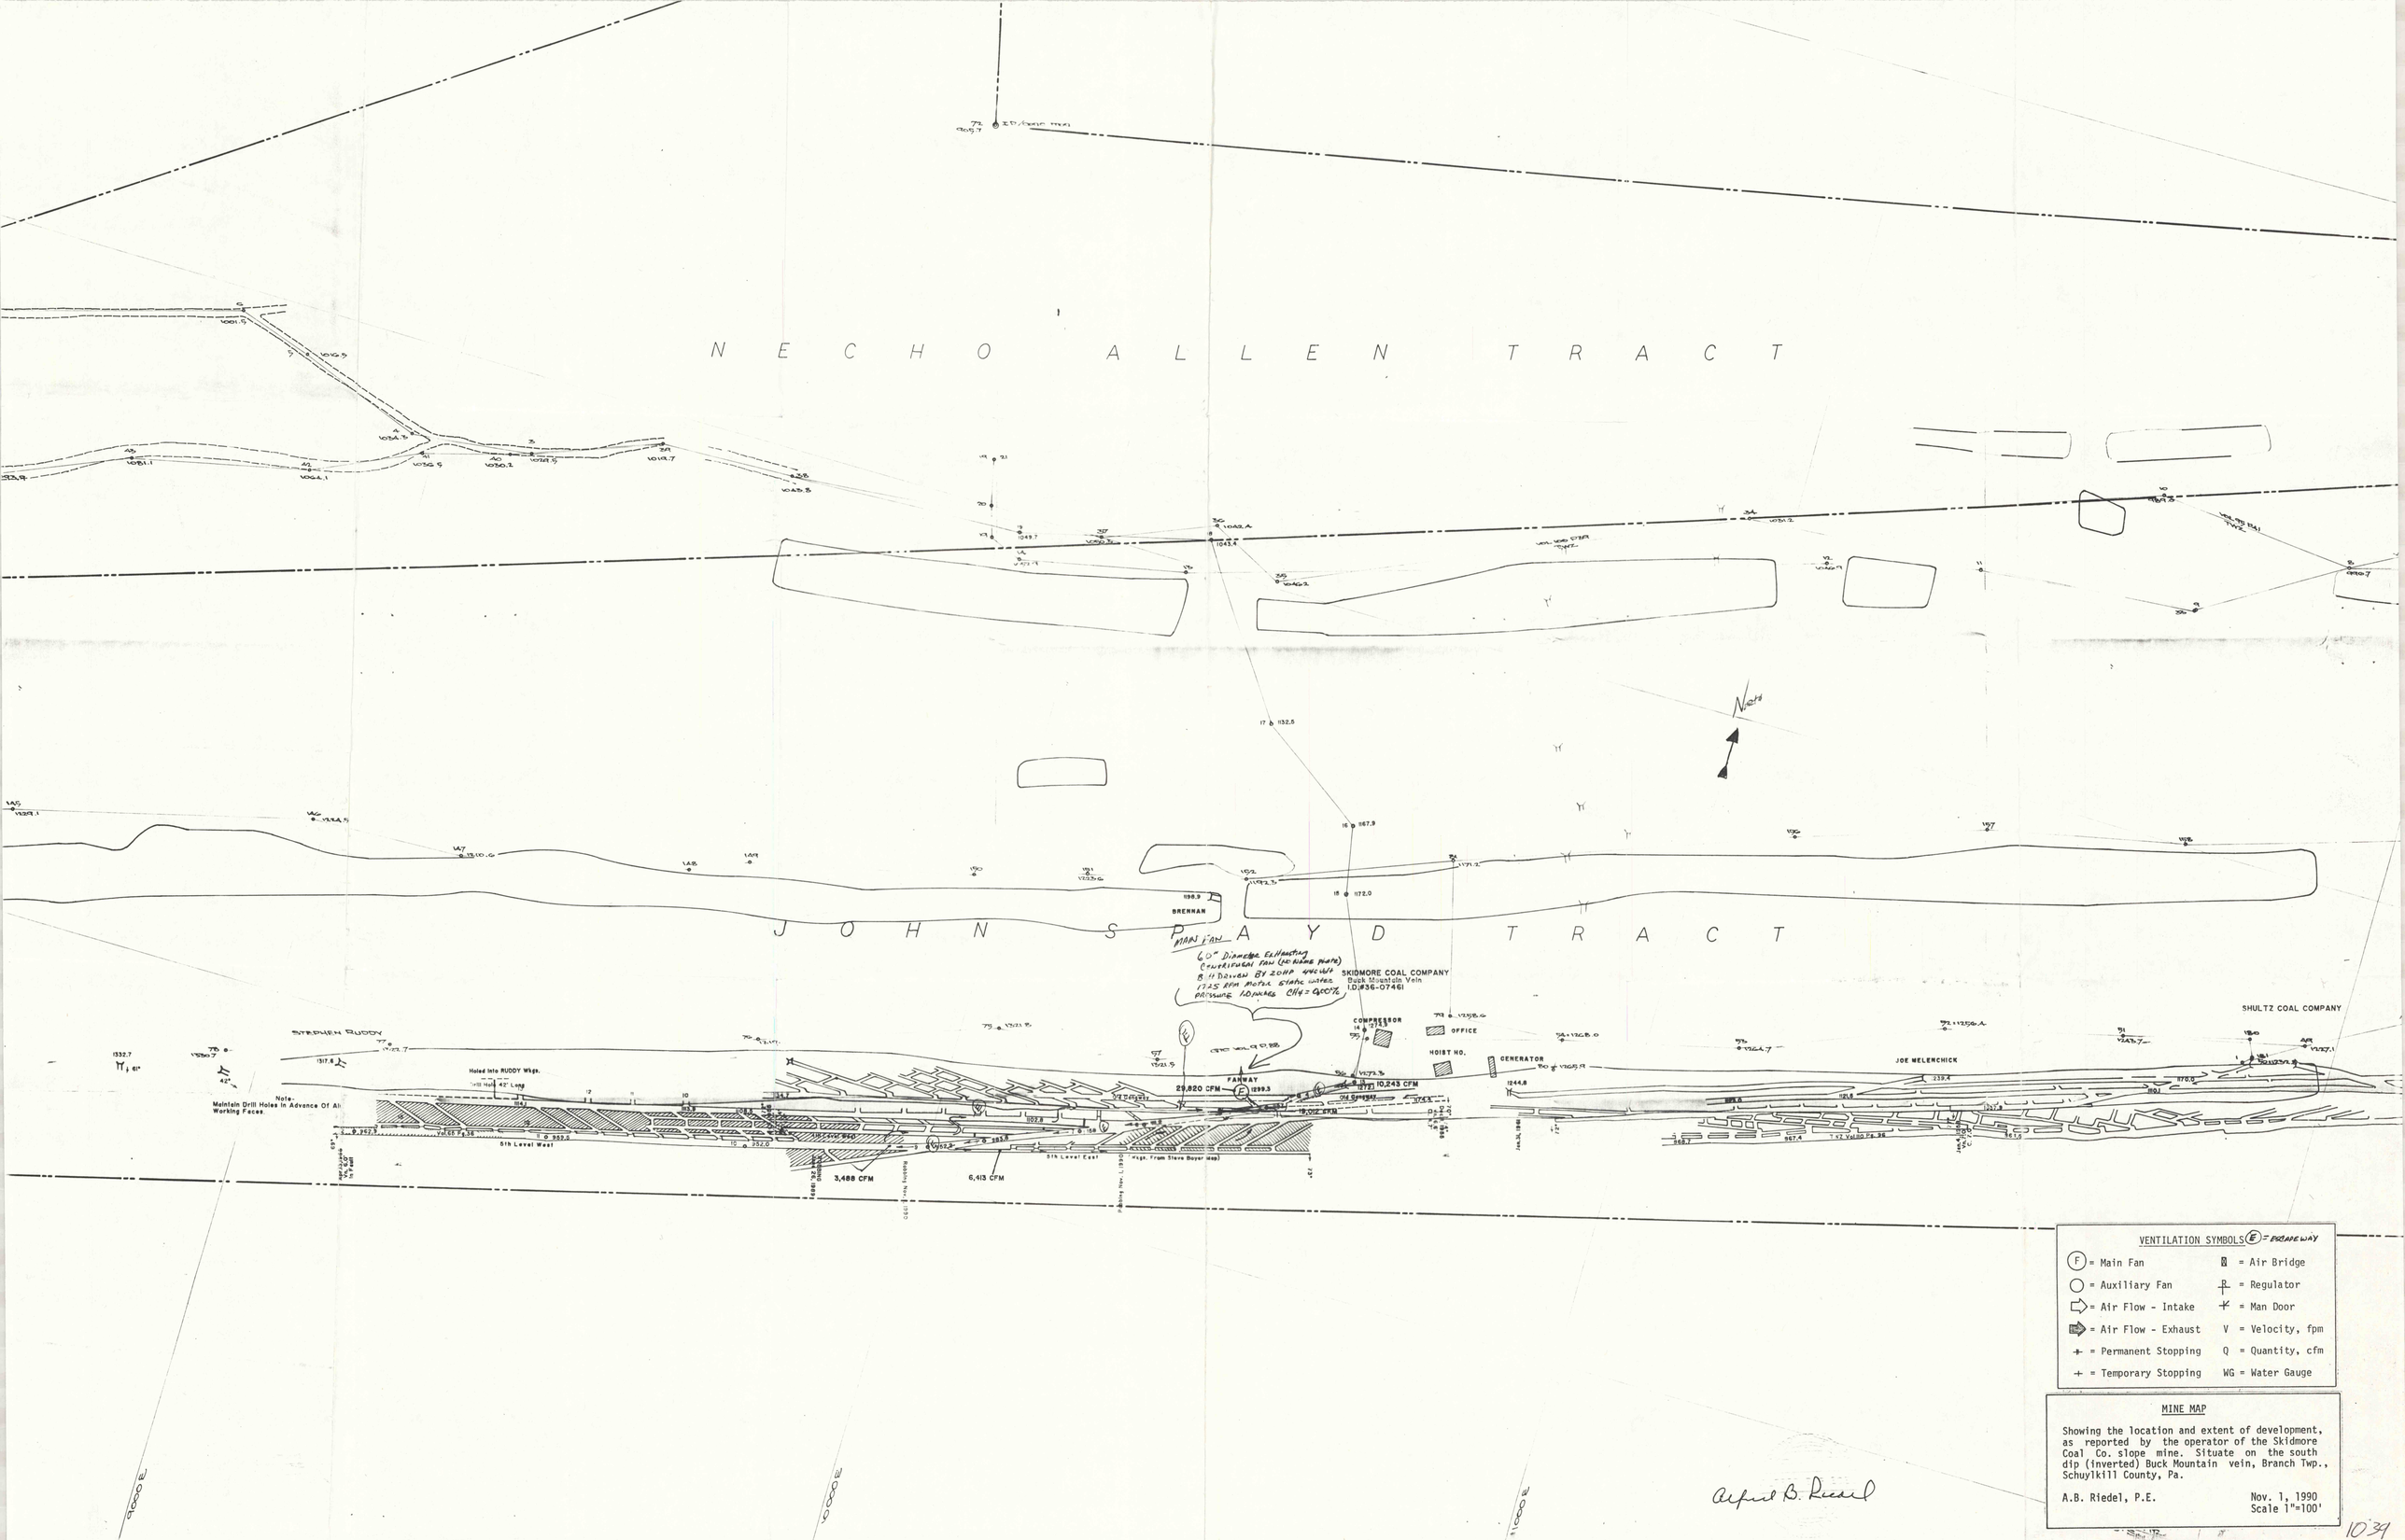

VENTILATION SYMBOLS (E) = FRAPEWAY

(F) = Main Fan	= Air Bridge
(○) = Auxiliary Fan	= Regulator
= Air Flow - Intake	= Man Door
= Air Flow - Exhaust	V = Velocity, fpm
+ = Permanent Stopping	Q = Quantity, cfm
+ = Temporary Stopping	WG = Water Gauge

MINE MAP

Showing the location and extent of development, as reported by the operator of the Skidmore Coal Co. slope mine. Situate on the south dip (inverted) Buck Mountain vein, Branch Twp., Schuylkill County, Pa.

A.B. Riedel, P.E.

Nov. 1, 1990
Scale 1"=100'

1034