

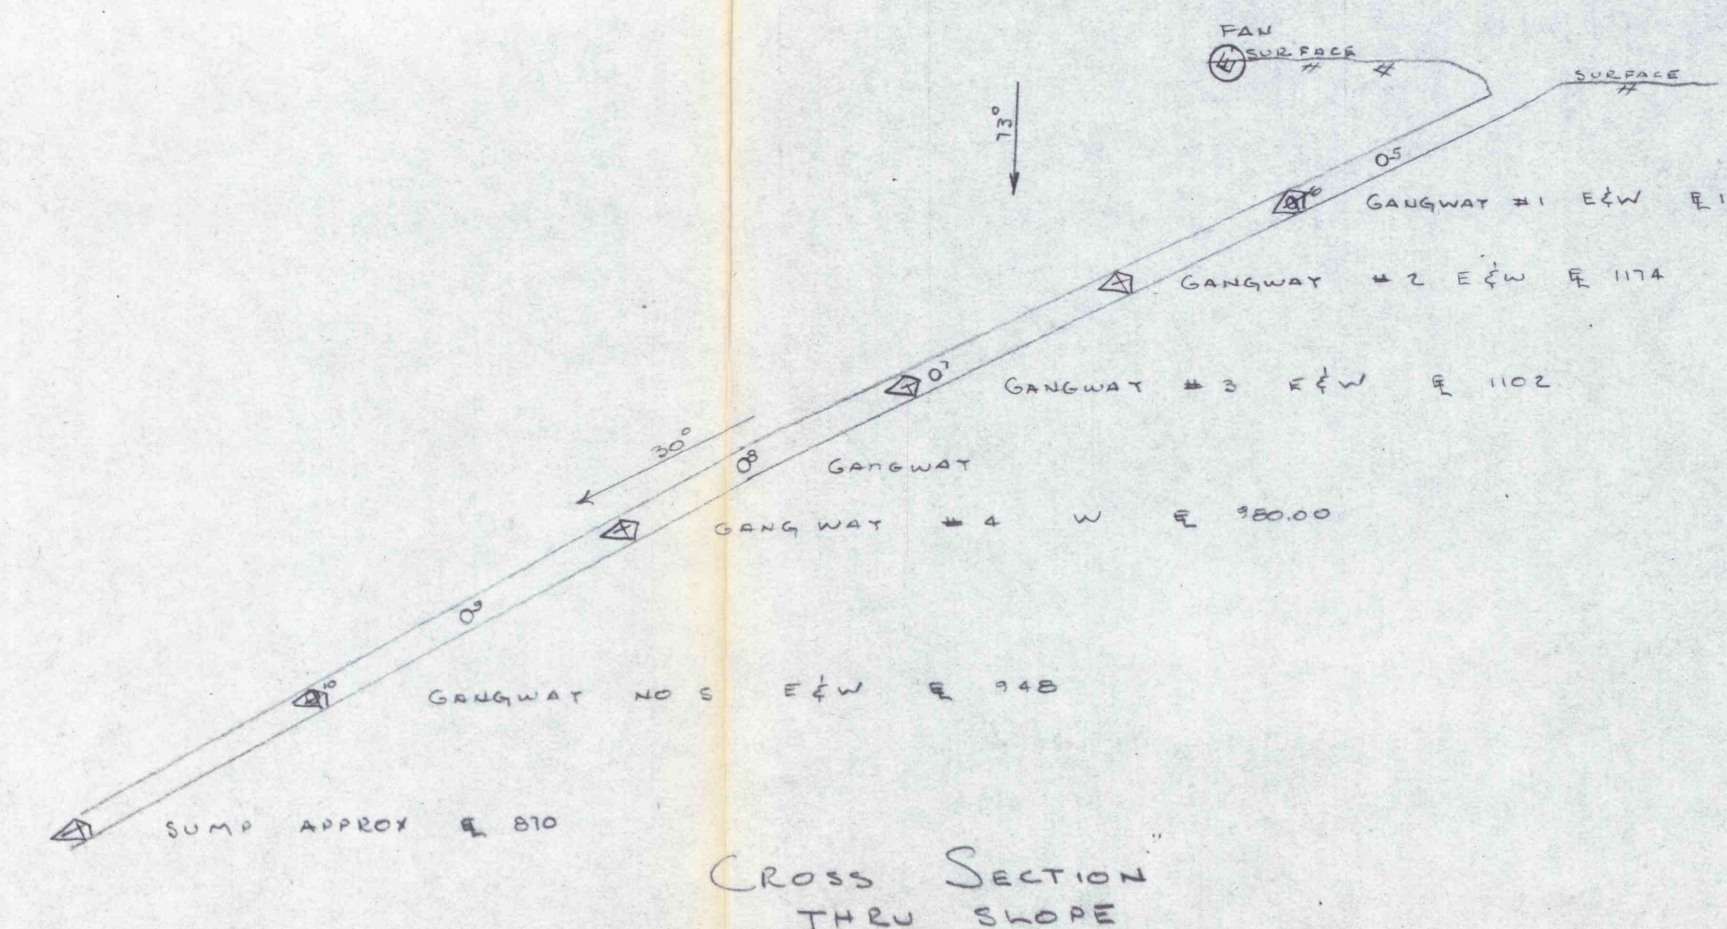


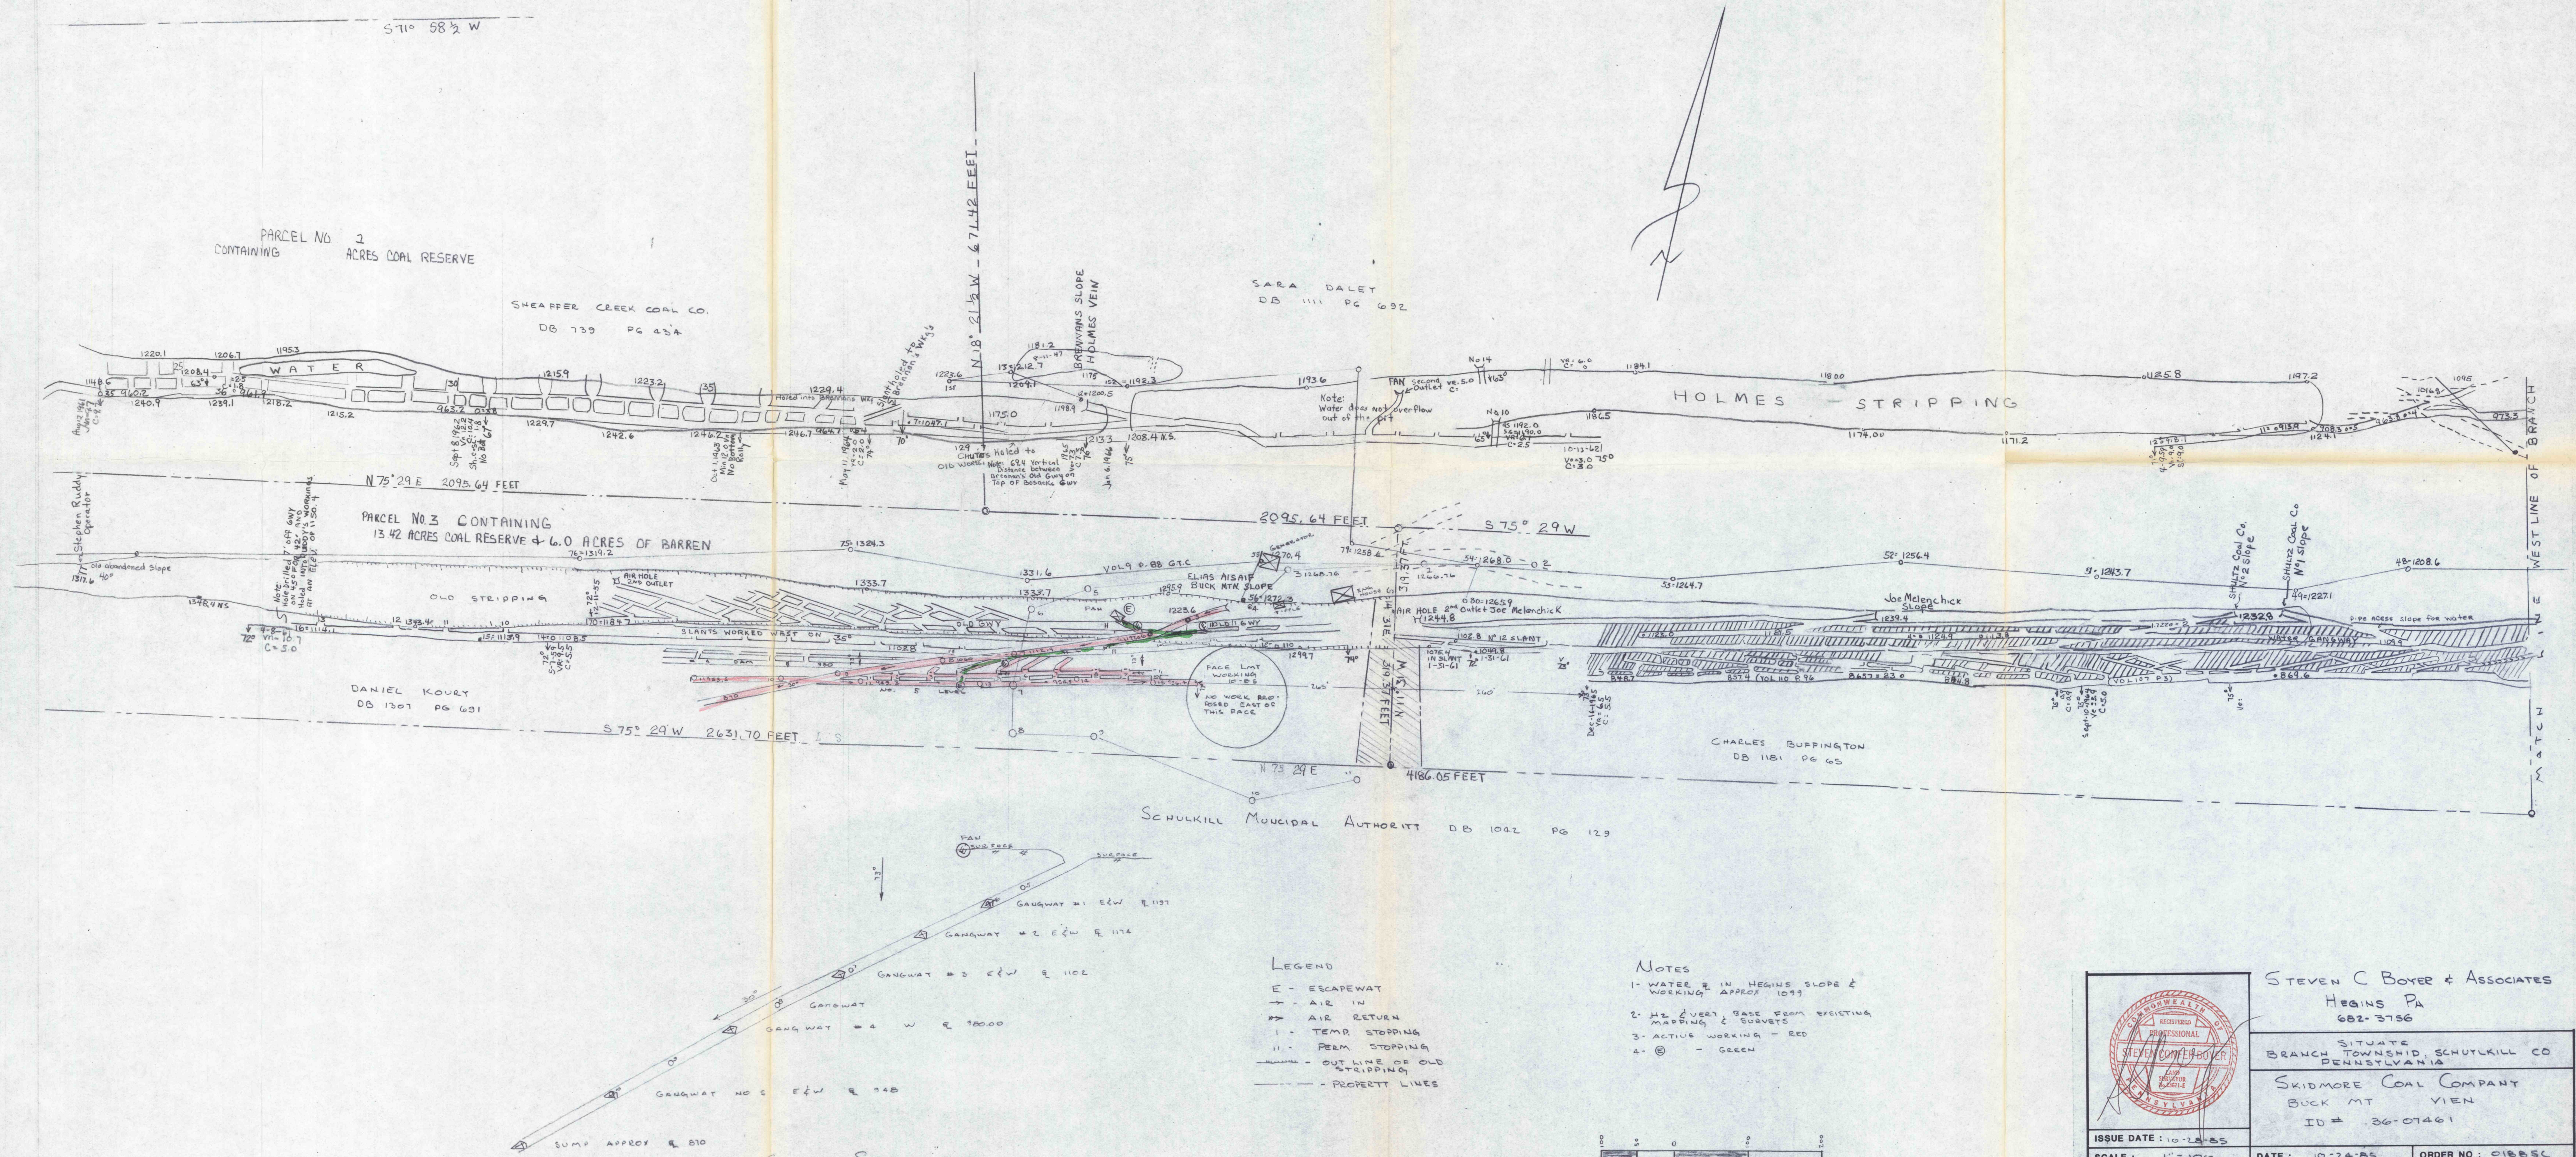

- LEGEND
- E - ESCAPEWAY
 - AIR IN
 - AIR RETURN
 - TEMP STOPPING
 - PERM STOPPING
 - OUTLINE OF OLD STRIPPING
 - PROPERTY LINES

- NOTES
1. WATER IN HEGINS SLOPE & WORKING APPROX 1099
 2. H2 & VERT BASE FROM EXISTING MAPPING & SURVEYS
 3. ACTIVE WORKING - RED
 4. - GREEN

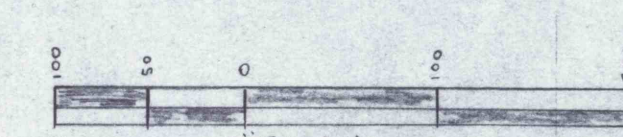

STEVEN C. BOYER
REGISTERED PROFESSIONAL ENGINEER
NO. 10188C
PENNSYLVANIA

STEVEN C BOYER & ASSOCIATES
HEGINS PA
682-3756

SITUATE
BRANCH TOWNSHIP, SCHULKILL CO
PENNSYLVANIA

SKIDMORE COAL COMPANY
BUCK MT VIEN
ID # 36-07461

ISSUE DATE: 10-24-85	DATE: 10-24-85	ORDER NO: 0188SC
SCALE: 1" = 100'	DWG. BY: VW	DWG. NO: 0188SC A
PROJ. MGR:	CHKD. BY: GP	DEPT. HD: