


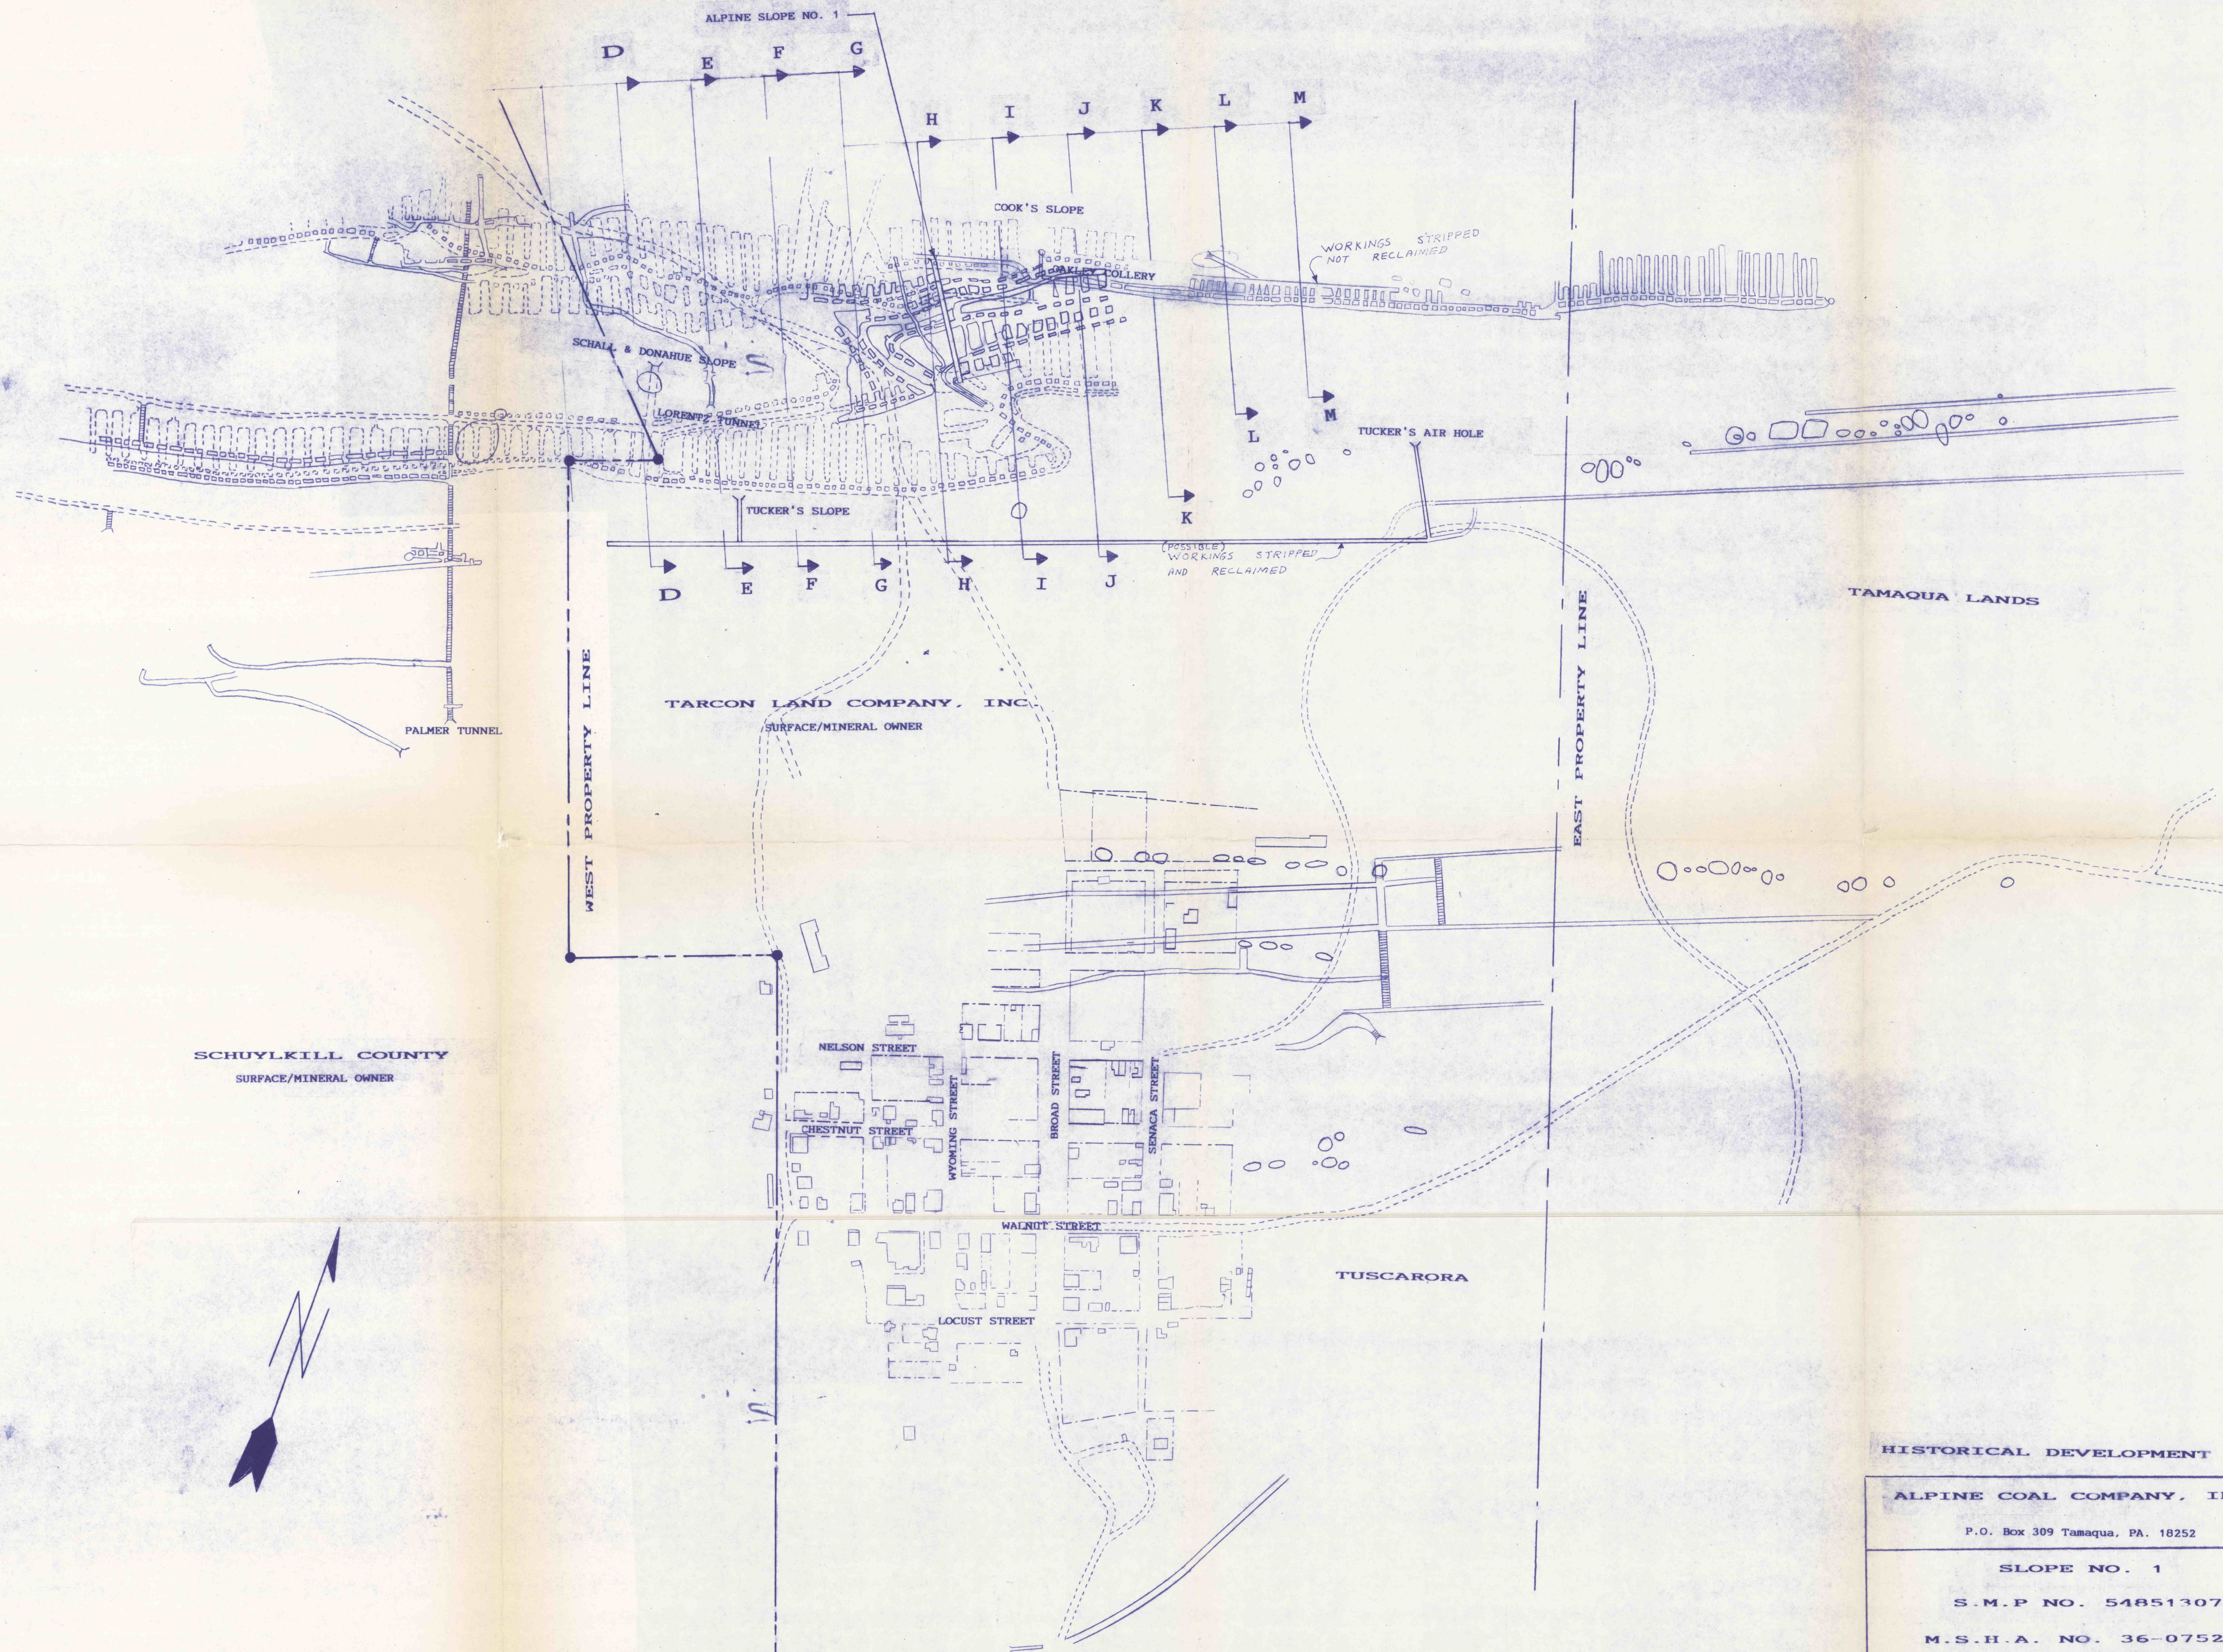

HISTORICAL DEVELOPMENT OF AREA

ALPINE COAL COMPANY, INC.		TOP SPLIT MAMMOTH VEIN
P.O. Box 309 Tamaqua, PA. 18252		SCALE: 1" = 200'
SLOPE NO. 1 S.M.P NO. 54851307 M.S.H.A. NO. 36-07528		
SCHUYLKILL TOWNSHIP	SCHUYLKILL COUNTY	Elwood F. WIRTH LAND SURVEYOR No. 149-A SCHUYLKILL COUNTY PENNSYLVANIA