
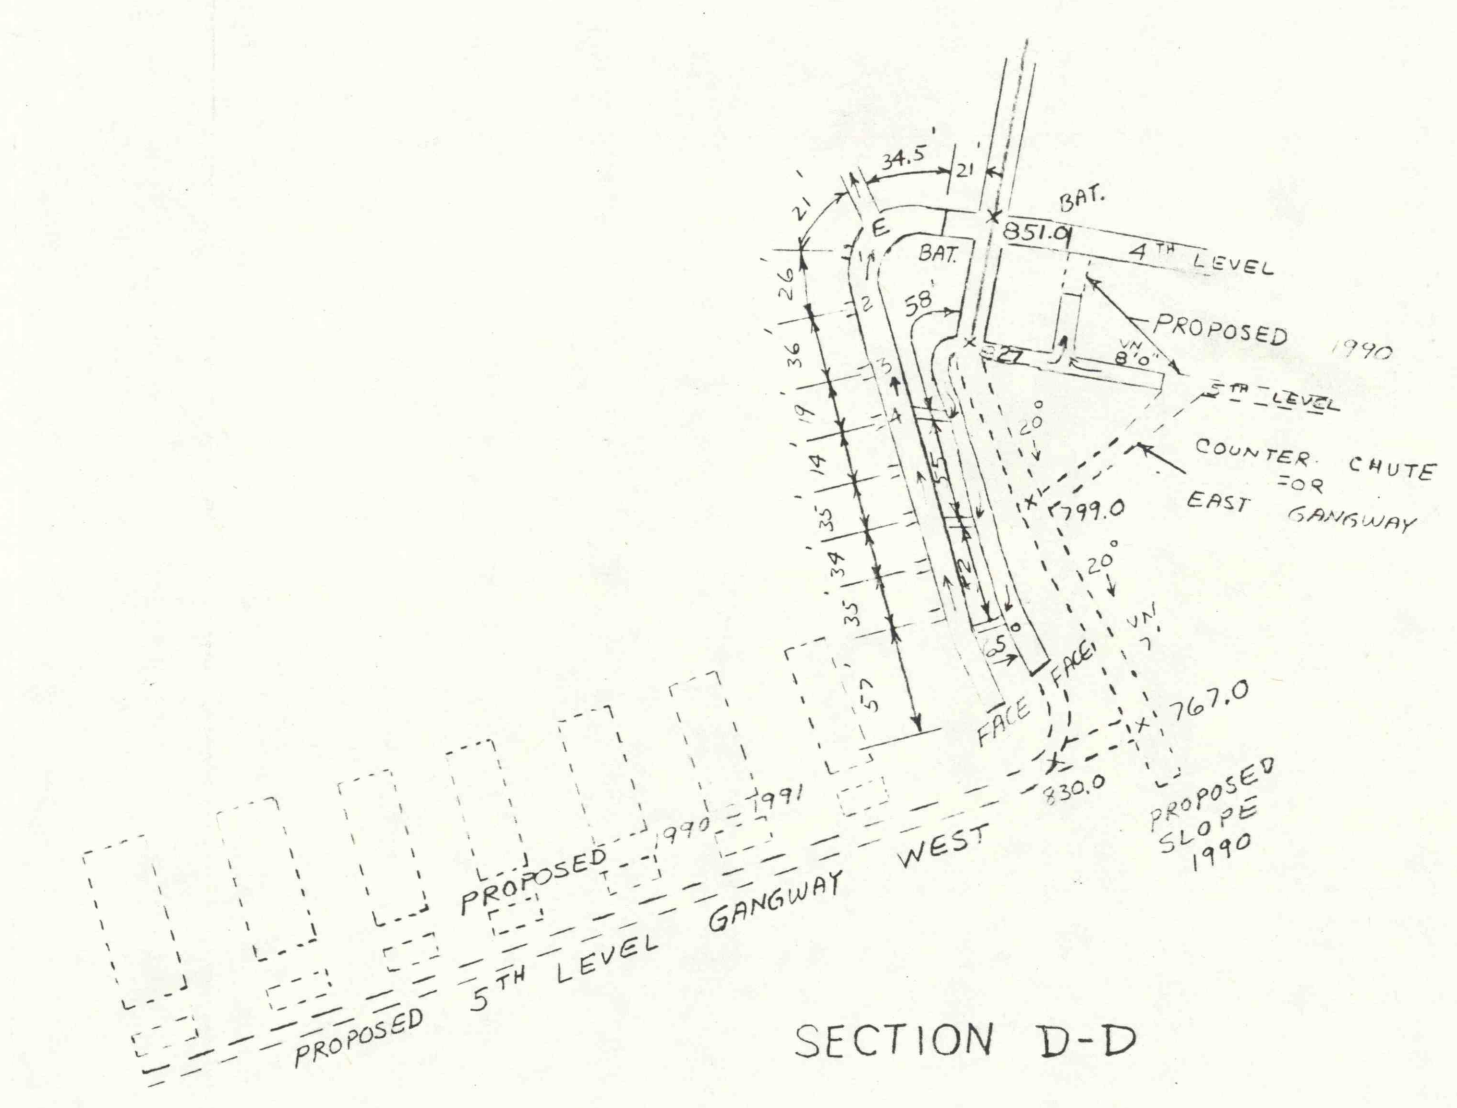
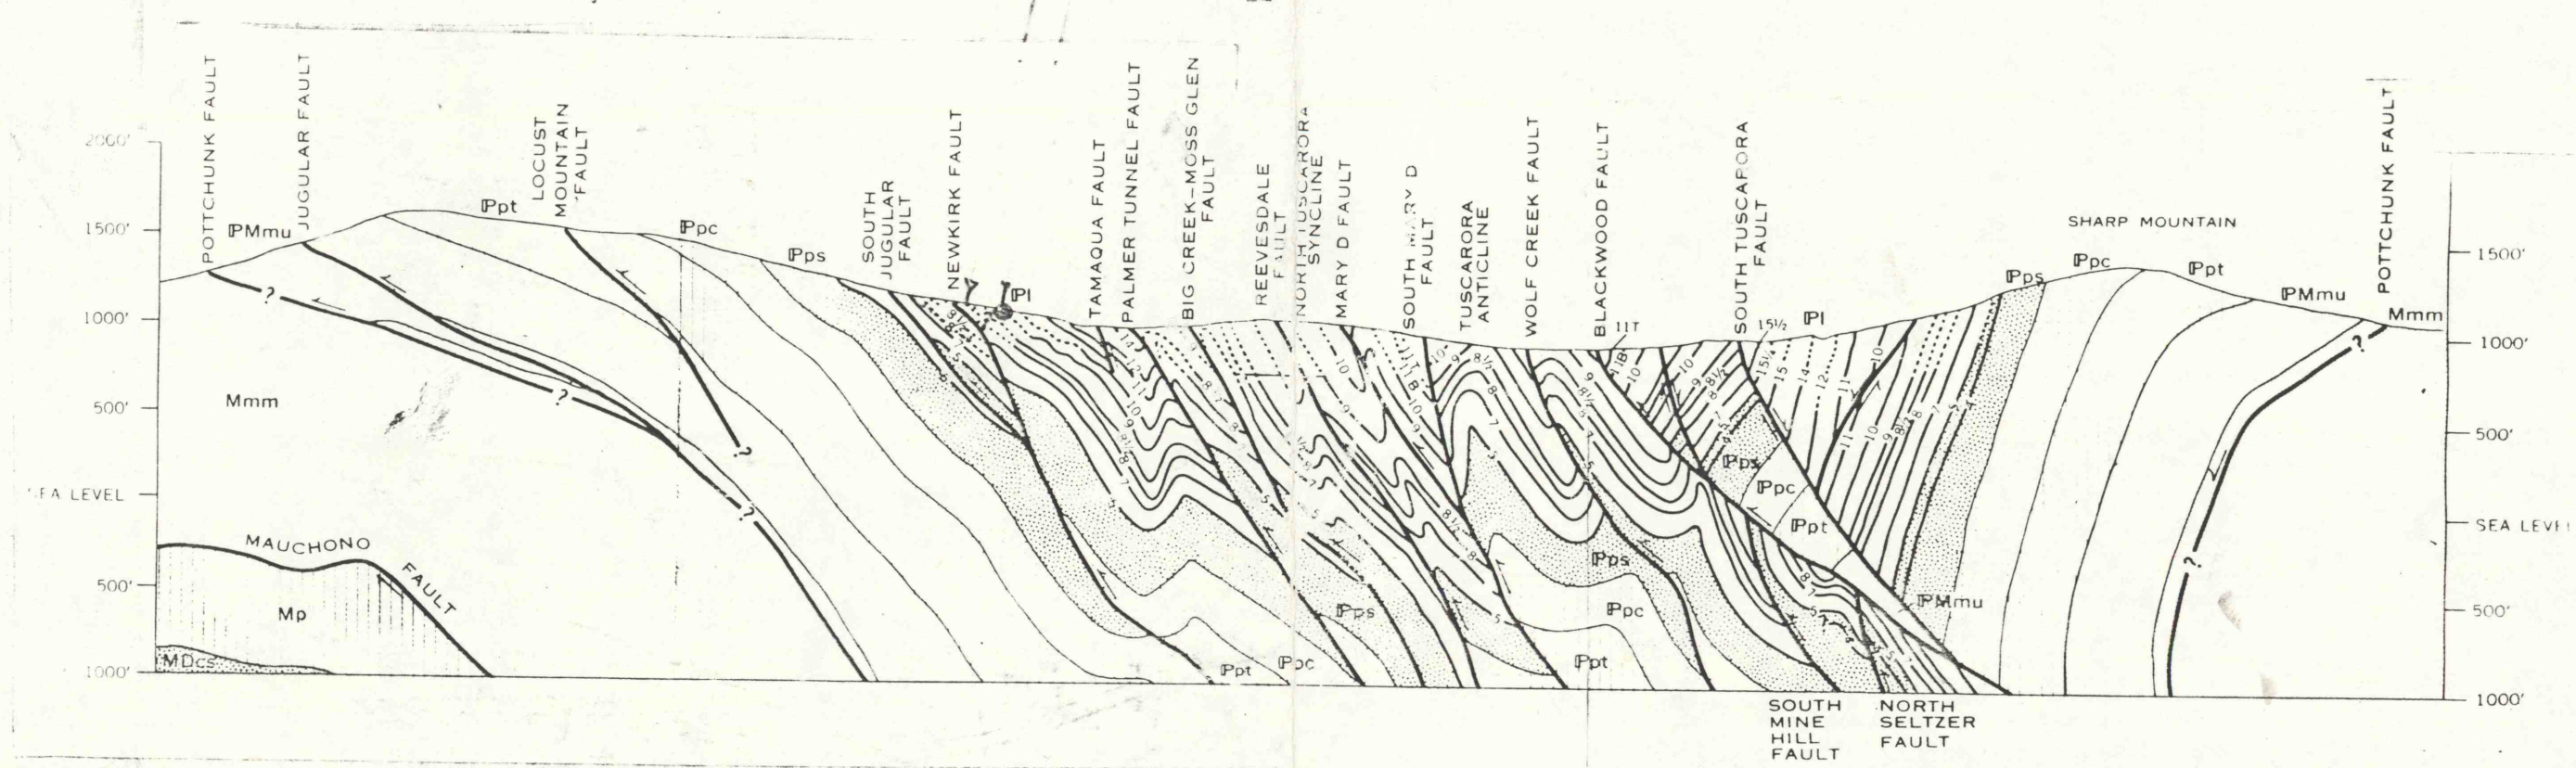
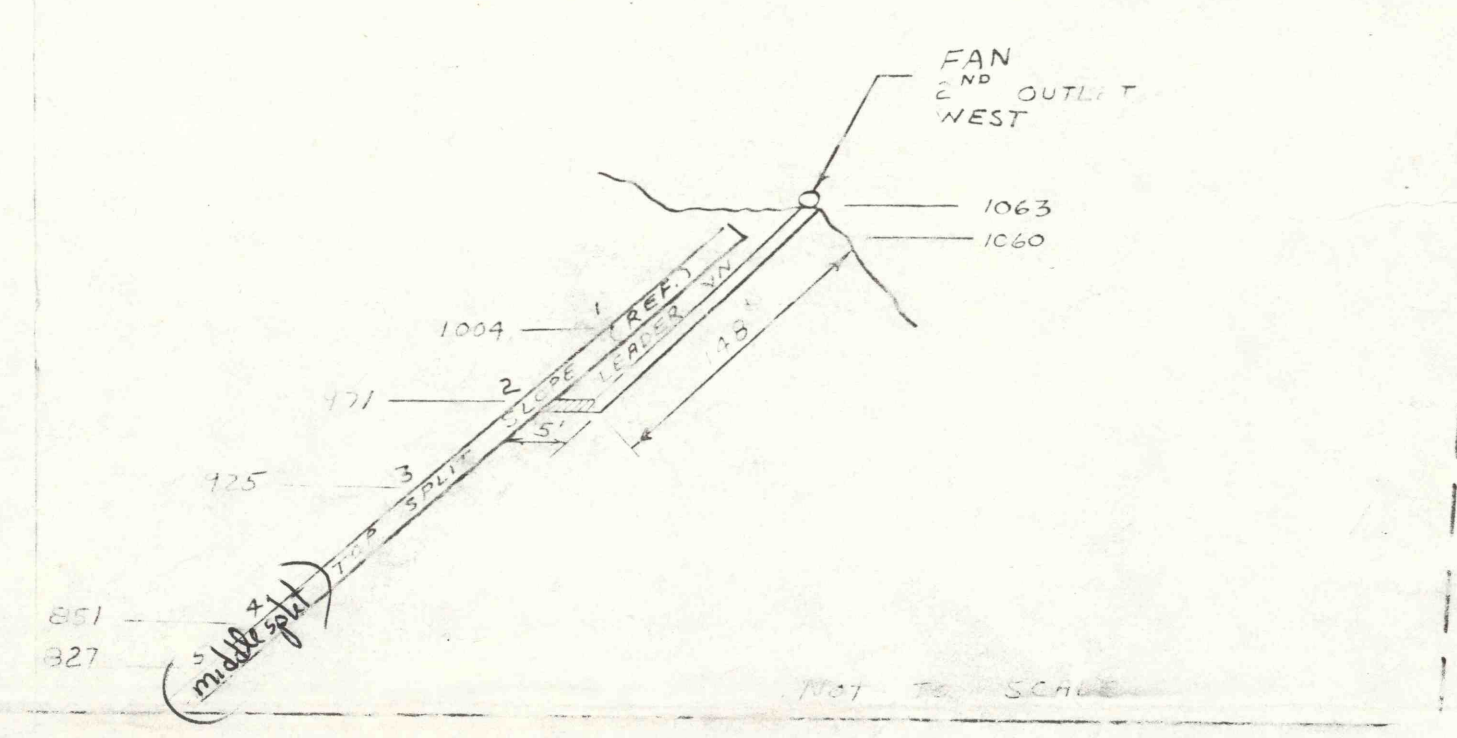
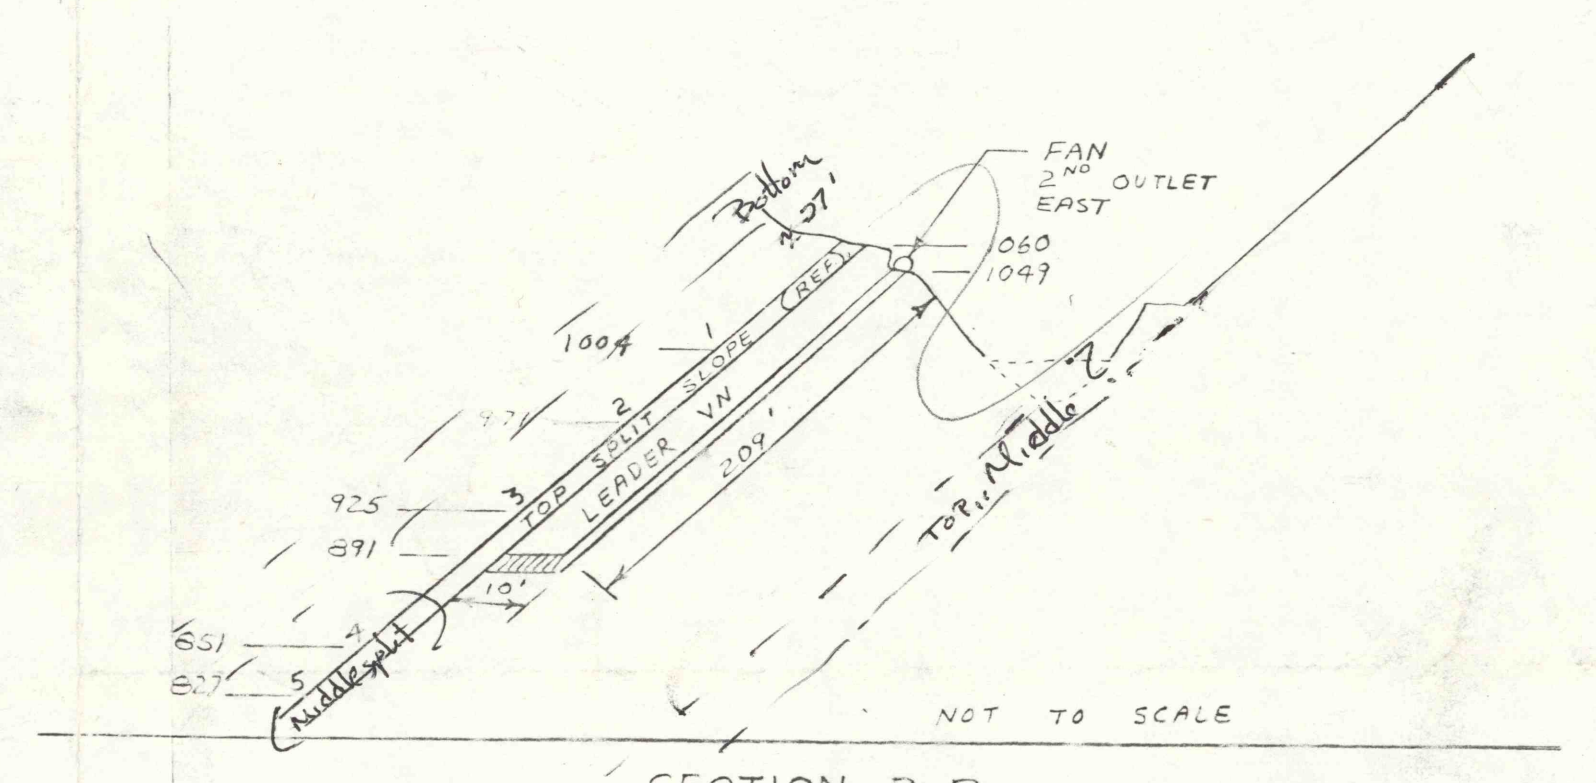
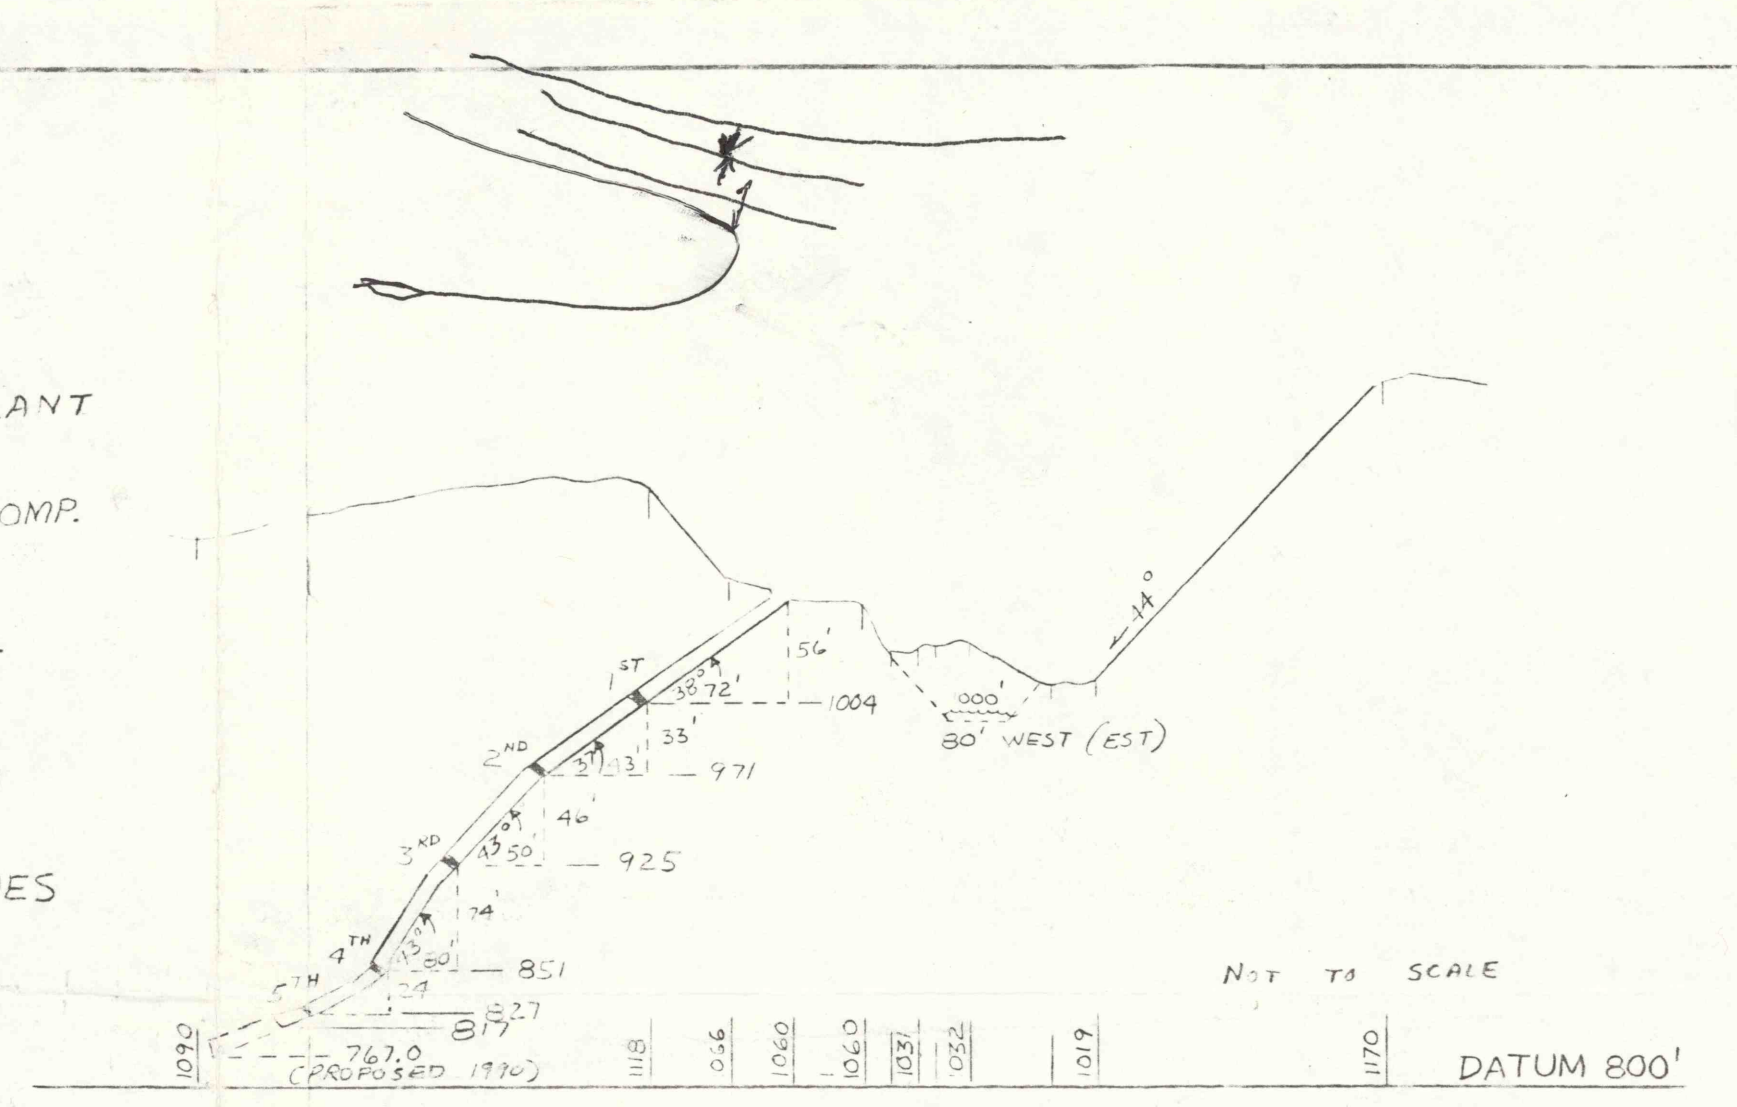


1. 201 ▲ OVERFLOW MONITORING POINT FOR PREPARATION PLANT
2. 002 ▲ MINE DISCHARGE MONITORING
3. E ESCAPWAYS
4. → AIR FLOW DIRECTION
5. INACCESSIBLE AREAS
6. PERMIT AREA = 4.6 ACRES

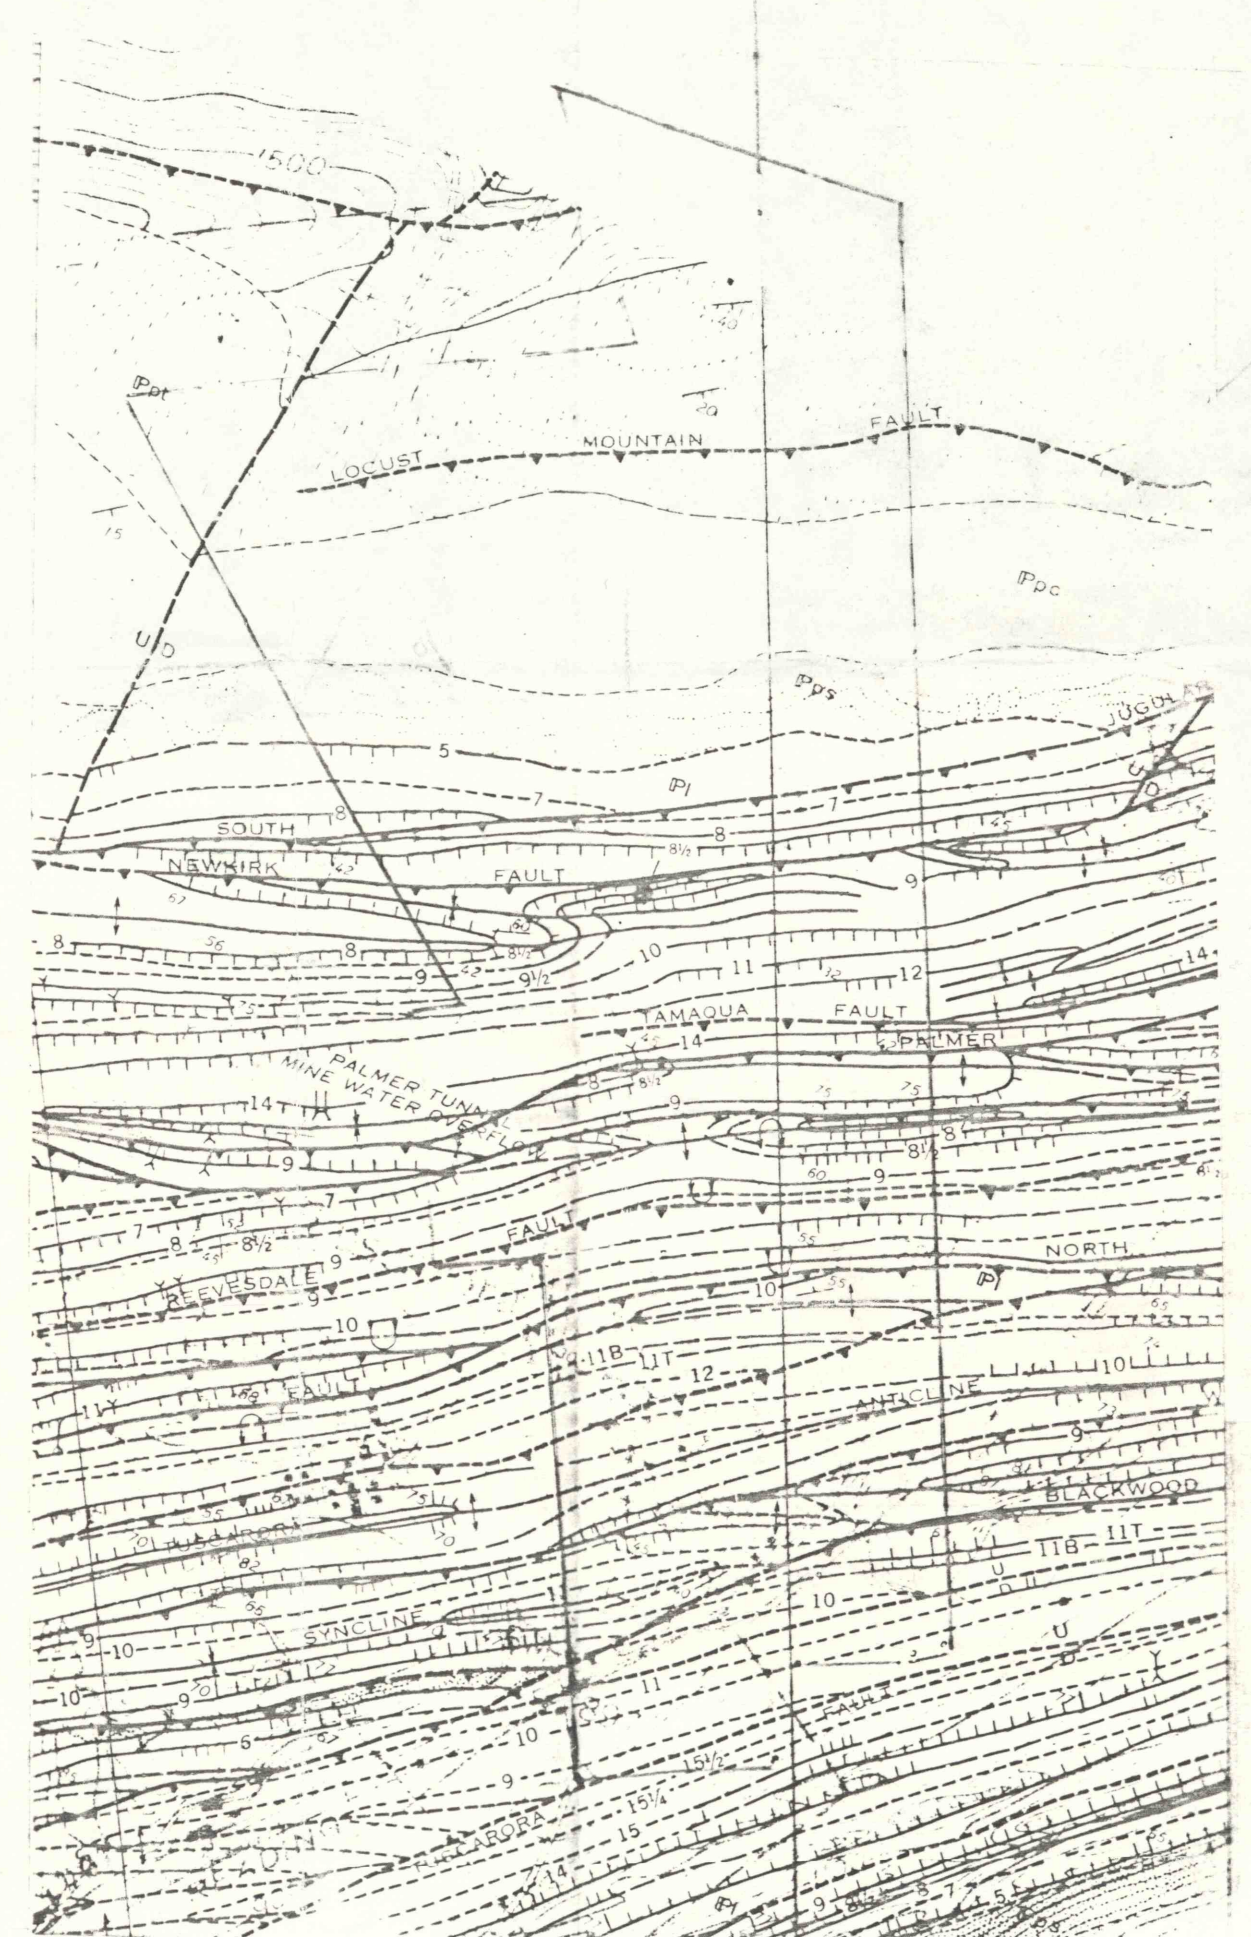

5/29/90 POSSED: PROP. BOUNDRIES, WEST WORKINGS, 9 TH & 5 TH LEVELS REVISIONS: 2/5/84, 12/20/85, 12/27/86, 9/87, 1/88	
TOP SPLIT WORKINGS IN THE TUSCARORA MAMMOTH BASIN STRIPPING SOUTH DIP	FORMERLY: RENEGADE COAL CO.
ALPINE COAL COMPANY, INC. P.O. Box 309 Tamaqua, PA 18252 SLOPE NO. 1 S.M.P. NO. 54851307 MSHA I.D. NO. 36-07528	DATE: MAY 1990 SCALE: 1" = 100' DRAWN BY: [Signature] 
SCHUYLKILL TOWNSHIP	SCHUYLKILL COUNTY