


TAMAQUA LANDS
 No 24 CROSS-SECTION AT TIOGA SLOPE
 SCALE 1"=100' - POTTSVILLE, PA JAN 6, 1922
 G.A. ROOS, D.E.
 Looking East.

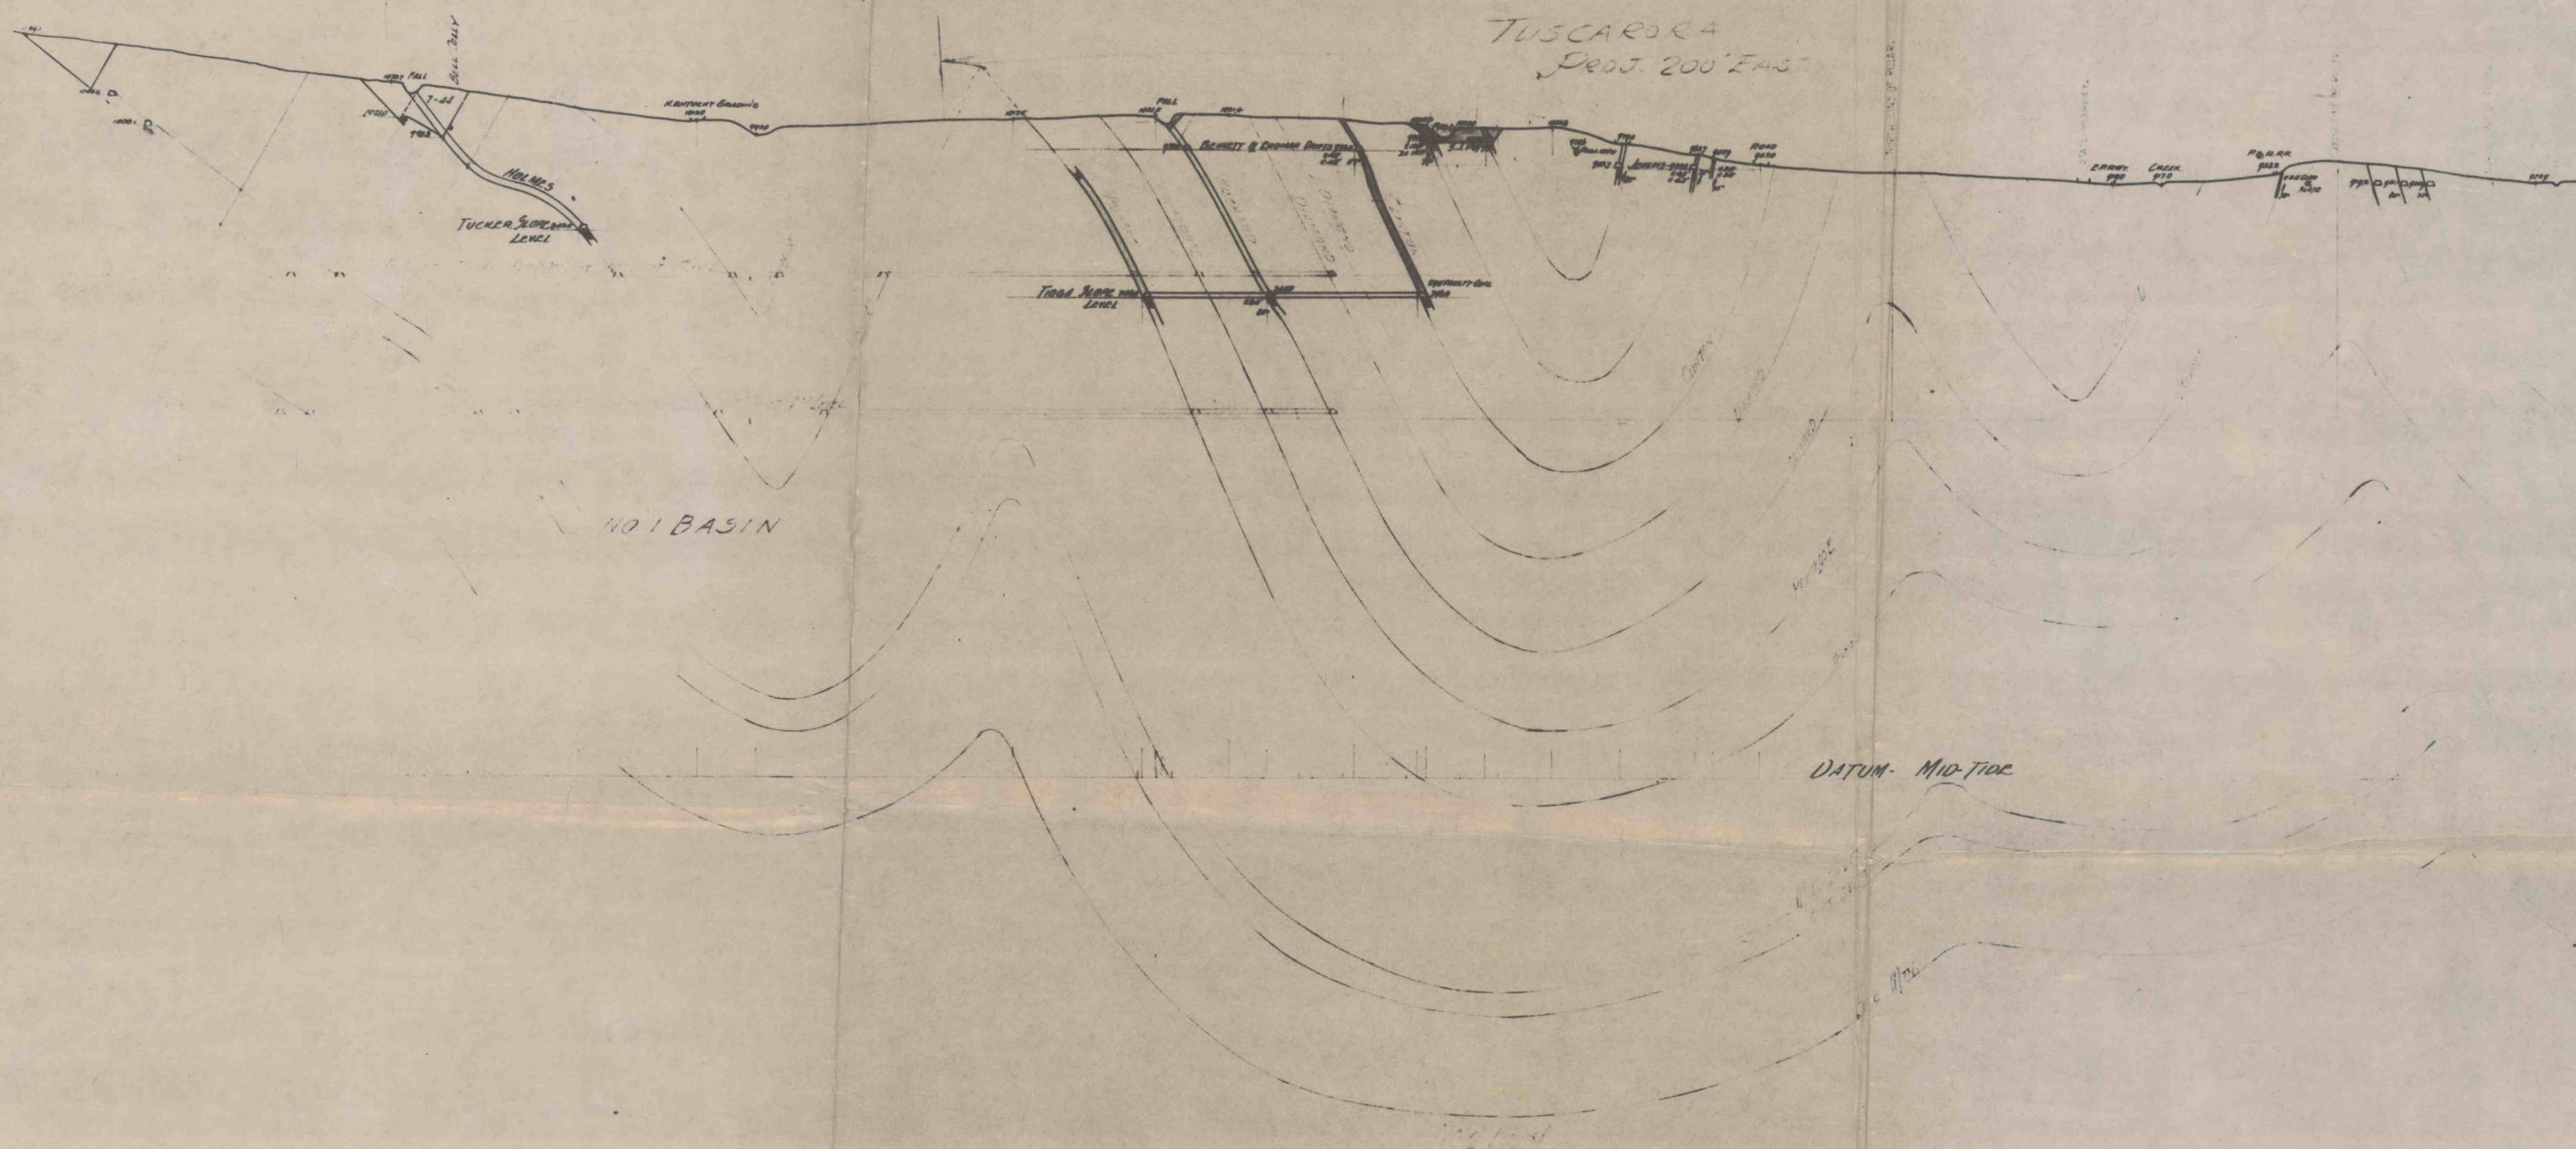

|S|043-|045|-|-|30|

