




ID-36-07528 NO. 1 SLOPE

10-21-86	PERMIT BOUNDARY, REFUSE DISPOSAL, PARKING & STORAGE AREA ADDED
	7-86 LIME TREATMENT ADDED
REVISIONS - 12/5/84 - 12-26-85 - 12-22-86	
RENEGADE COAL COMPANY	
FORMERLY WHIPPOORWILL COAL CO. WORKINGS	
TOP SPLIT WORKINGS IN THE TUSCARORA MAMMOTH BASIN	
STRIPPING SOUTH DIP	
SCHUYLKILL TOWNSHIP, SCHUYLKILL CO.	
JOB NO: 8422	DATE: AUGUST 1984
SCALE: 1" = 100'	DRAWN: CFW
APPROVED:	
DRAWING NO: 10-M	

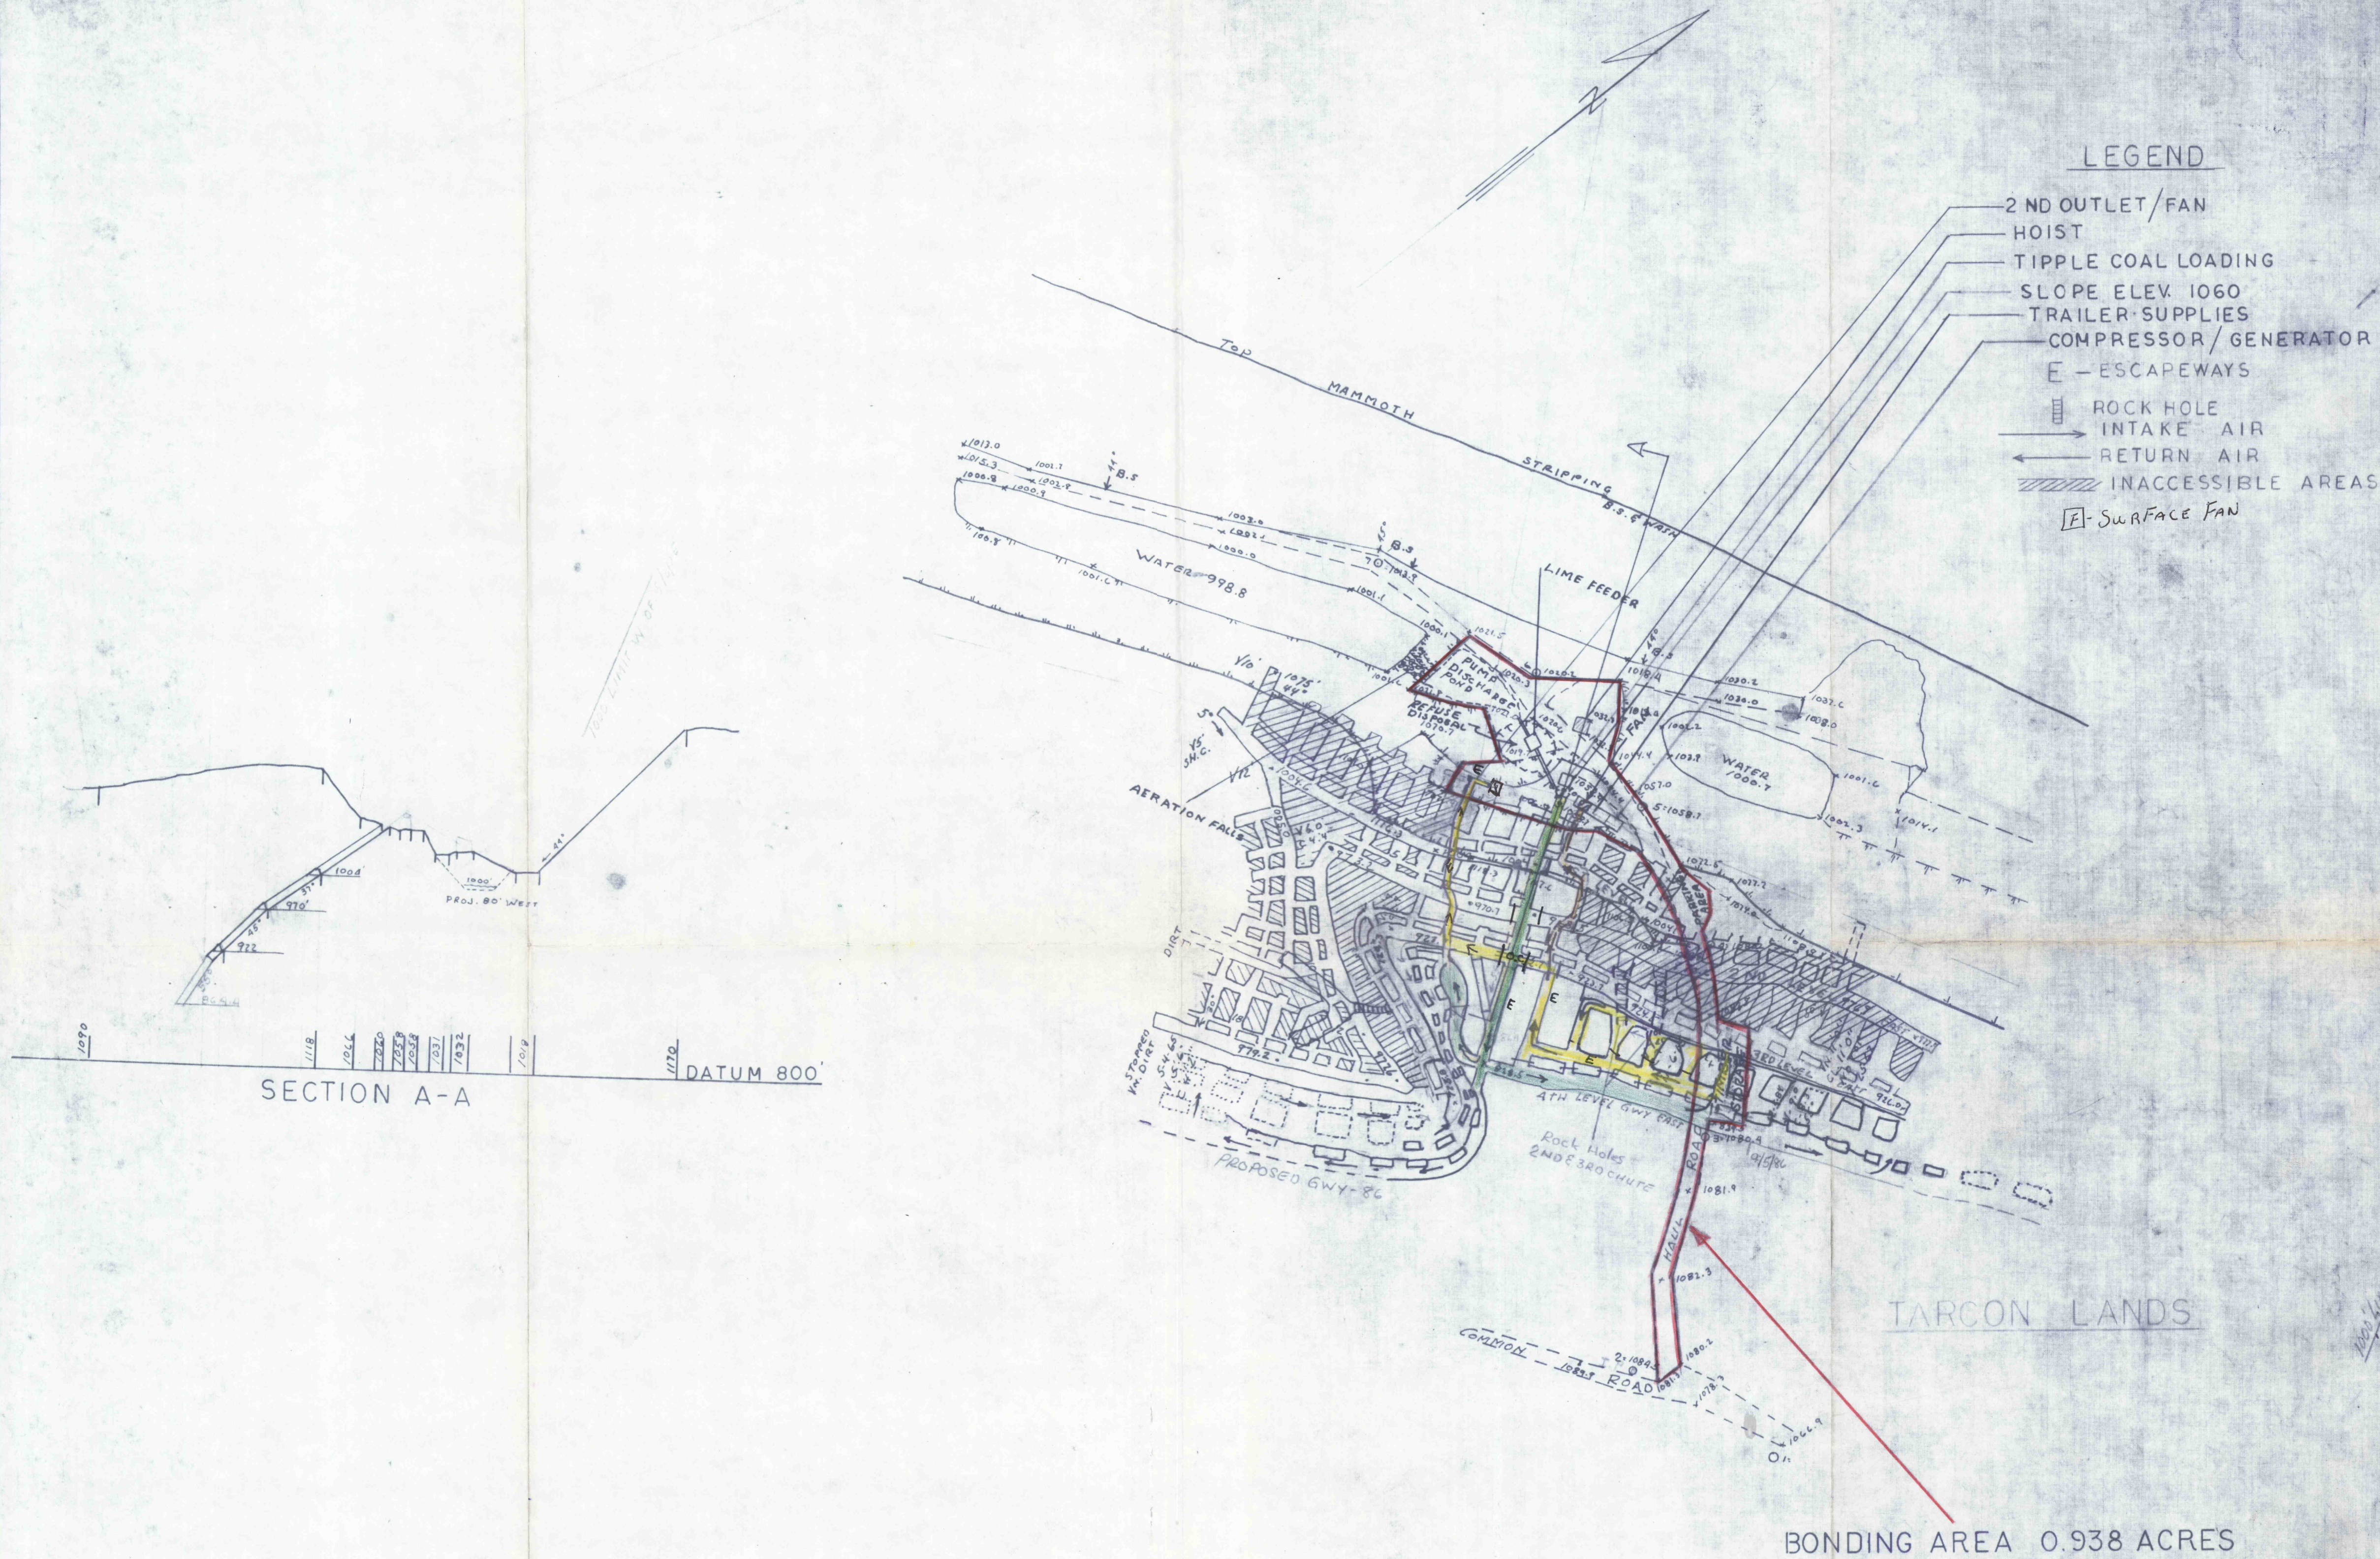