
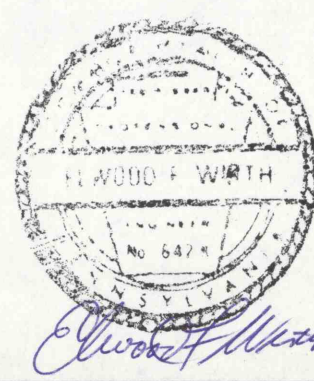


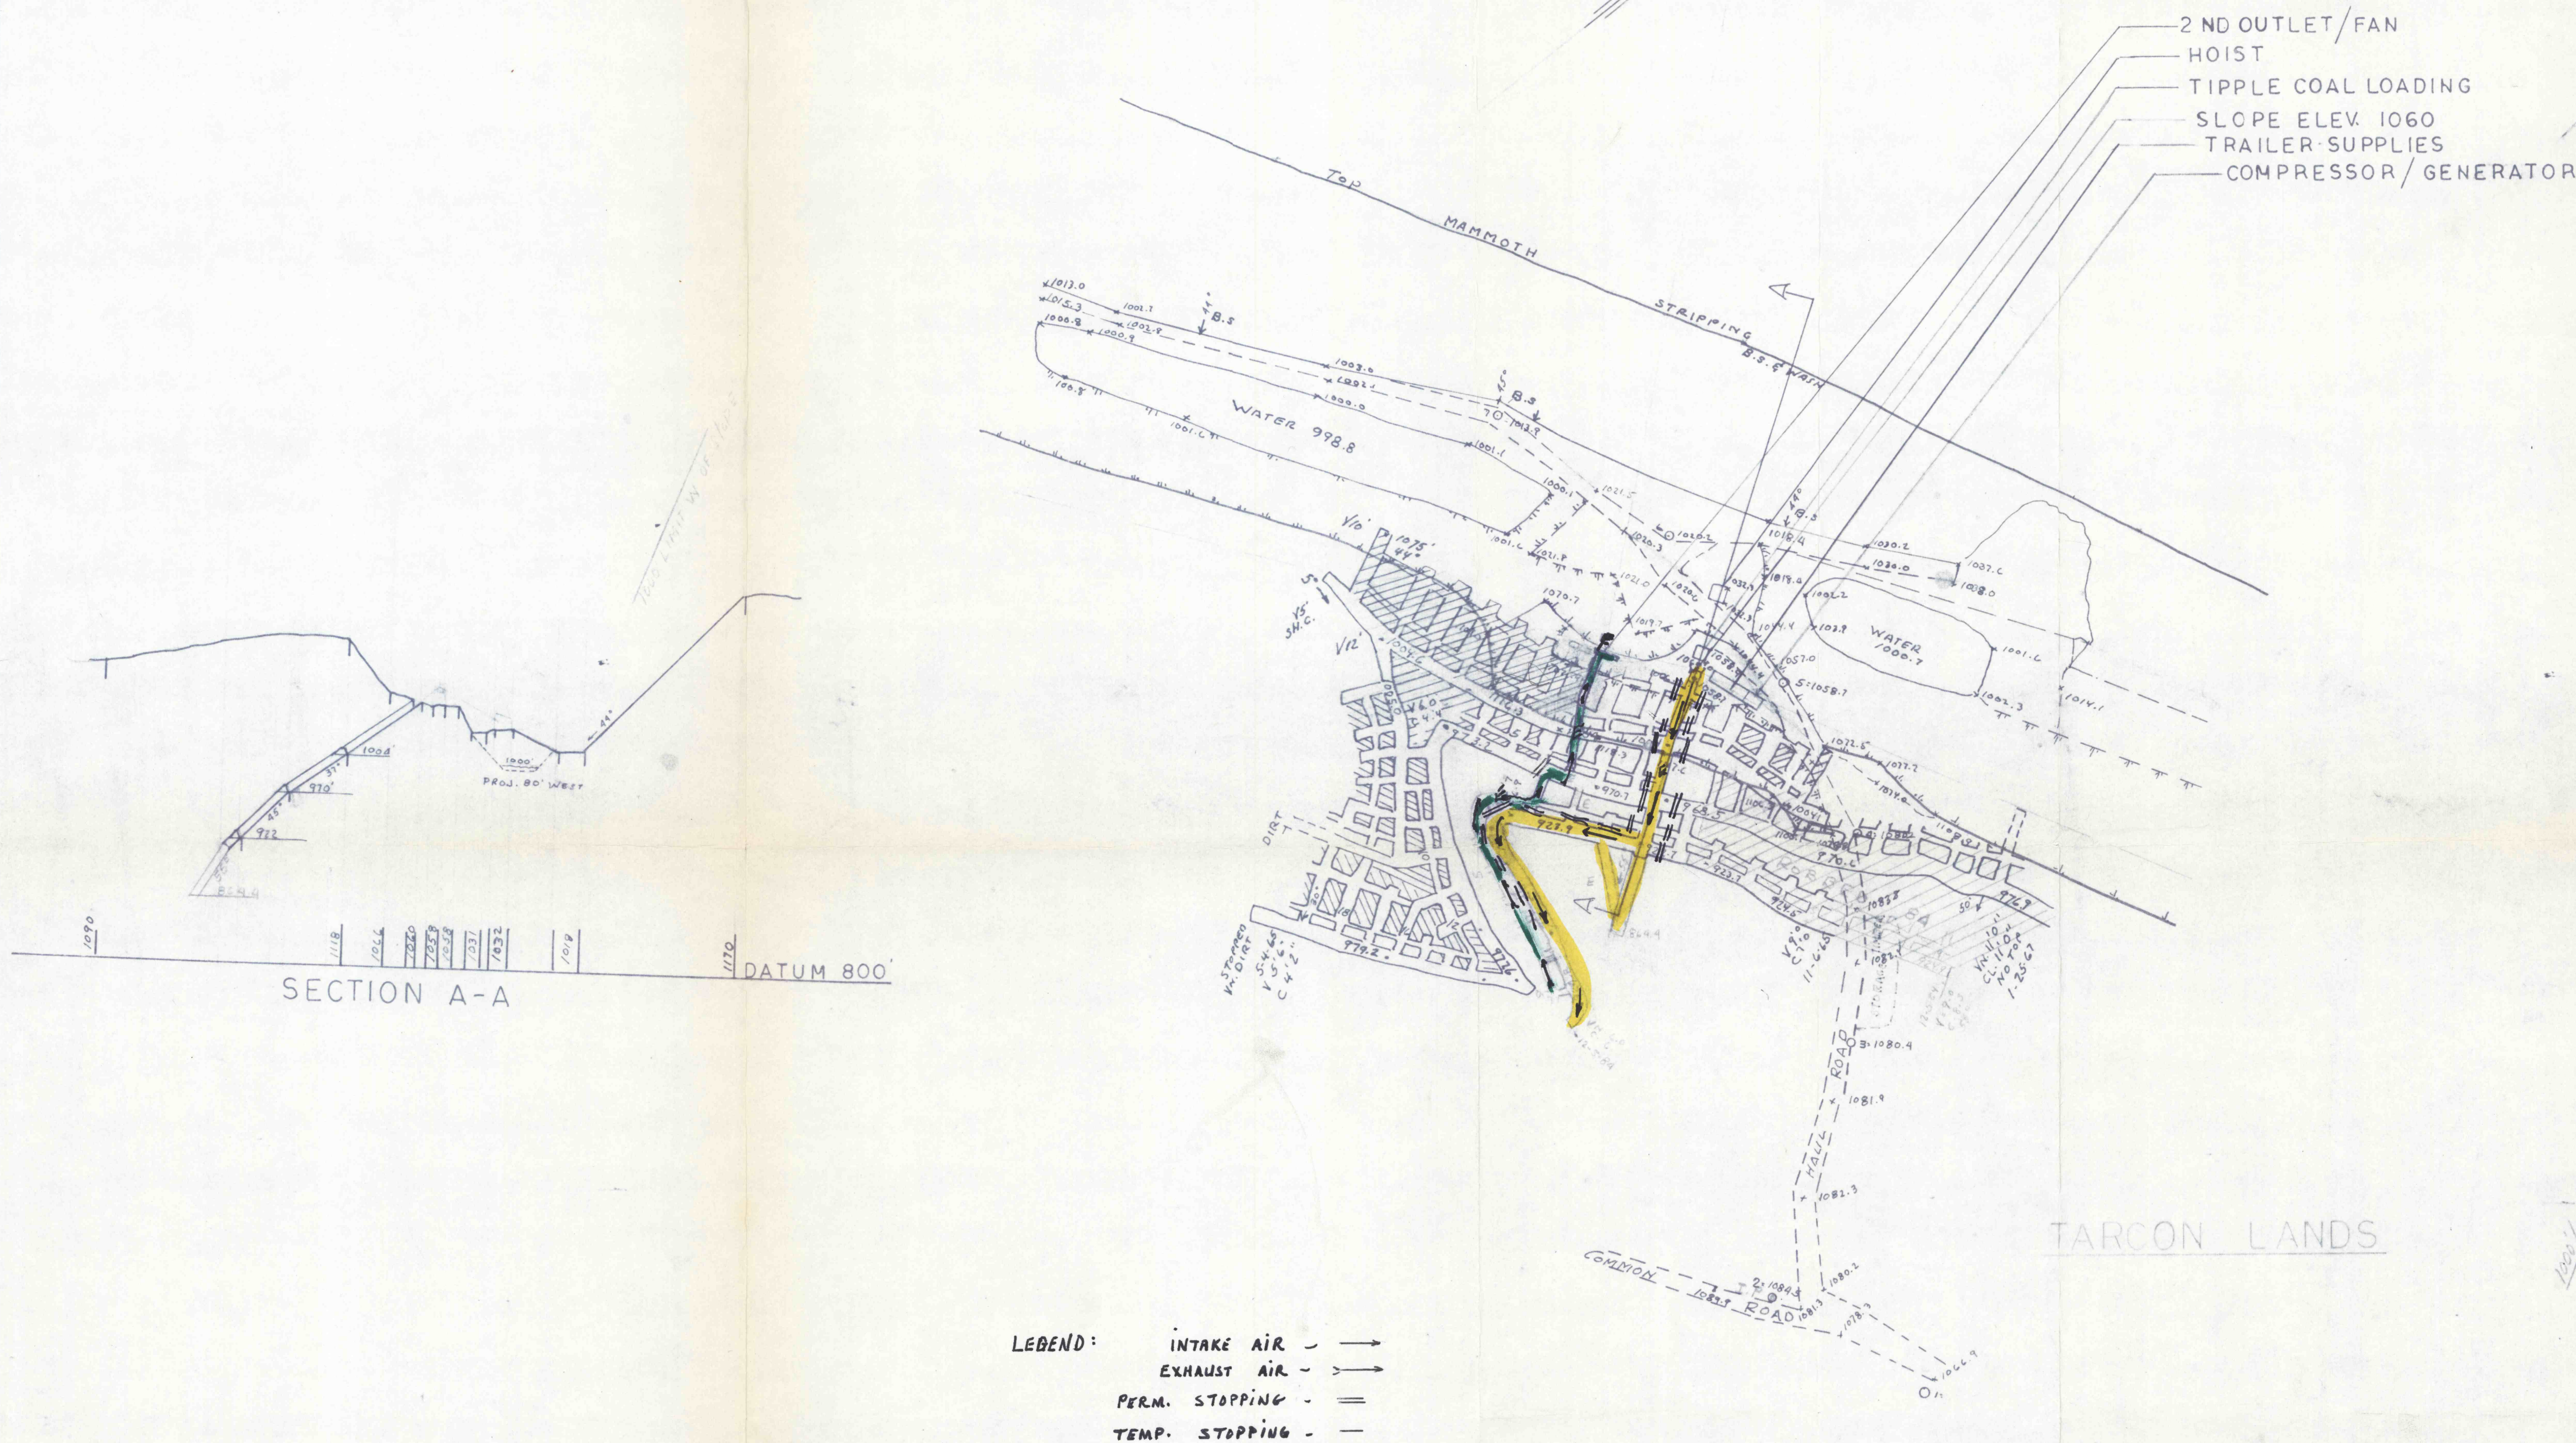

REVISIONS - 12/5/84 -	
RENEGADE COAL COMPANY	FORMERLY WHIPPOORWILL COAL CO. WORKINGS
TOP SPLIT WORKINGS IN THE TUSCARORA MAMMOTH BASIN STRIPPING SOUTH DIP SCHUYLKILL TOWNSHIP, SCHUYLKILL CO.	JOB NO: 8422 DATE: AUGUST 1984 SCALE: 1" = 100' DRAWN: EFW APPROVED:
PE PENNEAST CORPORATION CONSULTING ENGINEERS 541 WEST BACON STREET - PAO ALTO POTTSVILLE PENNSYLVANIA	DRAWING NO: 10-M