

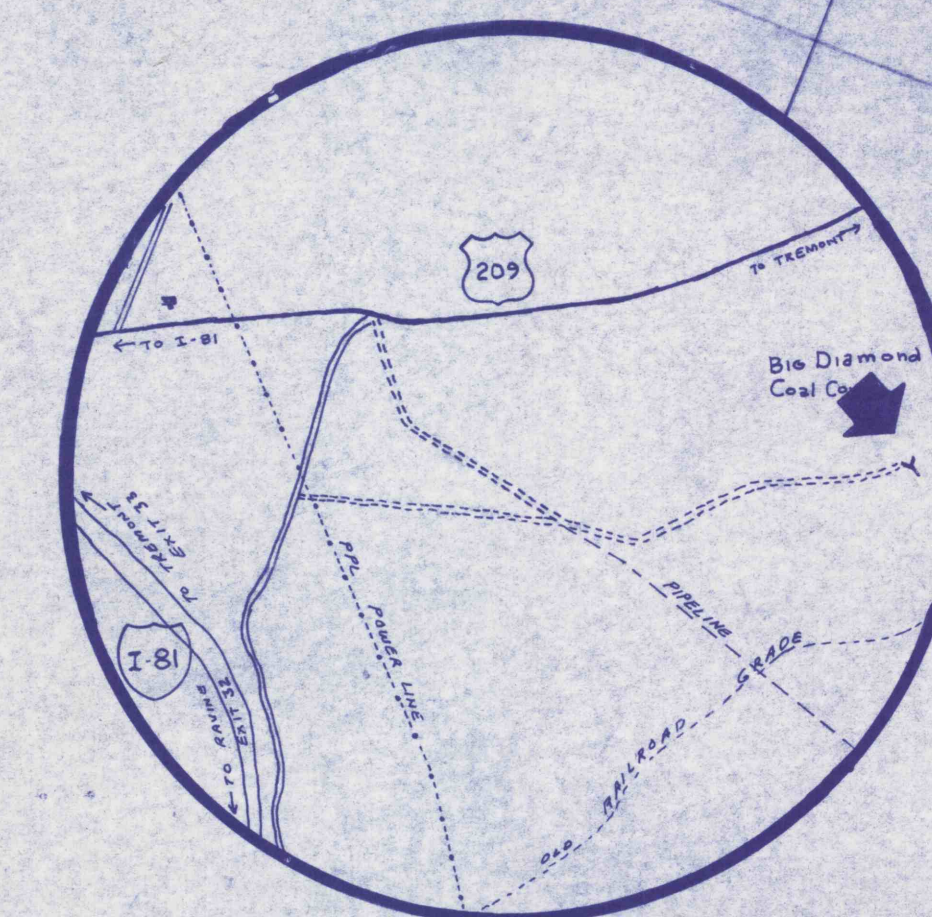


ANDREW CARSON TRACT

PETER ECKERT TRACT

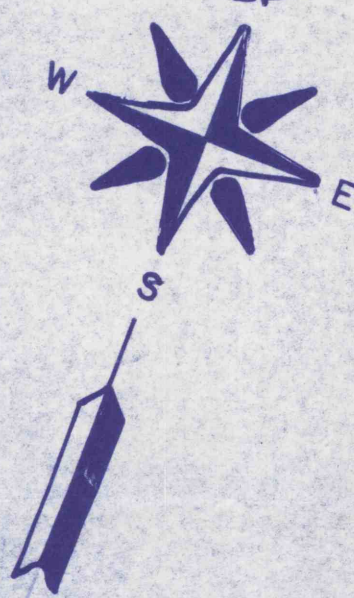

LOCATION MAP

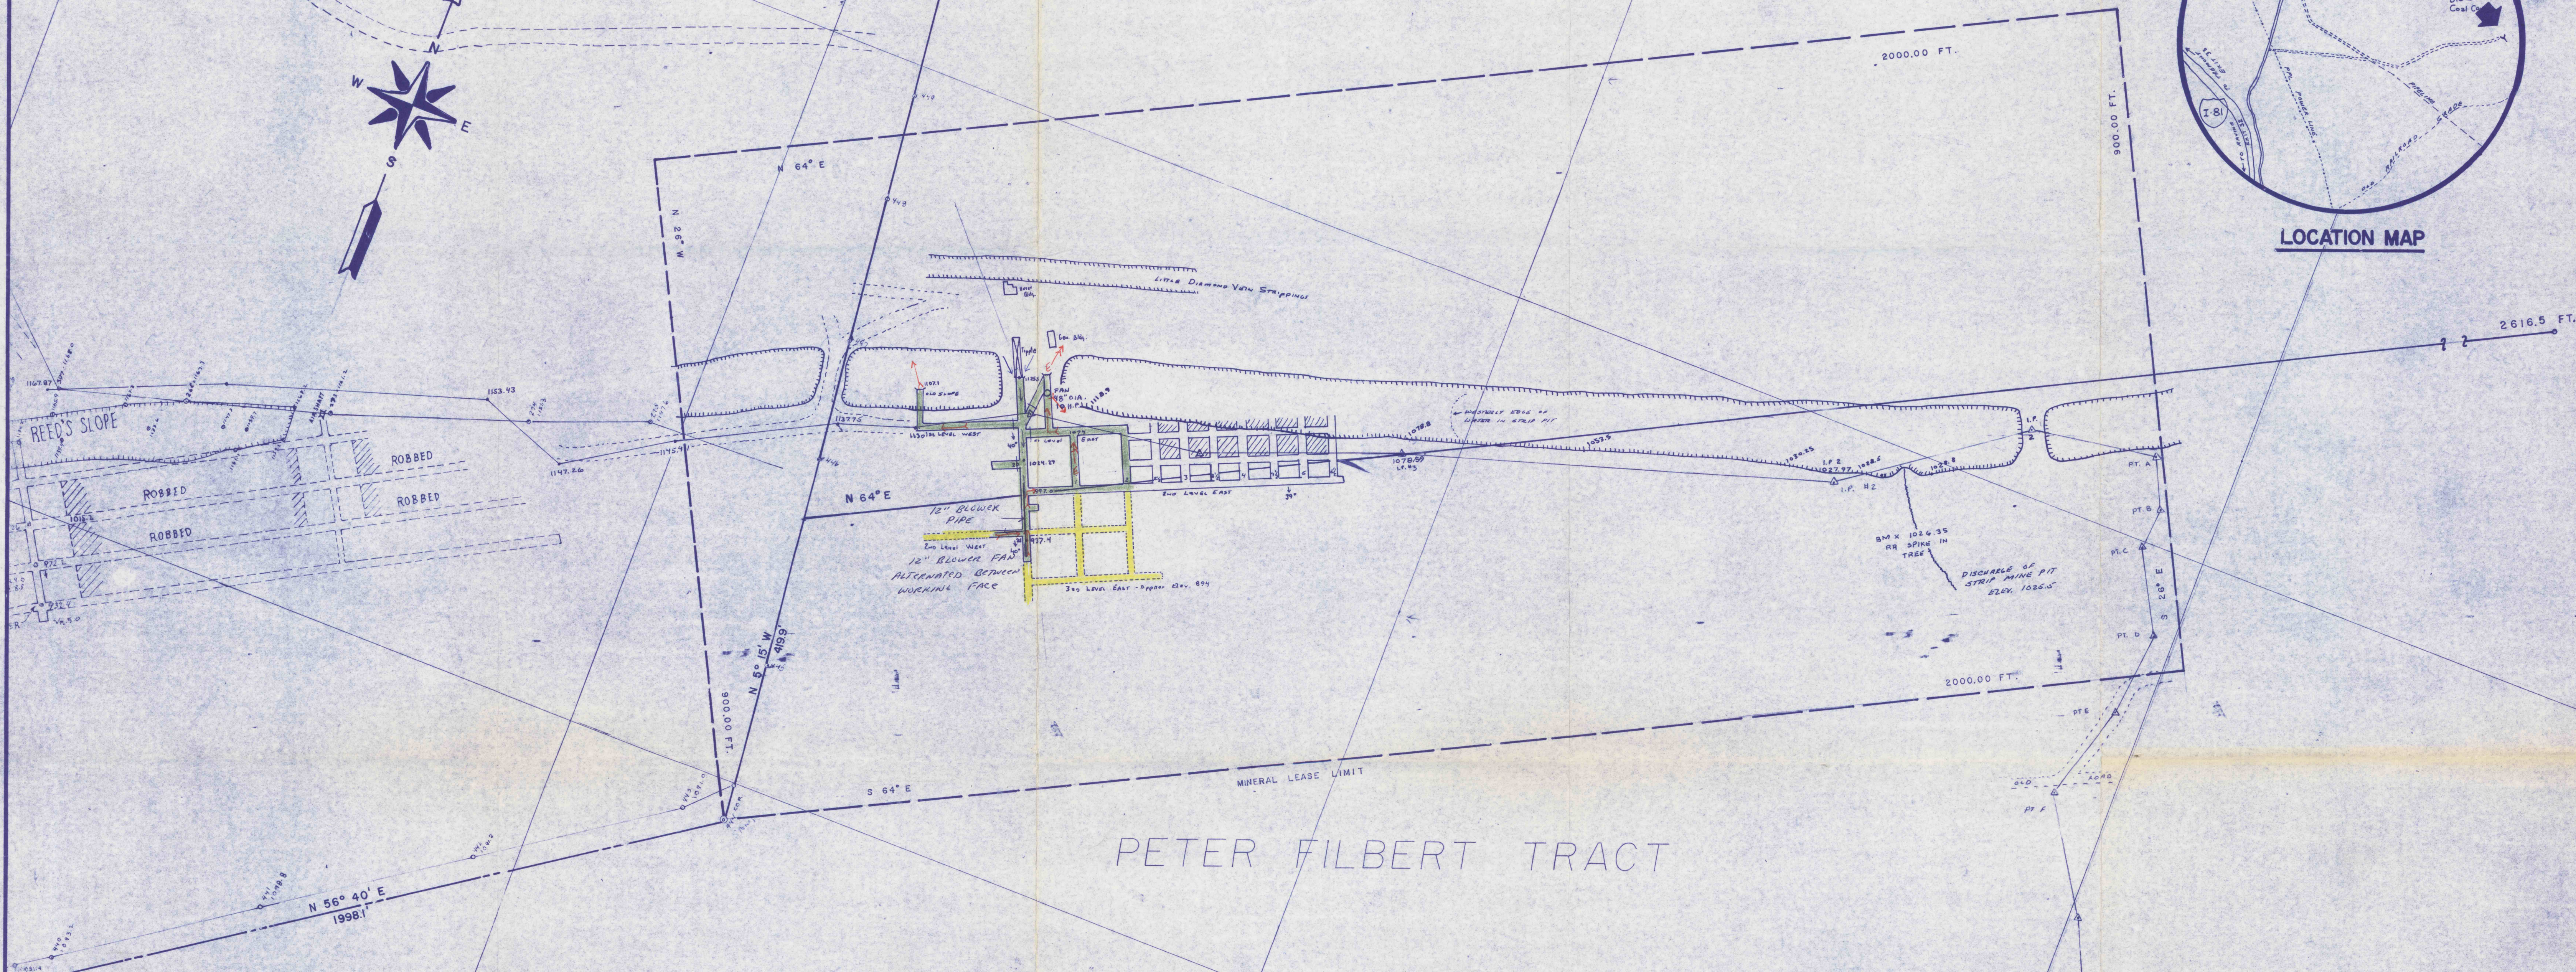

PETER FILBERT TRACT

TREMONT TOWNSHIP

SHUYLKILL COUNTY

LEGEND	
INTAKE AIR	→
RETURN AIR	←
ESCAPEWAY	→
ACTIVE WORKINGS	—
PROPOSED WORK	- - -
SURFACE TRAVERSE PT.	△
PROPERTY LINE	—
LEASE LINE	- - -
UNDERGROUND PT.	•

I, the undersigned, hereby certify that this map is correct and shows all the information, to the best of my knowledge and belief, required by the mining laws of this state, and covers the period ending May 12, 1986.

Signed Michael A. Benz




BIG DIAMOND COAL CO.

MAP SHOWING WORKINGS
OF
DIAMOND VEIN SLOPE

DATE May 12, 1986
SCALE 1" = 100'
DRAWN BY DAVID S. HUNNANSEY

Diamond Vein Slope
1744 Grand Ave.
Tower City, Pa. 17980

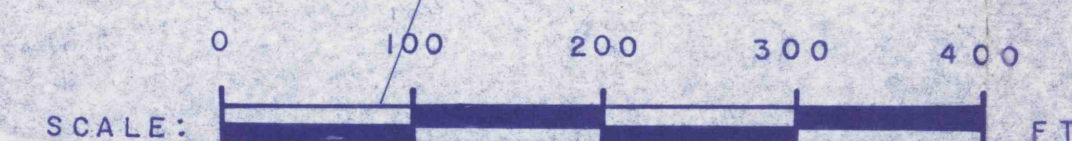

Reed Slope & Lengel Bros. workings traced from old mine maps