


R A C T

PHILIP HIMMELBERGER TRACT

G M P L A N D C O M P A N Y

- #14 DIAMOND
- #15 L. ORCHARD
- #16 ORCHARD
- #17 PRINCE
- #18 HOLMES
- #19 T. MAMMOTH
- #20 M.S. MAMMOTH
- #21 M.S. MAMMOTH

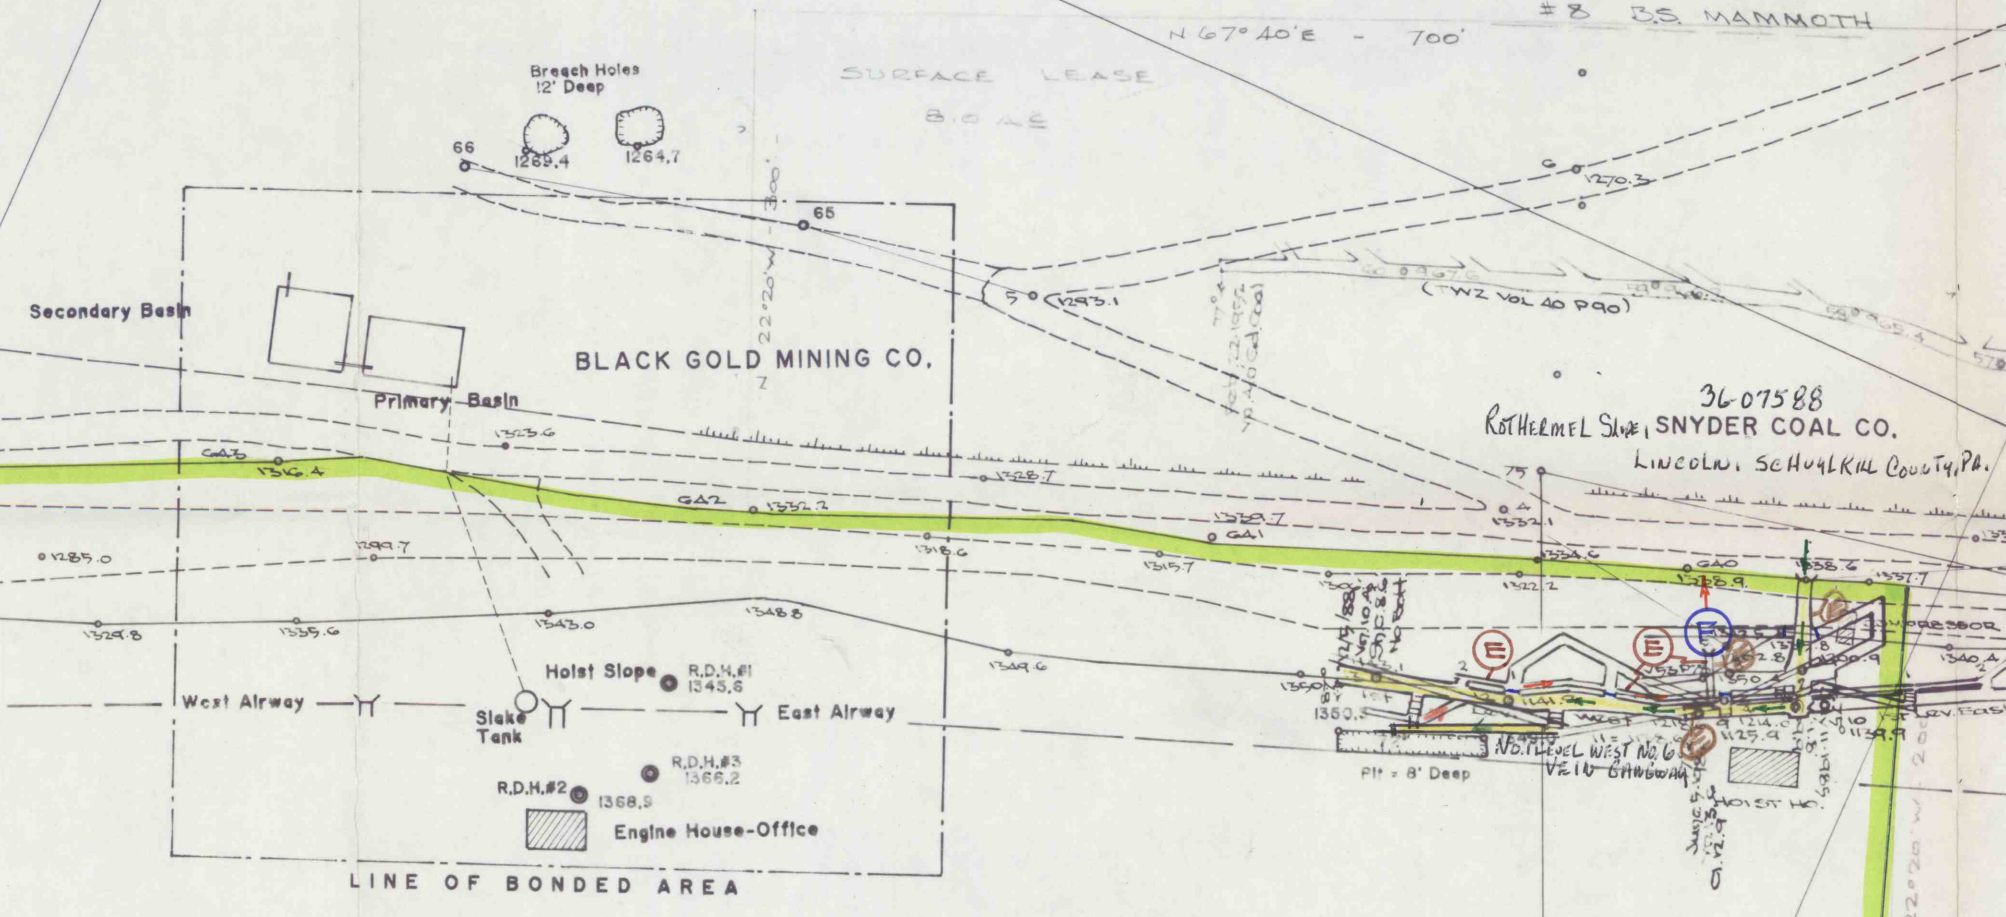

VENTILATION SYMBOLS

(F) = Main Fan	[X] = Air Bridge
(A) = Auxiliary Fan	[+/-] = Regulator
[>] = Air Flow - Intake	[+/-] = Man Door
[<] = Air Flow - Exhaust	V = Velocity, fpm
+ = Permanent Stopping	Q = Quantity, cfm
+ = Temporary Stopping	WG = Water Gauge
[~] = 6.5 ft. dip	

MINE MAP
Showing the location and extent of development of the Snyder Coal Co. slope mine. Situate on the south dip (inverted) Buck Mountain vein, Tremont Township, Schuylkill County.
A.B. Riedel, P.E. Dec. 5, 1988

april 1988