



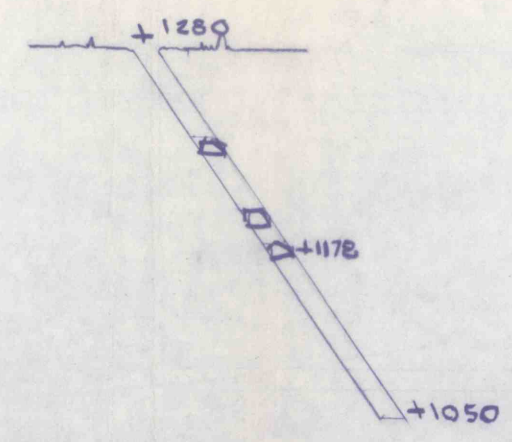

SECTION THRU SLOPE

SCALE: 1"=100'-0"

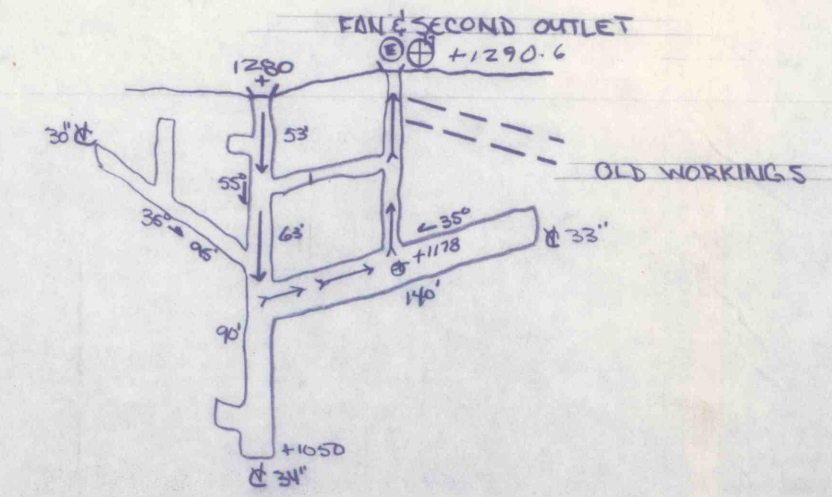


CROSS SECTION THRU SLOPE

SCALE: 1"=100'-0"


LEGEND

- ⊕ FAN
- ← AIR INTAKE
- ← AIR RETURN
- TEMPORARY STOPPING
- = PERMANENT STOPPING
- ⊙ ESCAPEWAY
- ⊙ PUMP No pump
- ⊙ BLOWER
- ===== 6" FLEX TUBING
- BRATISH

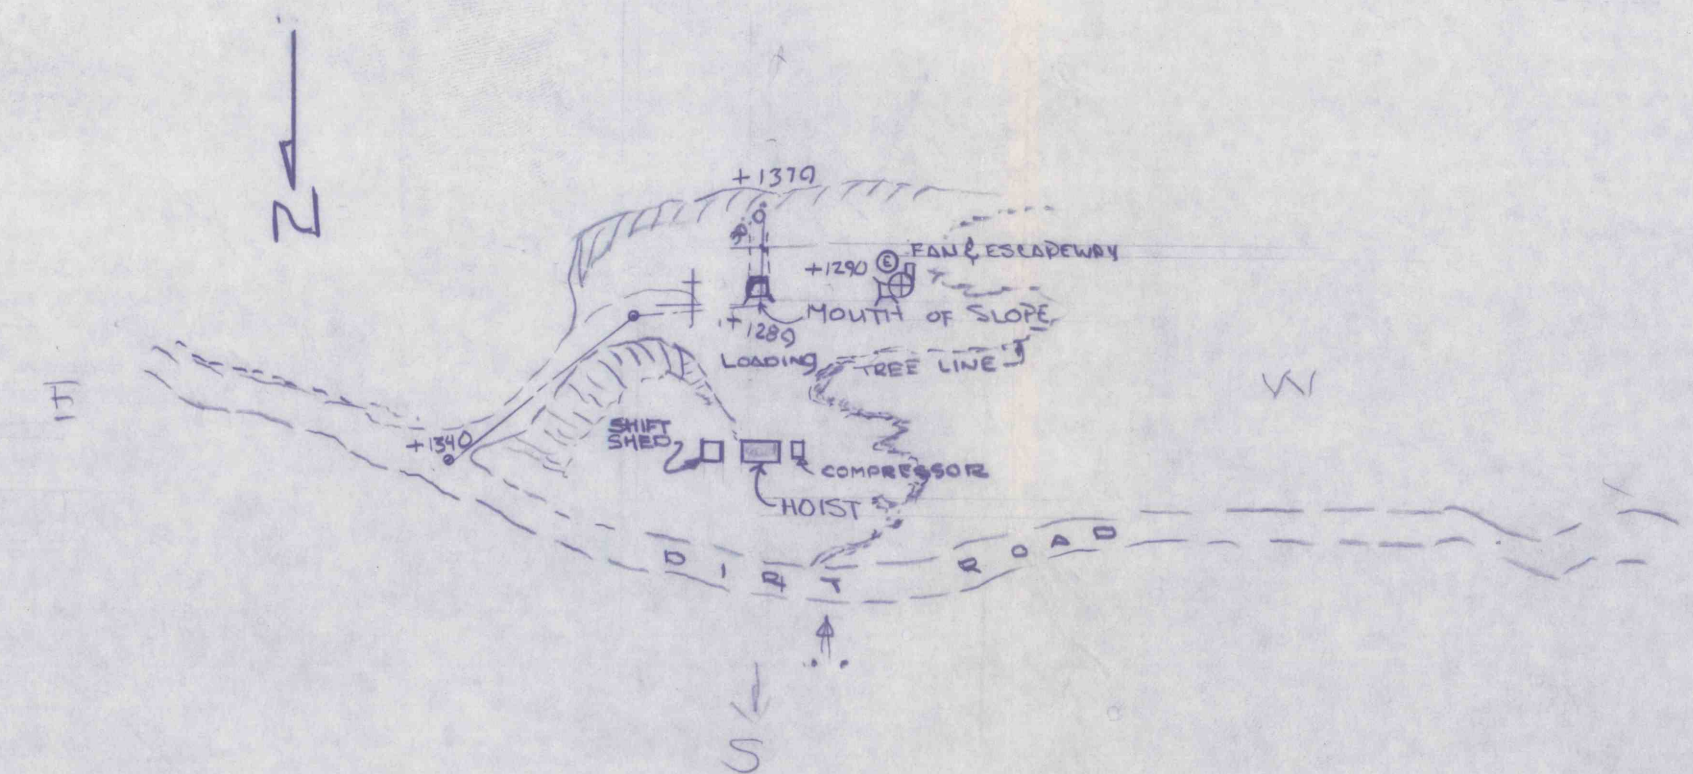

SURFACE FEATURES

SCALE: 1"=100'-0"

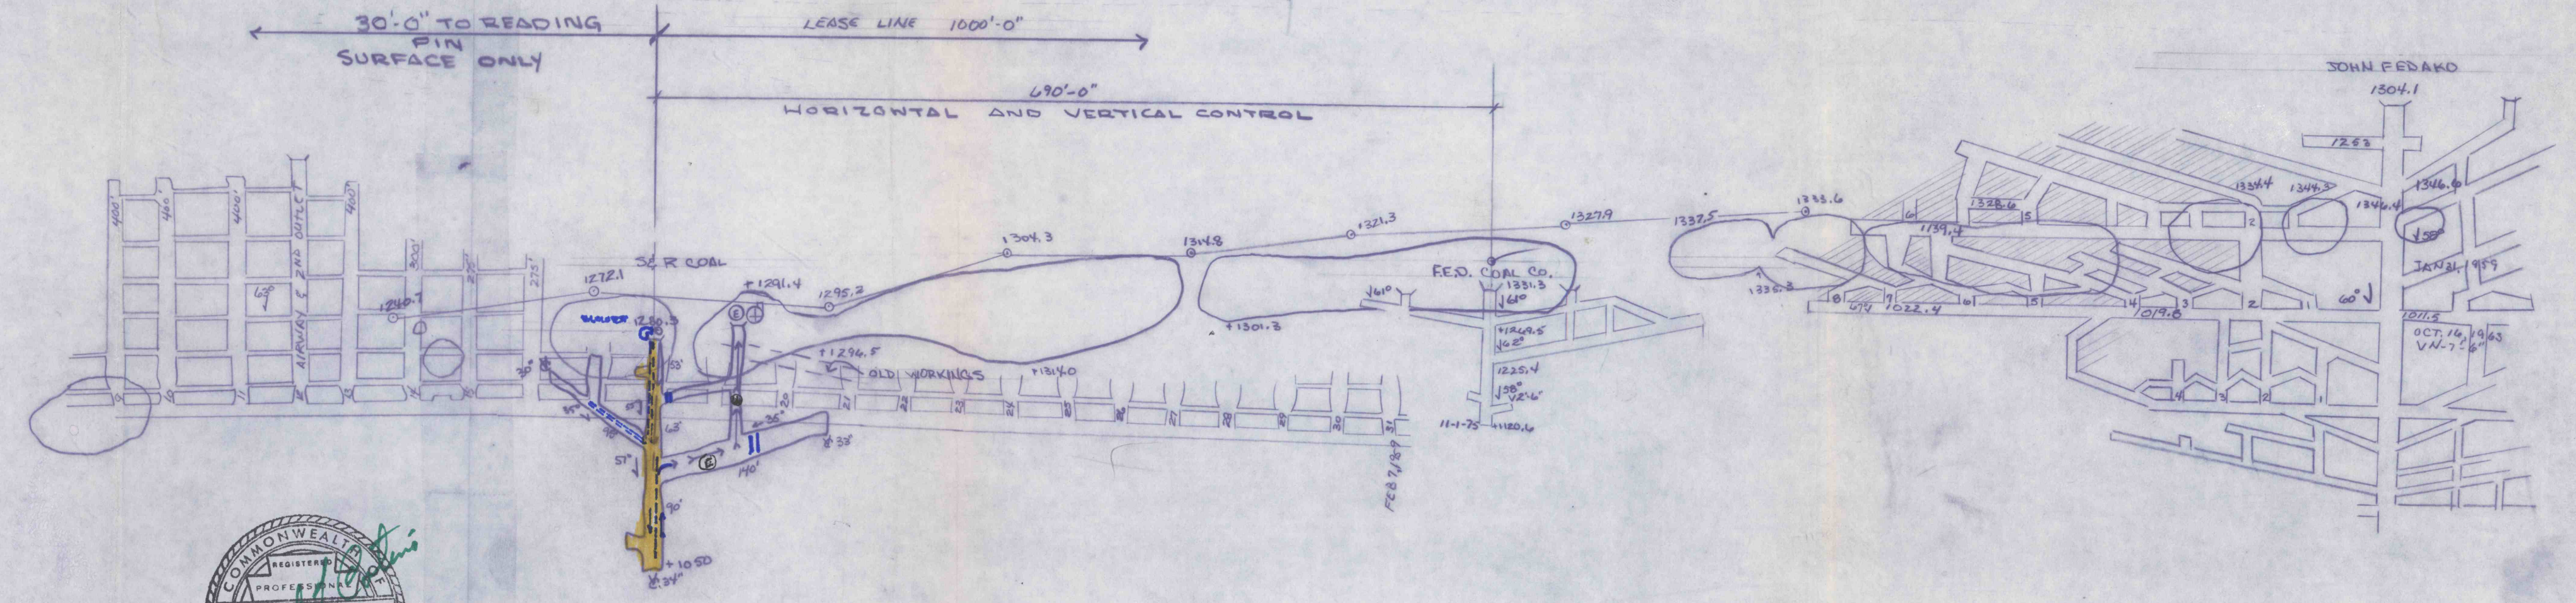

S & R COAL CO.
NO. 1 SLOPE SOUTH DIP
I.D. 36-07742
SCALE 1"=100'-0"

TOP SPLIT OF THE ONE VEIN

REVISION MARCH 17 1984