





SITE STAKE
 PA GAME CORNER # 8
 I.P. PIPE IN STAKE
 PA GAME CORNER # 10
 N 25° 23' W 281.57'
 I.P. STAKE
 PA GAME CORNER # 11
 1/4 IN CONG.
 PA GAME CORNER # 9

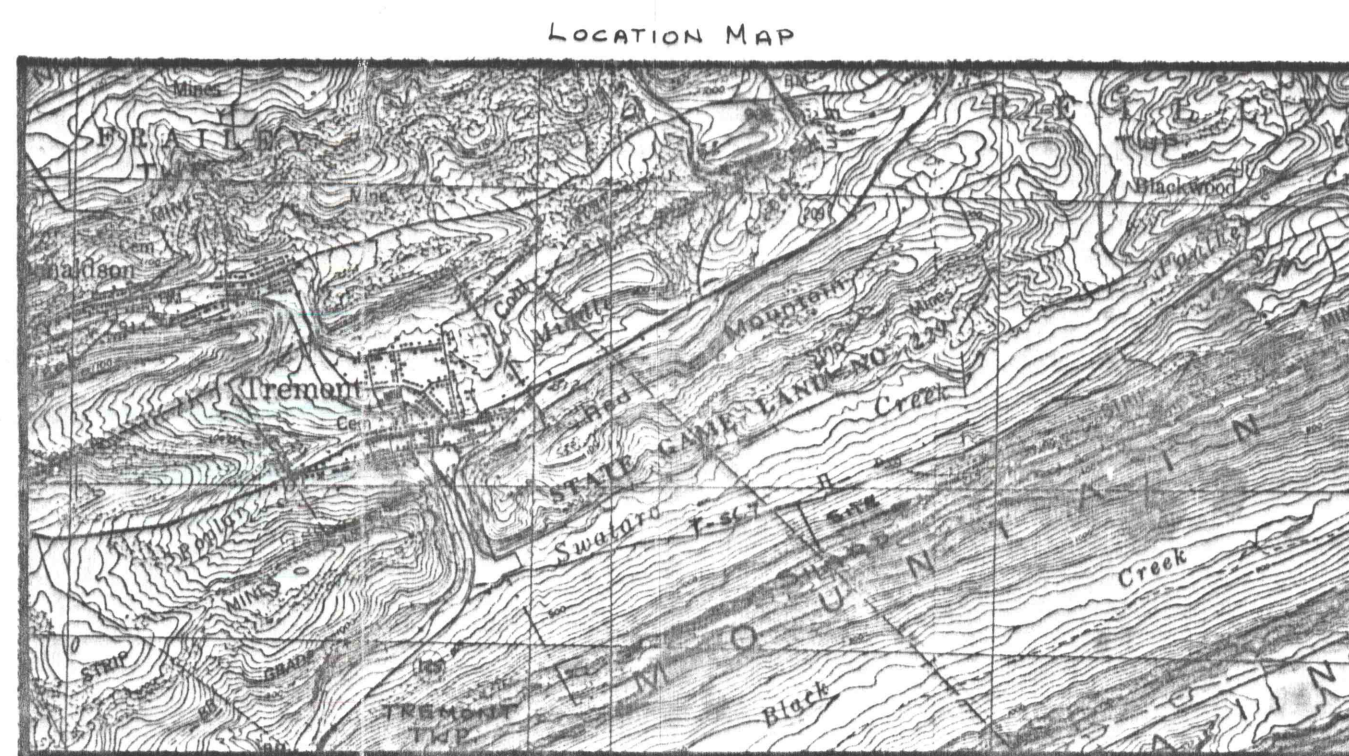

SCALE: 1:50000

NO.	NORTH	EAST	ELEV.
1	7413.09	5455.18	1058.5
2	7252.91	4661.64	1039.7
3	7330.38	5071.05	1041.7
4	6683.75	5290.31	951.2
5	6660.37	5261.77	951.4
6	6632.09	5270.50	952.0
7	6660.25	5344.00	952.7
8	6860.55	5377.25	1042.0
9	6780.24	5407.20	985.2
10	6752.01	5302.46	987.0
11	6737.91	5273.45	986.1

SPECIAL NOTES:
 * ELEVATIONS BASED ON DATUM OF MINE MAP OF RONALD DONTON COAL CO. BY WALTER J. MANHART, P.E.
 * NORTH BASED ON PA. GAME COMMISSION CORNERS # 11 & 10 AS DESCRIBED ON MINE MAP OF A.K.A. COAL INC. BY ELWOOD F. WIRTH, P.E.
 * COORDINATE VALUES ARE ASSUMED, BASED ON MONUMENTS #1 & #2.

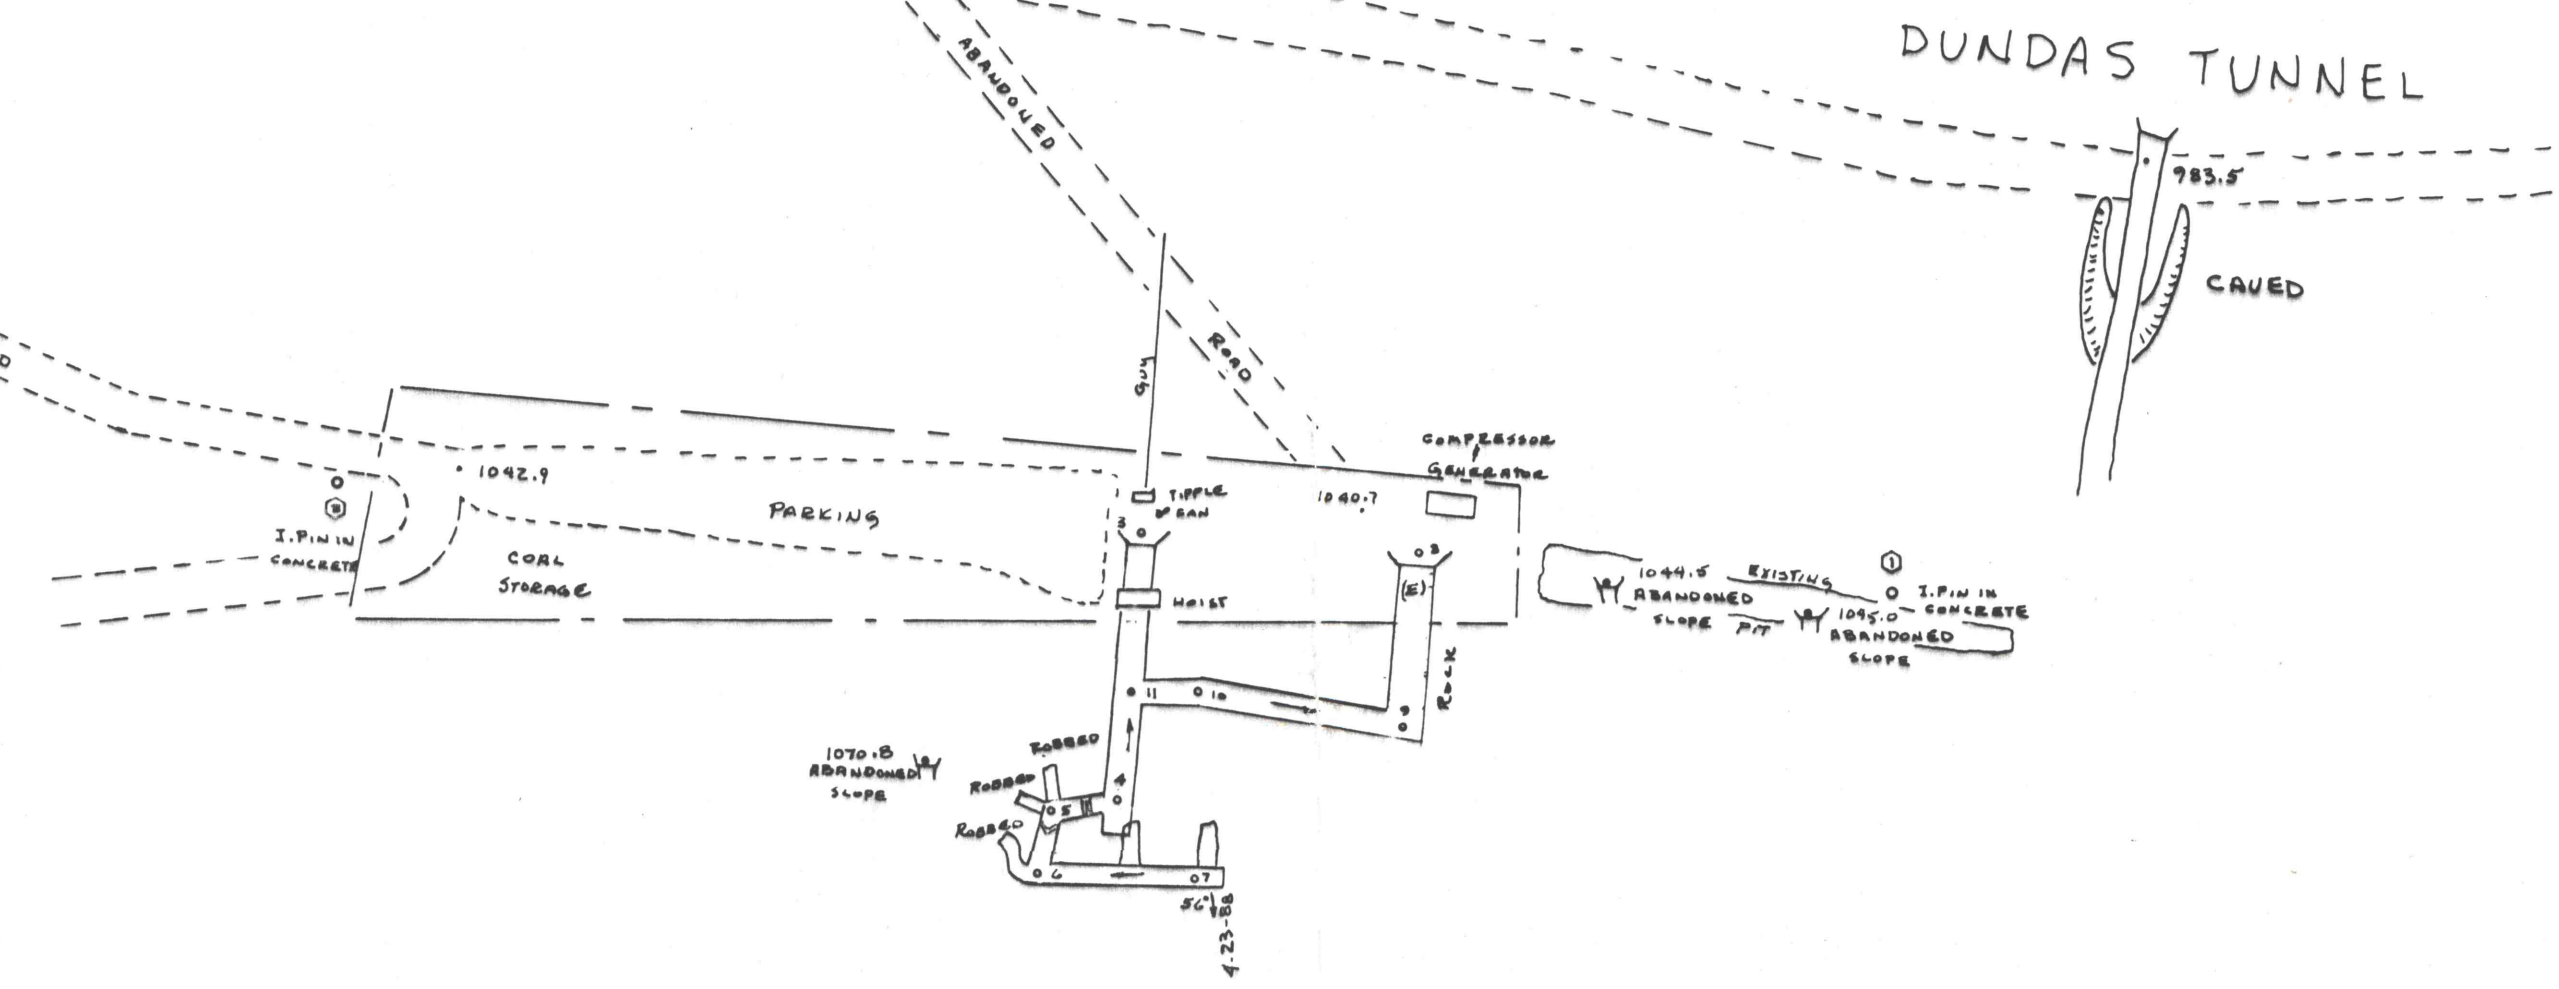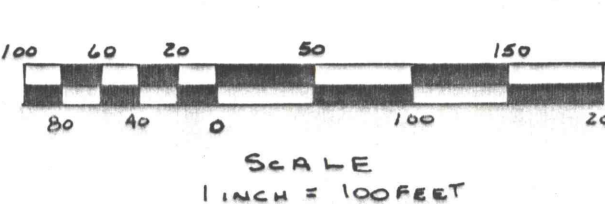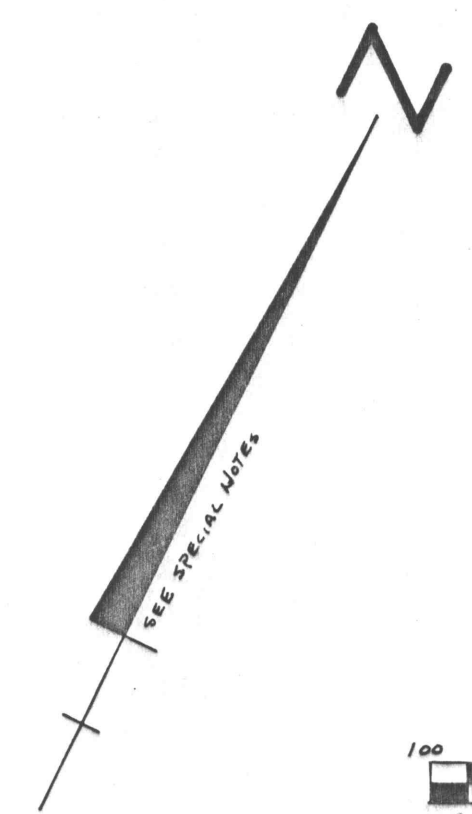

LEGEND
 (E) ESCAPE WAY
 FAN
 FAULT
 TRAVERSE
 STOPPING
 DIRECTION OF AIRFLOW

William J. Messner, P.L.S.
 R.D. #1, Box 1523
 Herndon, PA. 17930
 (717) 758-9266

RECEIVED
 AUG 25 1988
 U.S. DEPT. OF LABOR
 MSHA
 WIDENHARMS, PA

A.K.A. COAL INC.
 I.D. #54851345
 TOWNSHIP OF REILLY
 COUNTY OF SCHUYLKILL
 COMMONWEALTH OF PENNSYLVANIA
 DIAMOND VEIN - SOUTH DIP
 SHARP MOUNTAIN
 SCALE 1" = 100'
 DATE: JULY 21, 1988
 FILE: AKA COAL

28849-E