LOCATION MAP

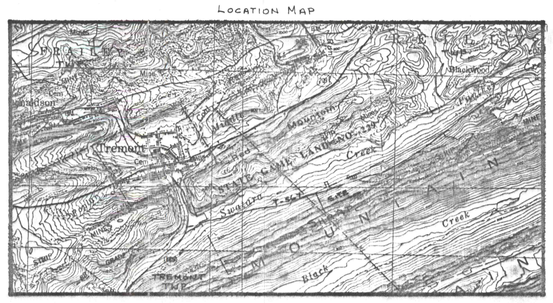

SCALE: 1:30000

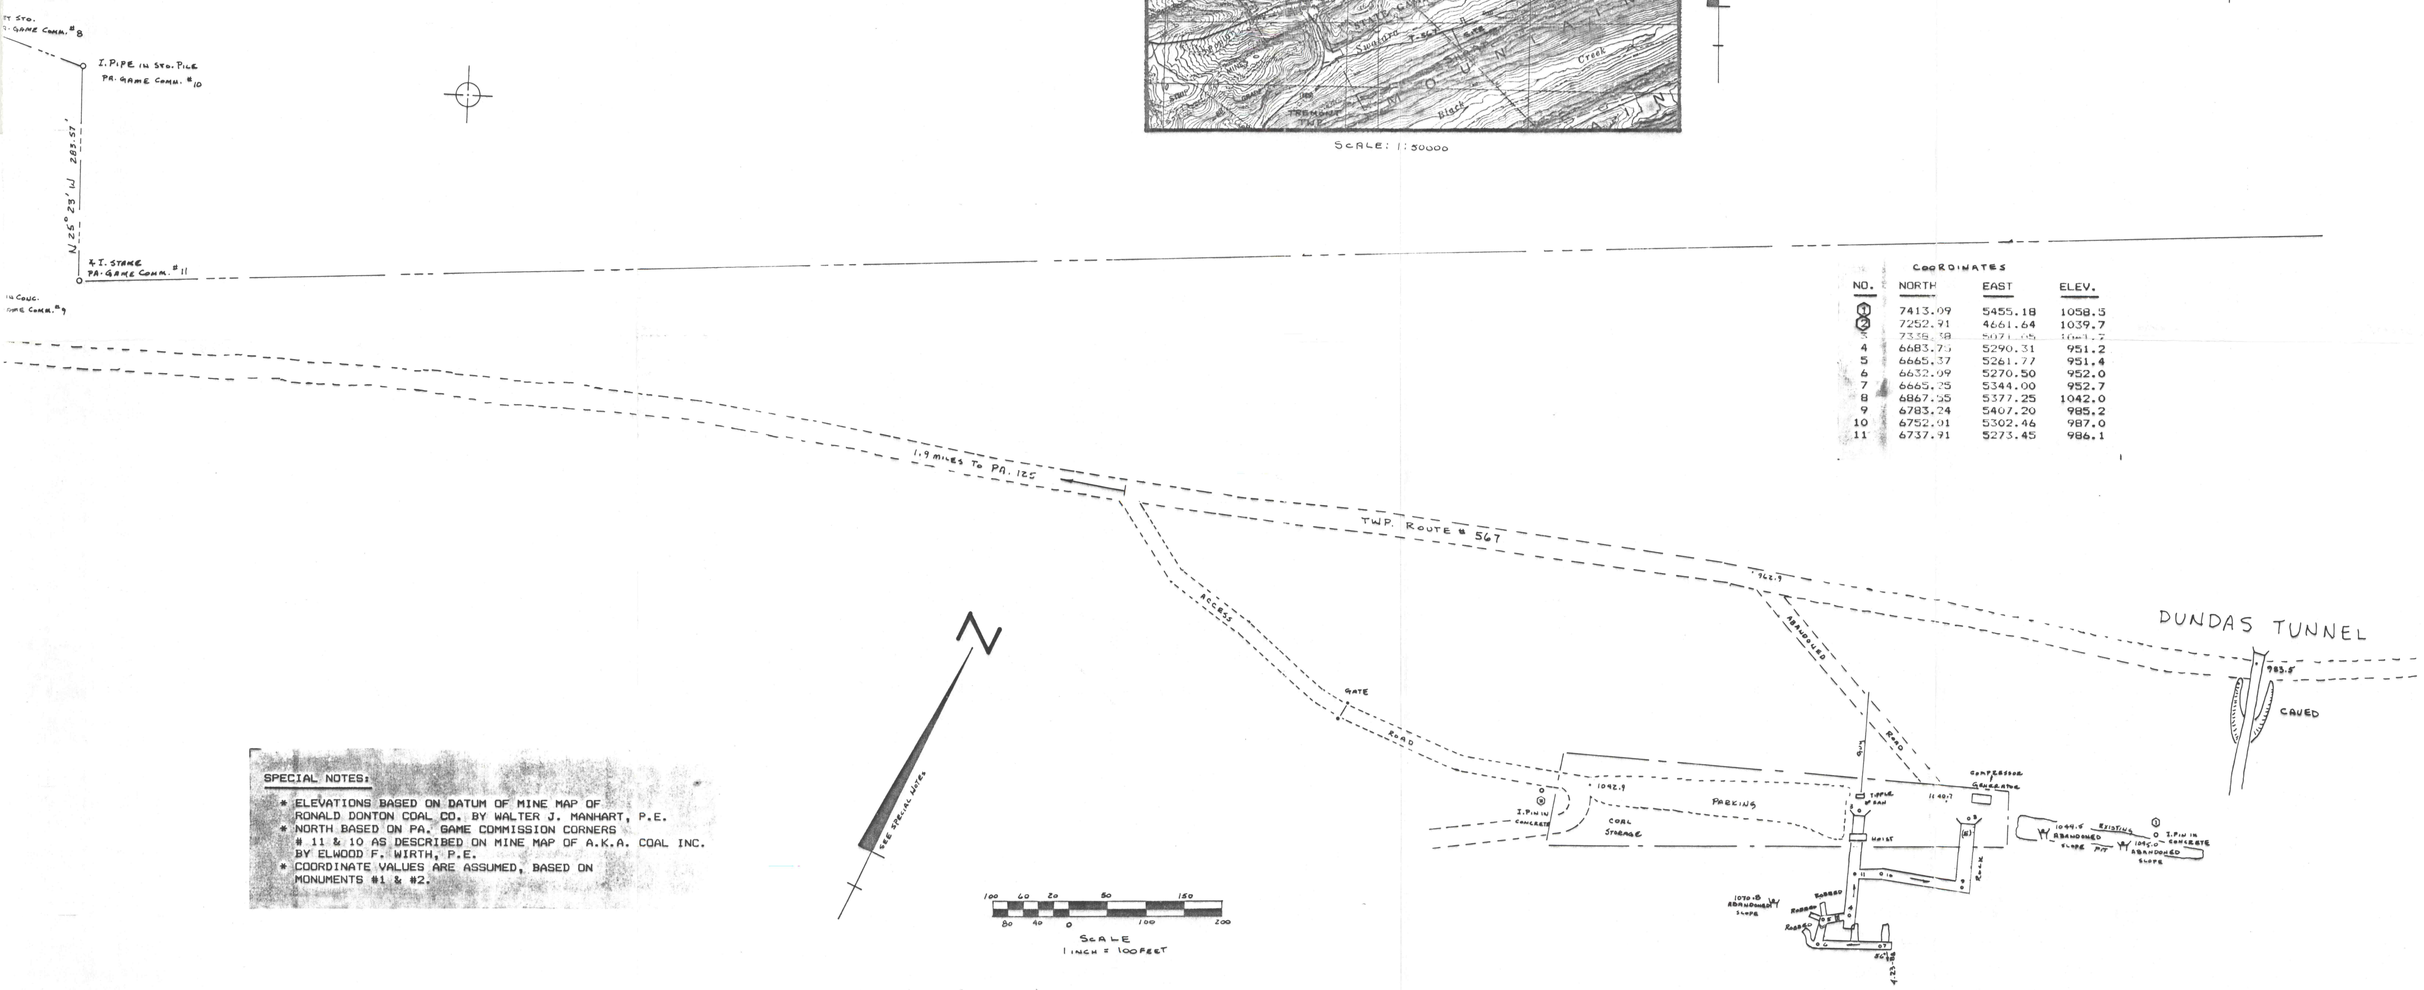

COORDINATES

NO.	NORTH	EAST	ELEV.
1	7413.09	5455.18	1058.5
2	7252.91	4661.64	1039.7
3	7338.38	5071.05	1041.7
4	6683.76	5290.31	951.2
5	6665.37	5261.77	951.4
6	6632.09	5270.50	952.0
7	6665.25	5344.00	952.7
8	6867.55	5377.25	1042.0
9	6783.24	5407.20	985.2
10	6752.01	5302.46	987.0
11	6737.91	5273.45	986.1

SPECIAL NOTES:

* ELEVATIONS BASED ON DATUM OF MINE MAP OF RONALD DONTON COAL CO. BY WALTER J. MANHART, P.E.
* NORTH BASED ON PA. GAME COMMISSION CORNERS # 11 & 10 AS DESCRIBED ON MINE MAP OF A.K.A. COAL INC. BY ELWOOD F. WIRTH, P.E.
* COORDINATE VALUES ARE ASSUMED, BASED ON MONUMENTS #1 & #2.

LEGEND

(E) ESCAPE WAY
FAN
FAULT
TRAVERSE
STOPPING
DIRECTION OF AIRFLOW

William J. Messner, P.L.S.
R.D. #1, Box 1523
Herndon, PA. 17830
(717) 758-9266

RECEIVED
AUG 25 1988
U. S. DEPT. OF LABOR
MSHA
WILKES-BARRE, PA.

A.K.A. COAL INC.
I.D. #54851345
TOWNSHIP OF REILLY
COUNTY OF SCHUYLKILL
COMMONWEALTH OF PENNSYLVANIA
DIAMOND VEIN - SOUTH DIP
SHARP MOUNTAIN
SCALE : 1" = 100
DATE : JULY 21, 1988
FILE : AKA COAL

William J. Messner

28849-E

1083