


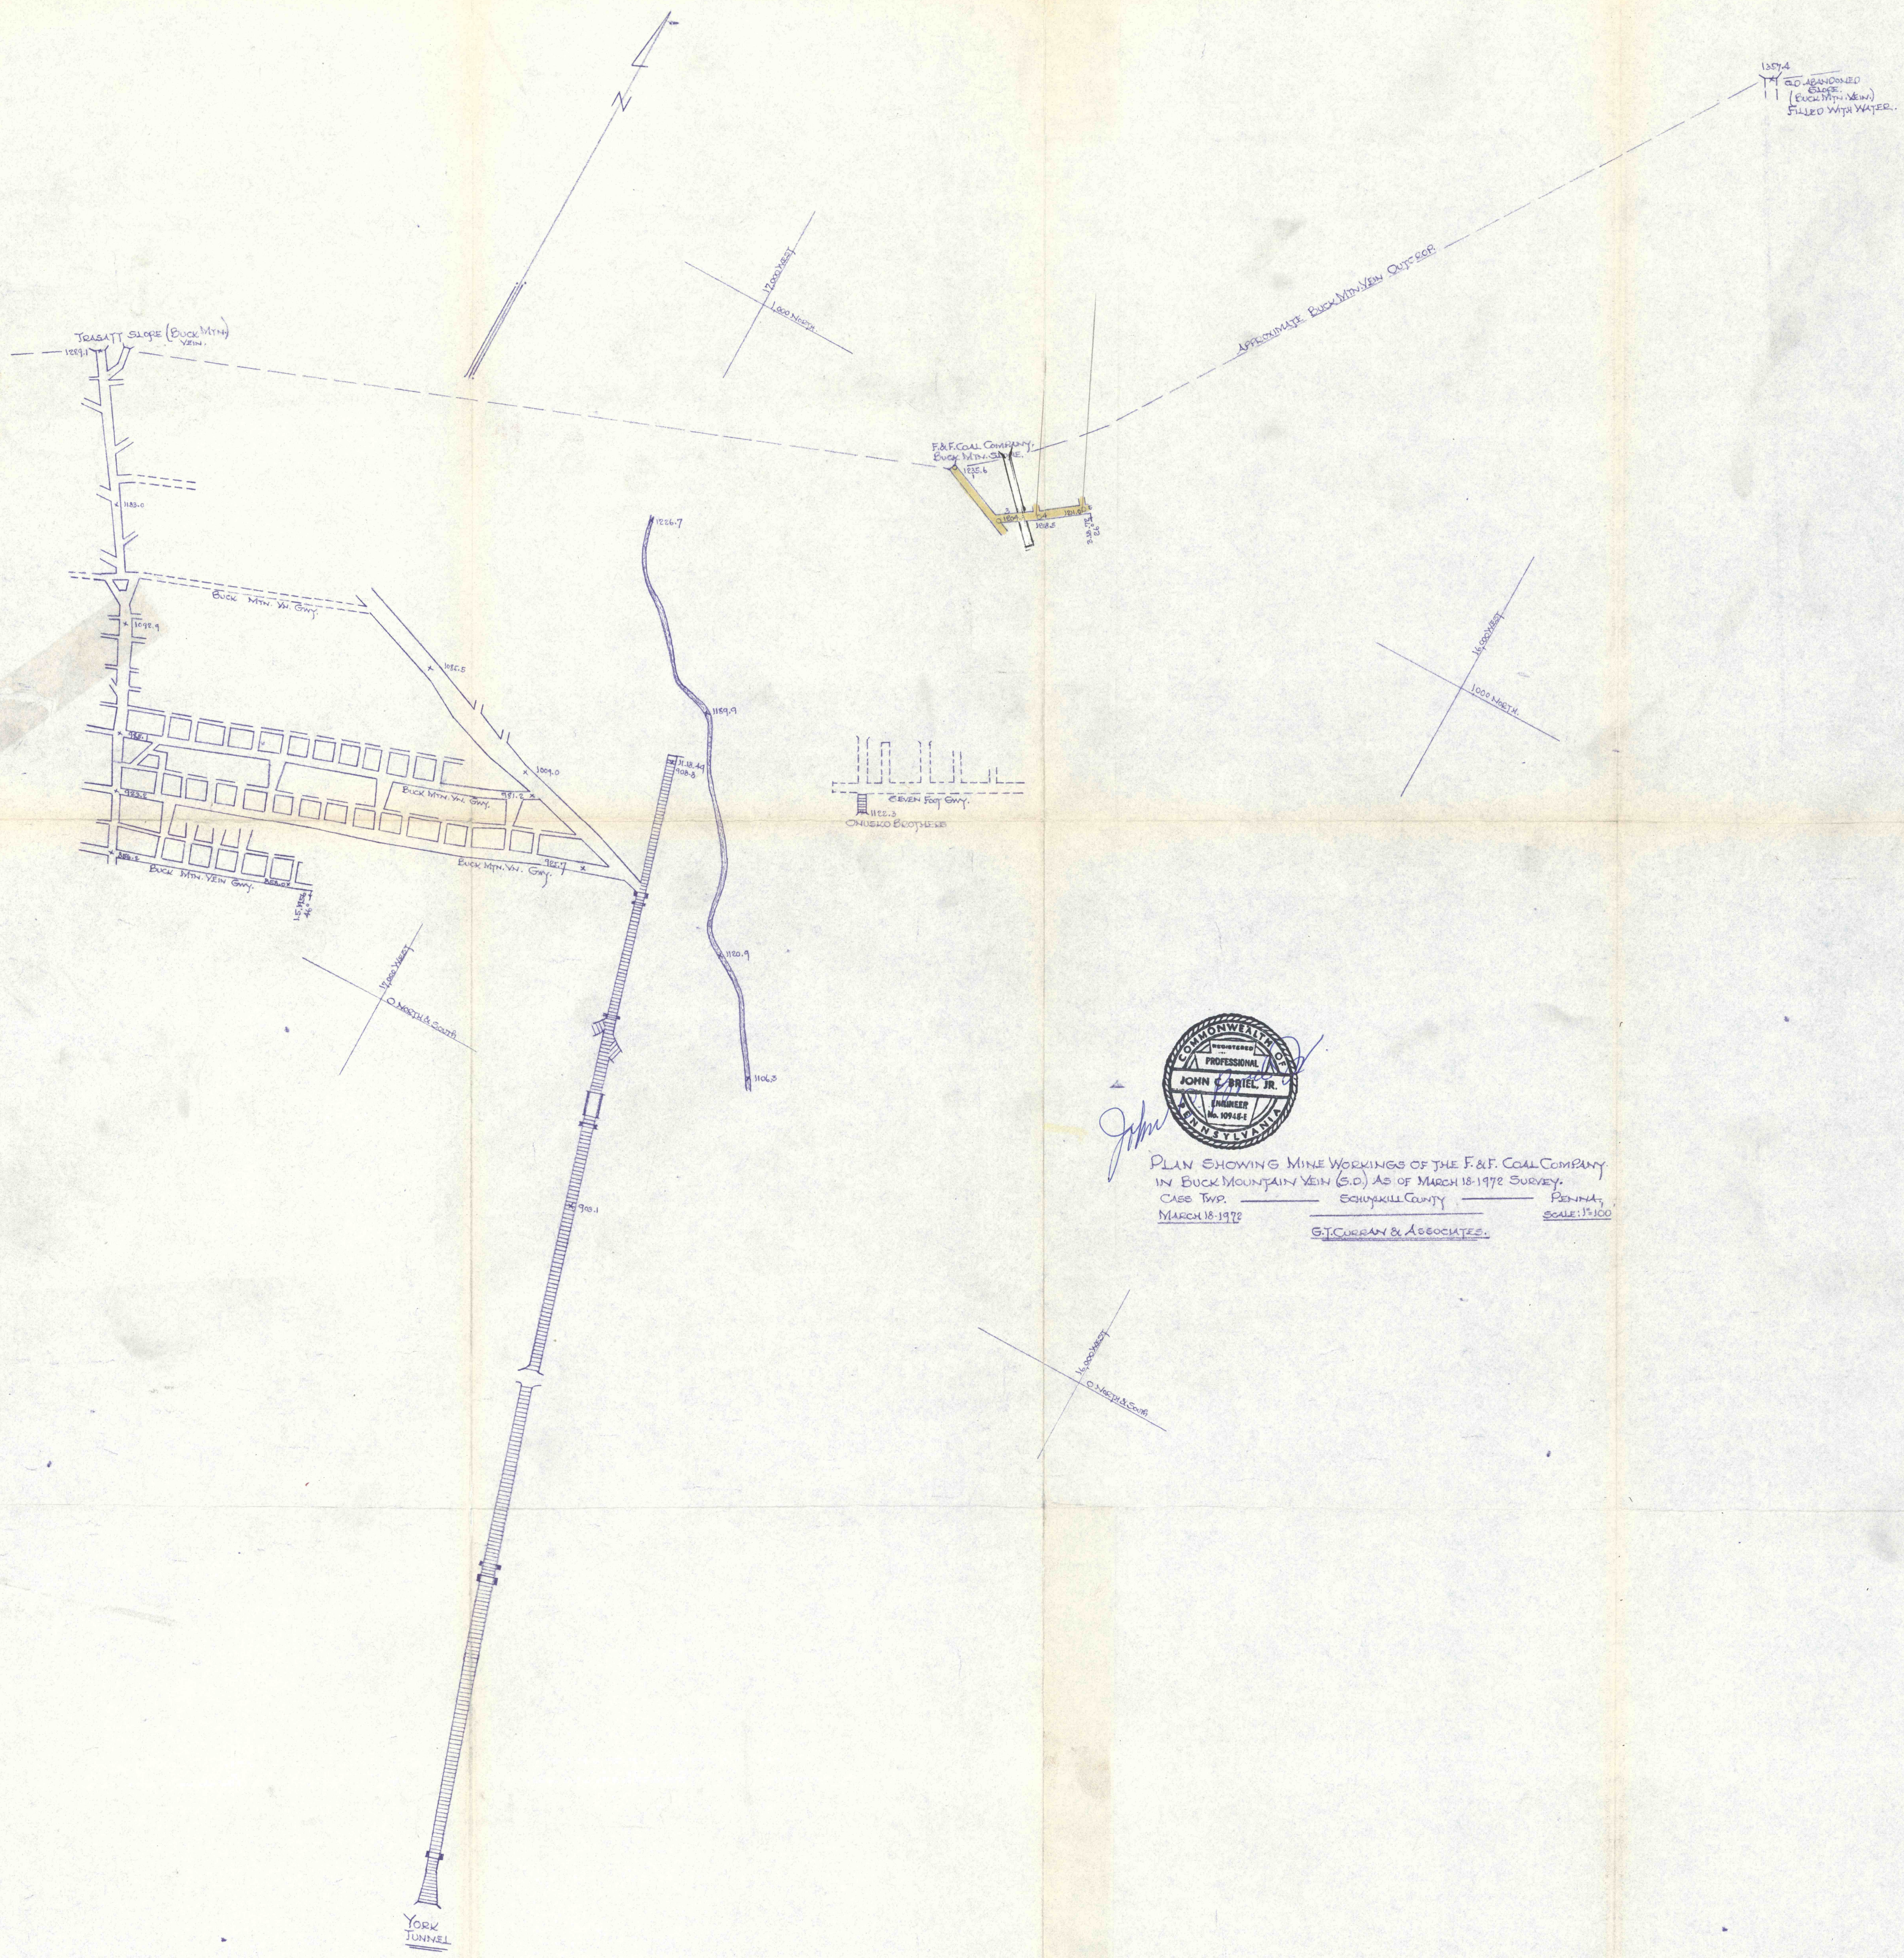

PLAN SHOWING MINE WORKINGS OF THE F&F COAL COMPANY  
IN BUCK MOUNTAIN VEIN (S.D.) AS OF MARCH 18-1972 SURVEY  
CASE TWP. SCHUYLKILL COUNTY PENNSA.  
MARCH 18-1972  
