



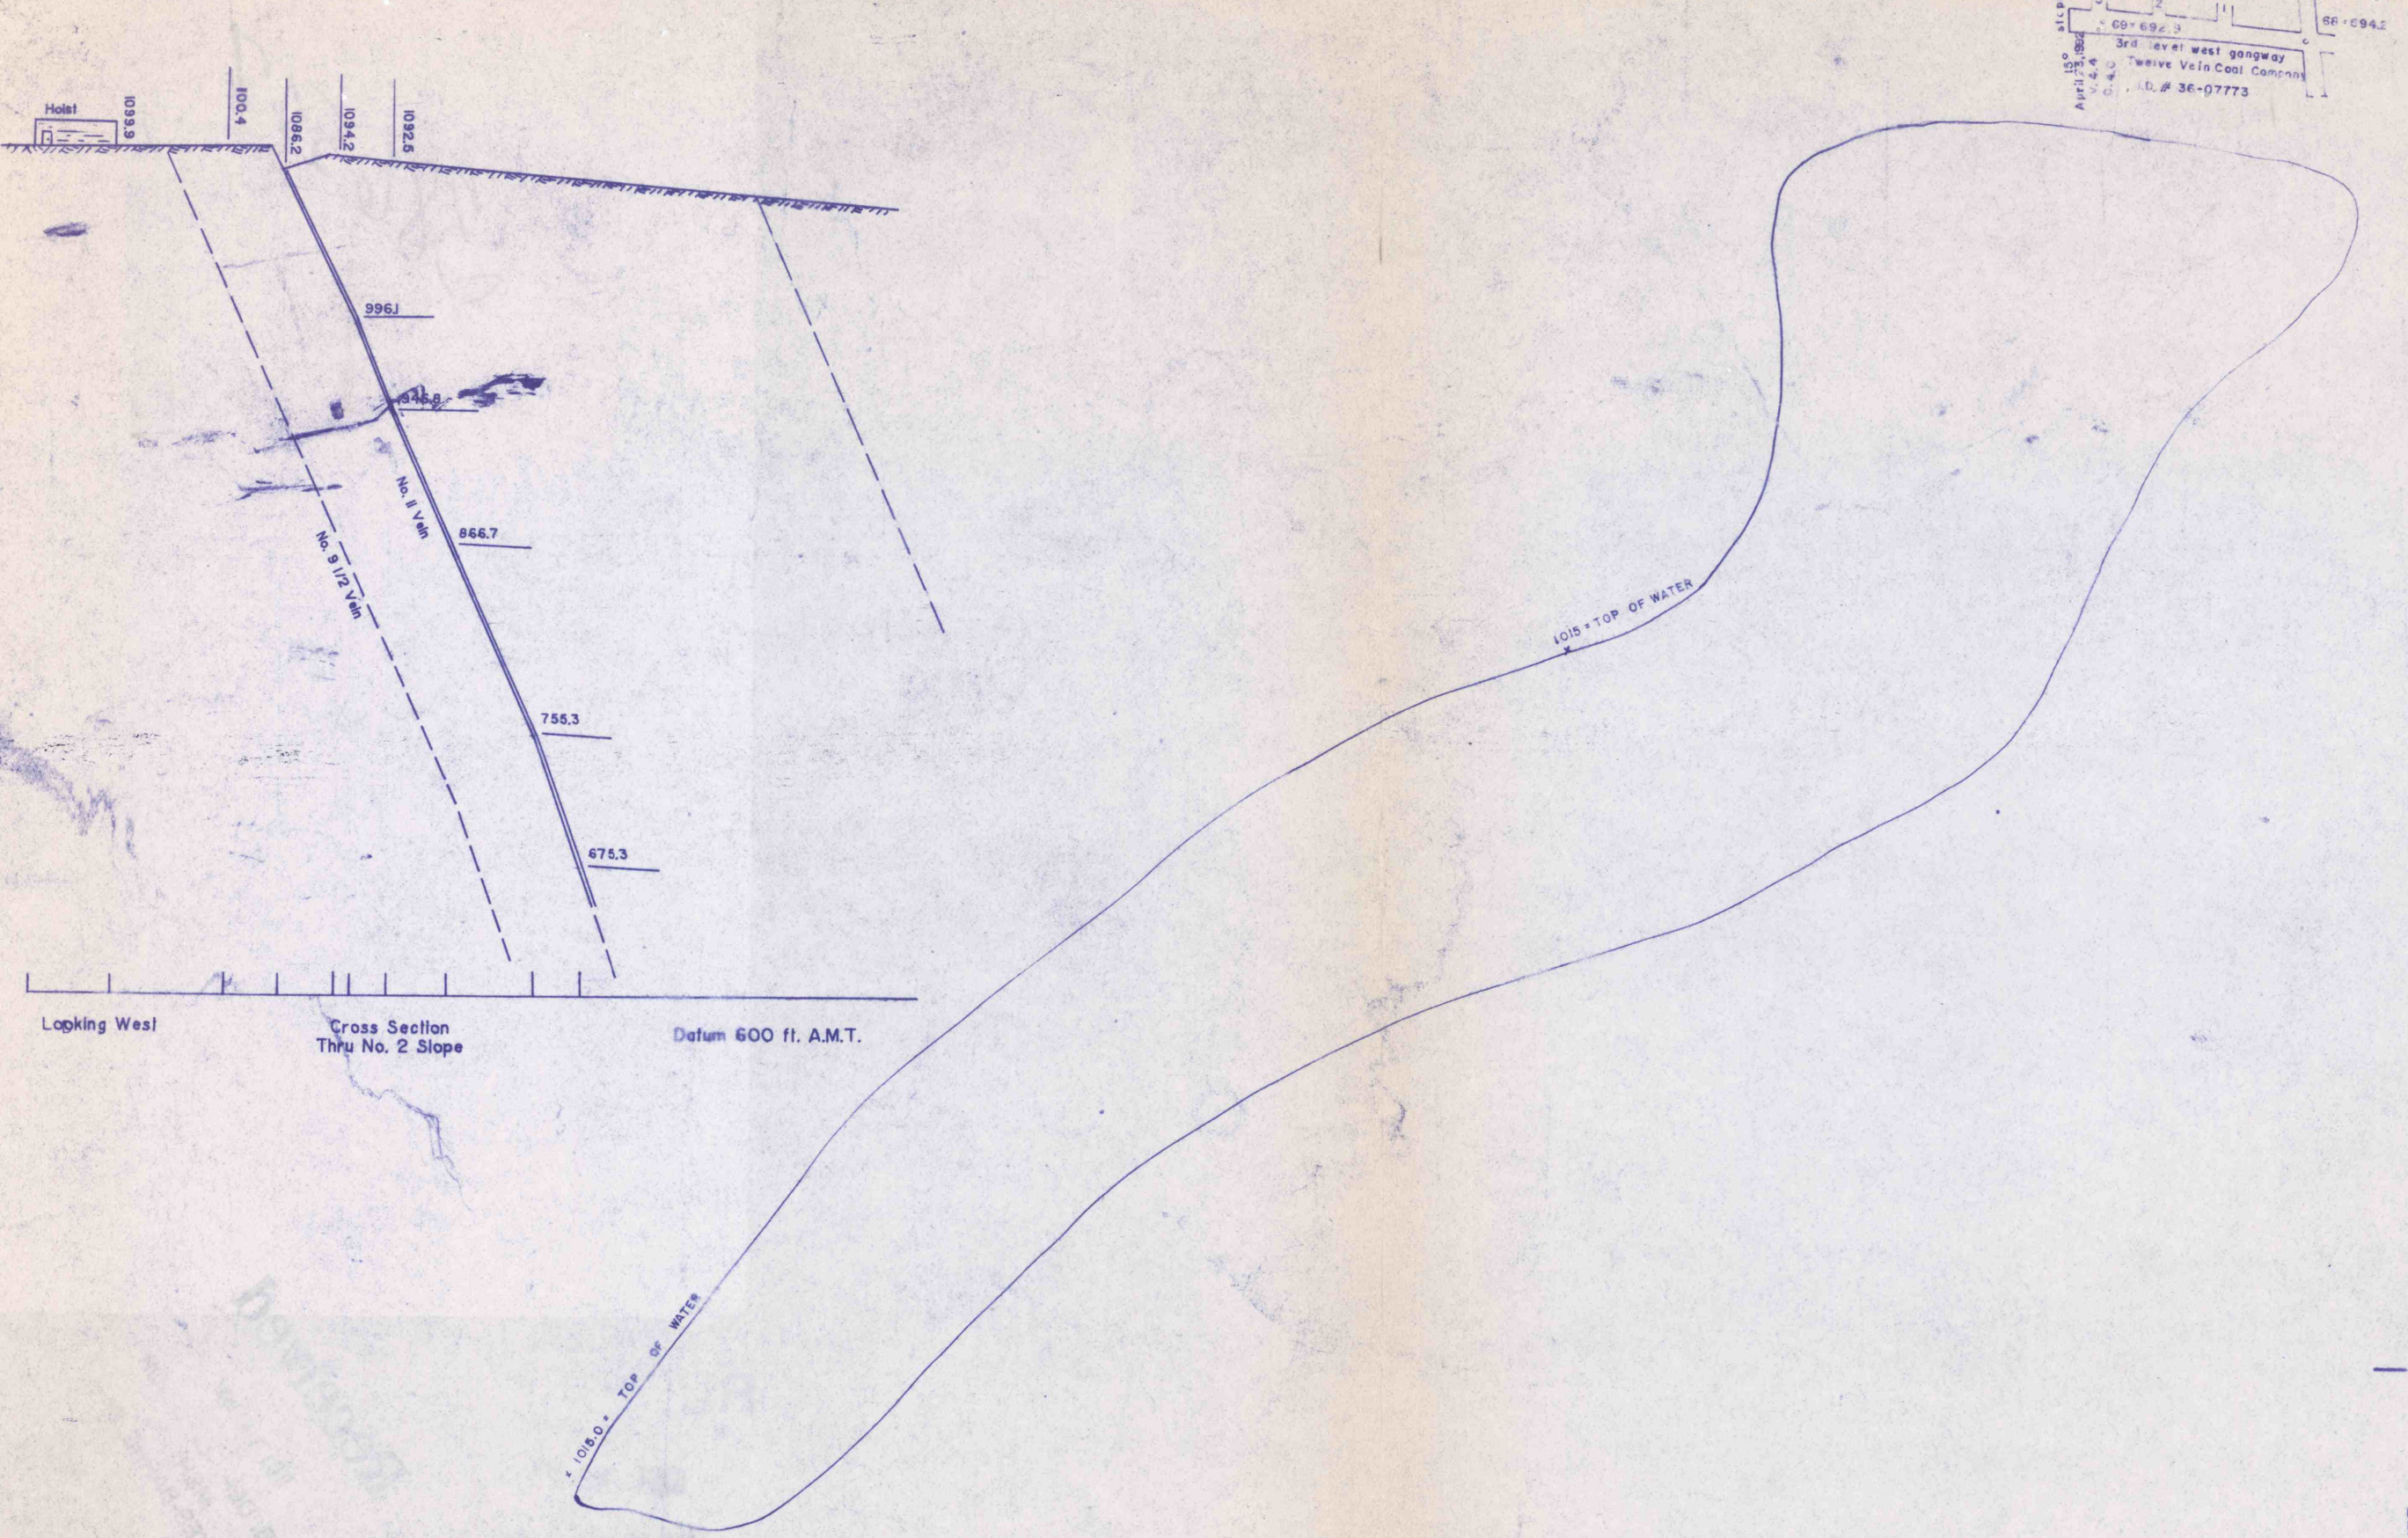


PETER MAURER TRACT

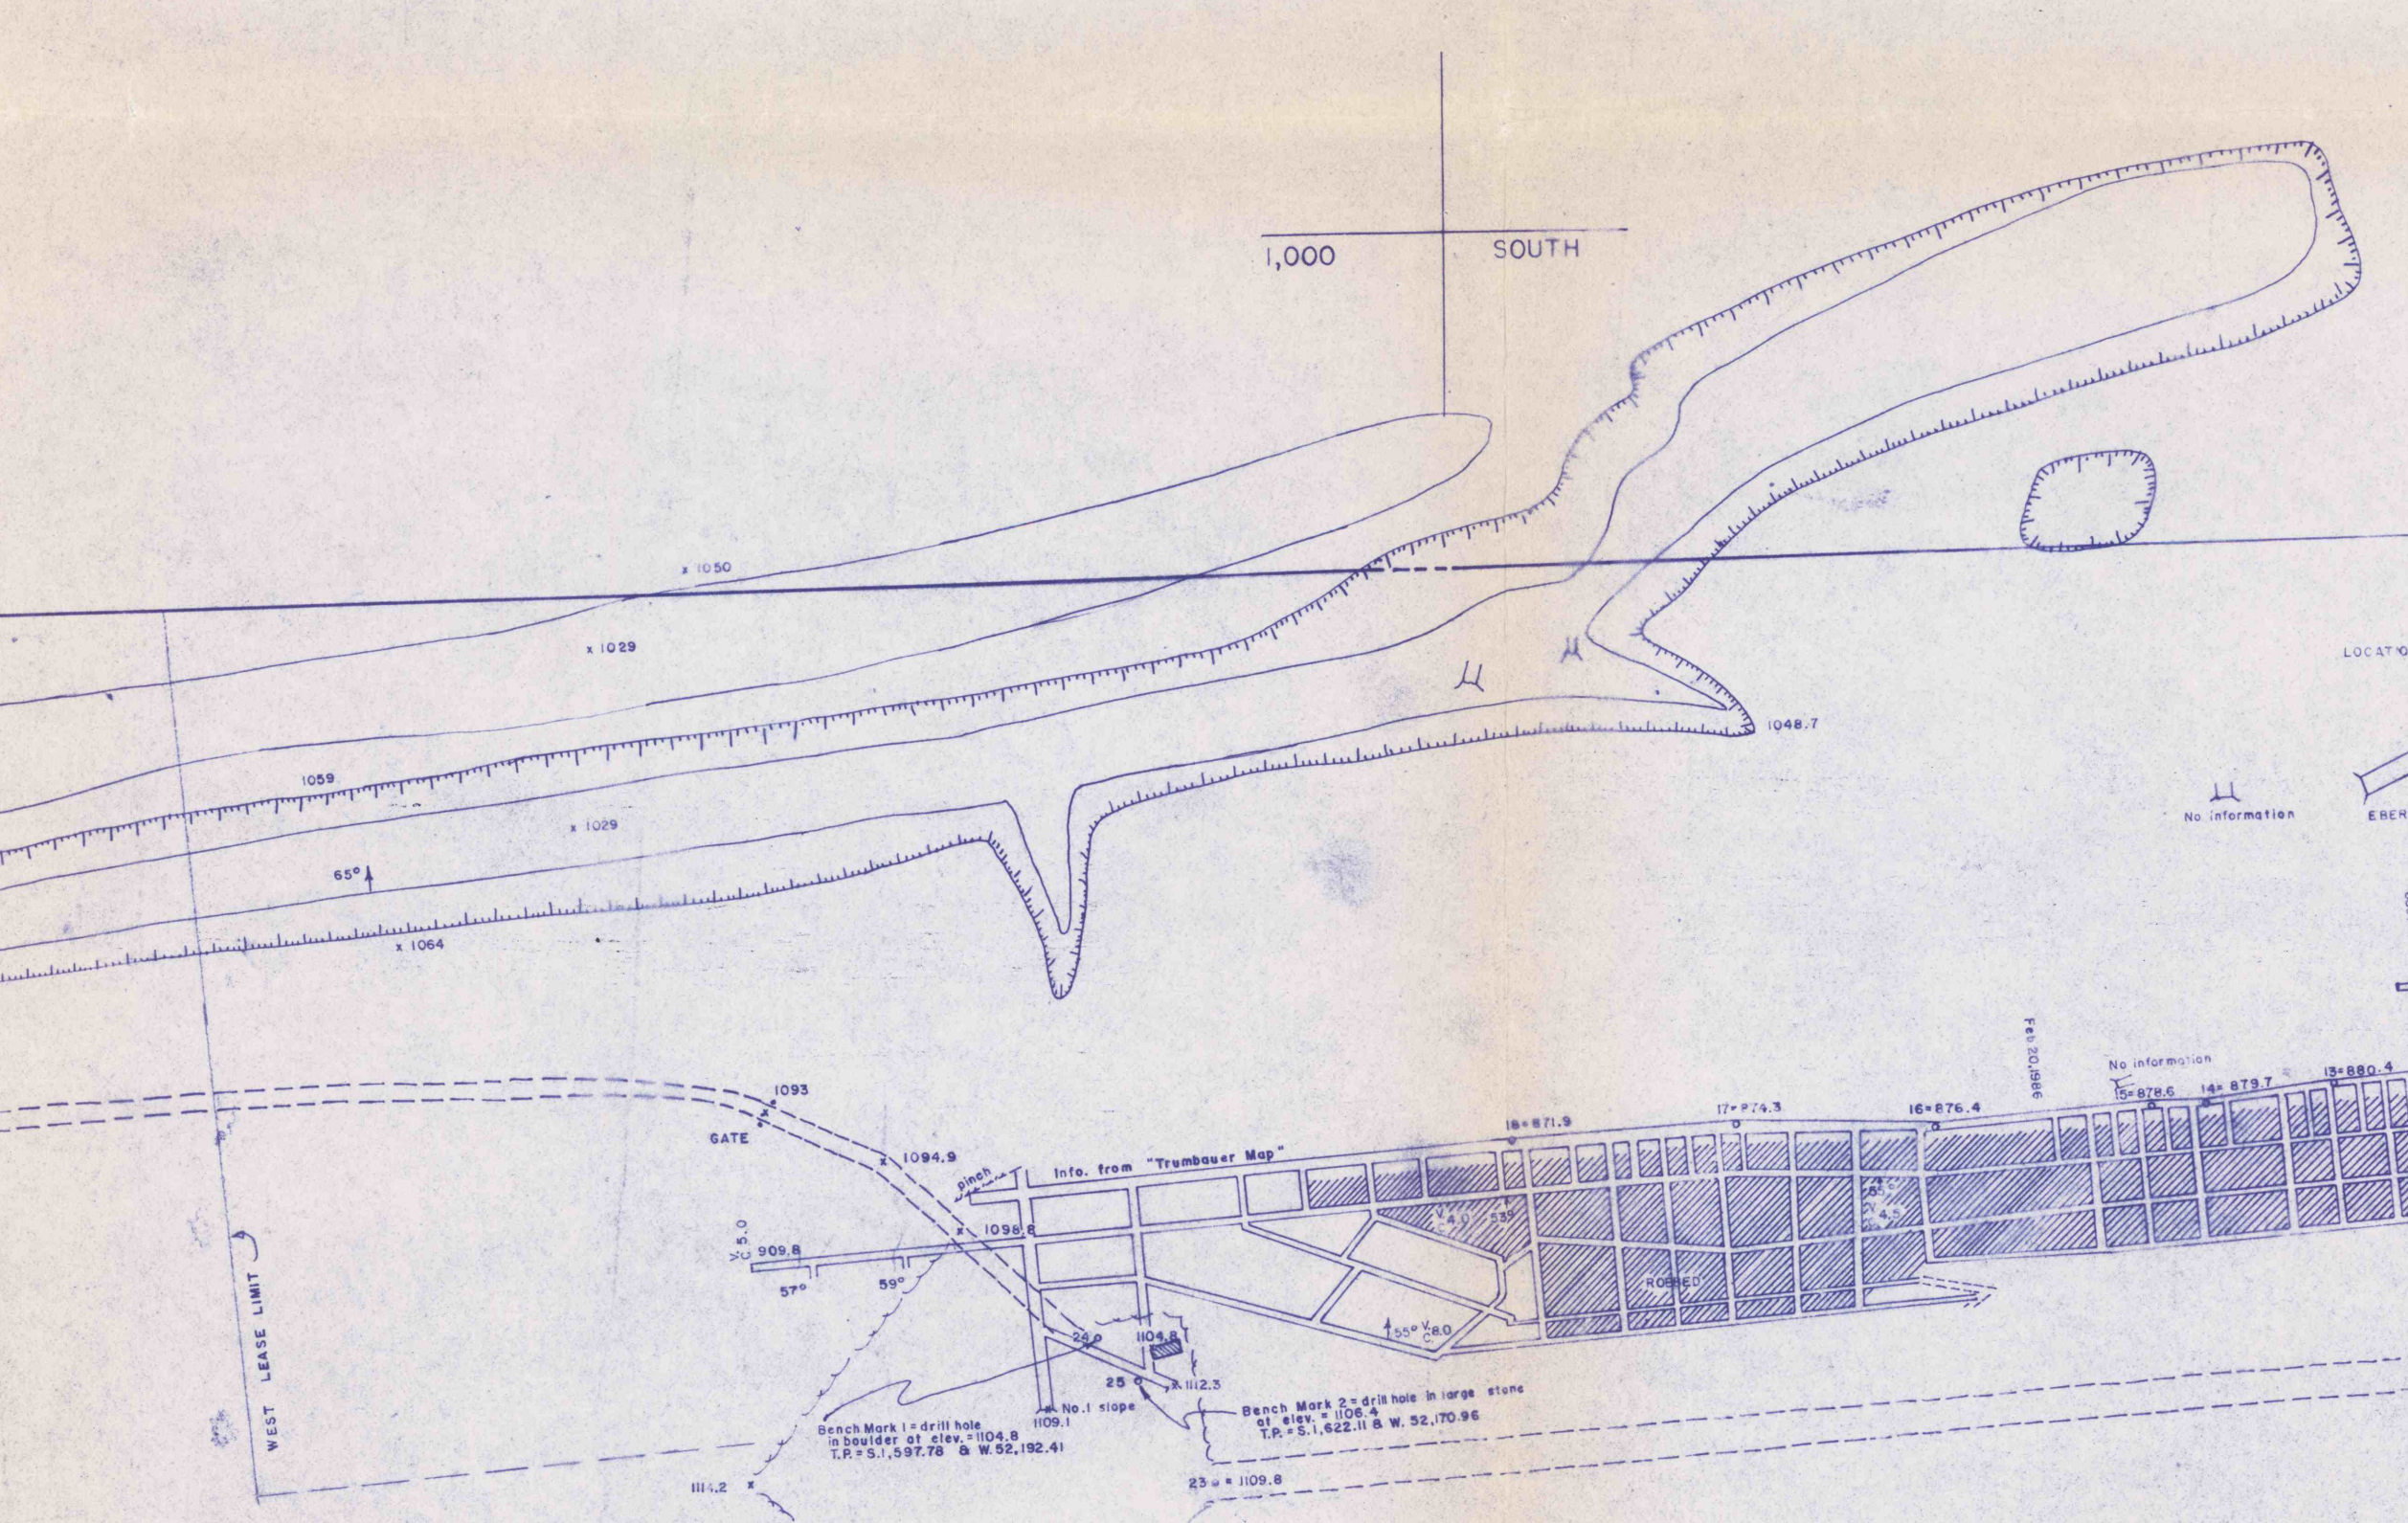

PETER SASSAMAN TRACT

FINAL CLOSURE MAP

Rothermel Coal Company
 R.D.#1 - Box 33A, Klingertown, PA 17941
 No. 8 Vein Slope
 I.D.#36-06415
 Bar Scale: 1" = 100'
 Survey: Aug. 12, 1992
 Posted: Dec. 3, 1992
 POSTED: April 13, 1994
 POSTED: April 5, 1995
 Survey: May 29, 1996
 Posted: Oct. 1, 1997

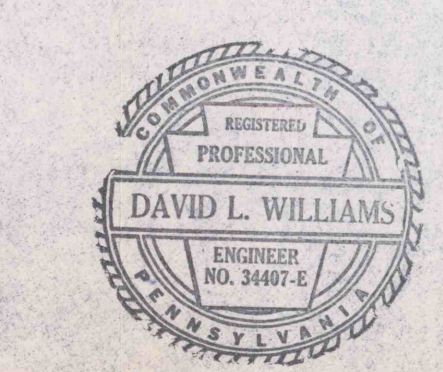


Surveyor's Certification
 I hereby certify that to the best of my knowledge that the areas that I have surveyed are true and correct as to the requirements of 30 CFR Part 75.372. All other information shown has been derived from the best available information but can not be field checked. Therefore, surveyor makes no certification to their accuracy.

David L. Williams
 David L. Williams, P.E.

Mine Operator's Certification
 I depose and say that the mine ventilation information shown on this map meets the requirement of 30 CFR Part 75.372 and was prepared by me or under my direction for which I accept full responsibility.

Rudolf Rothermel
 Mine Foreman

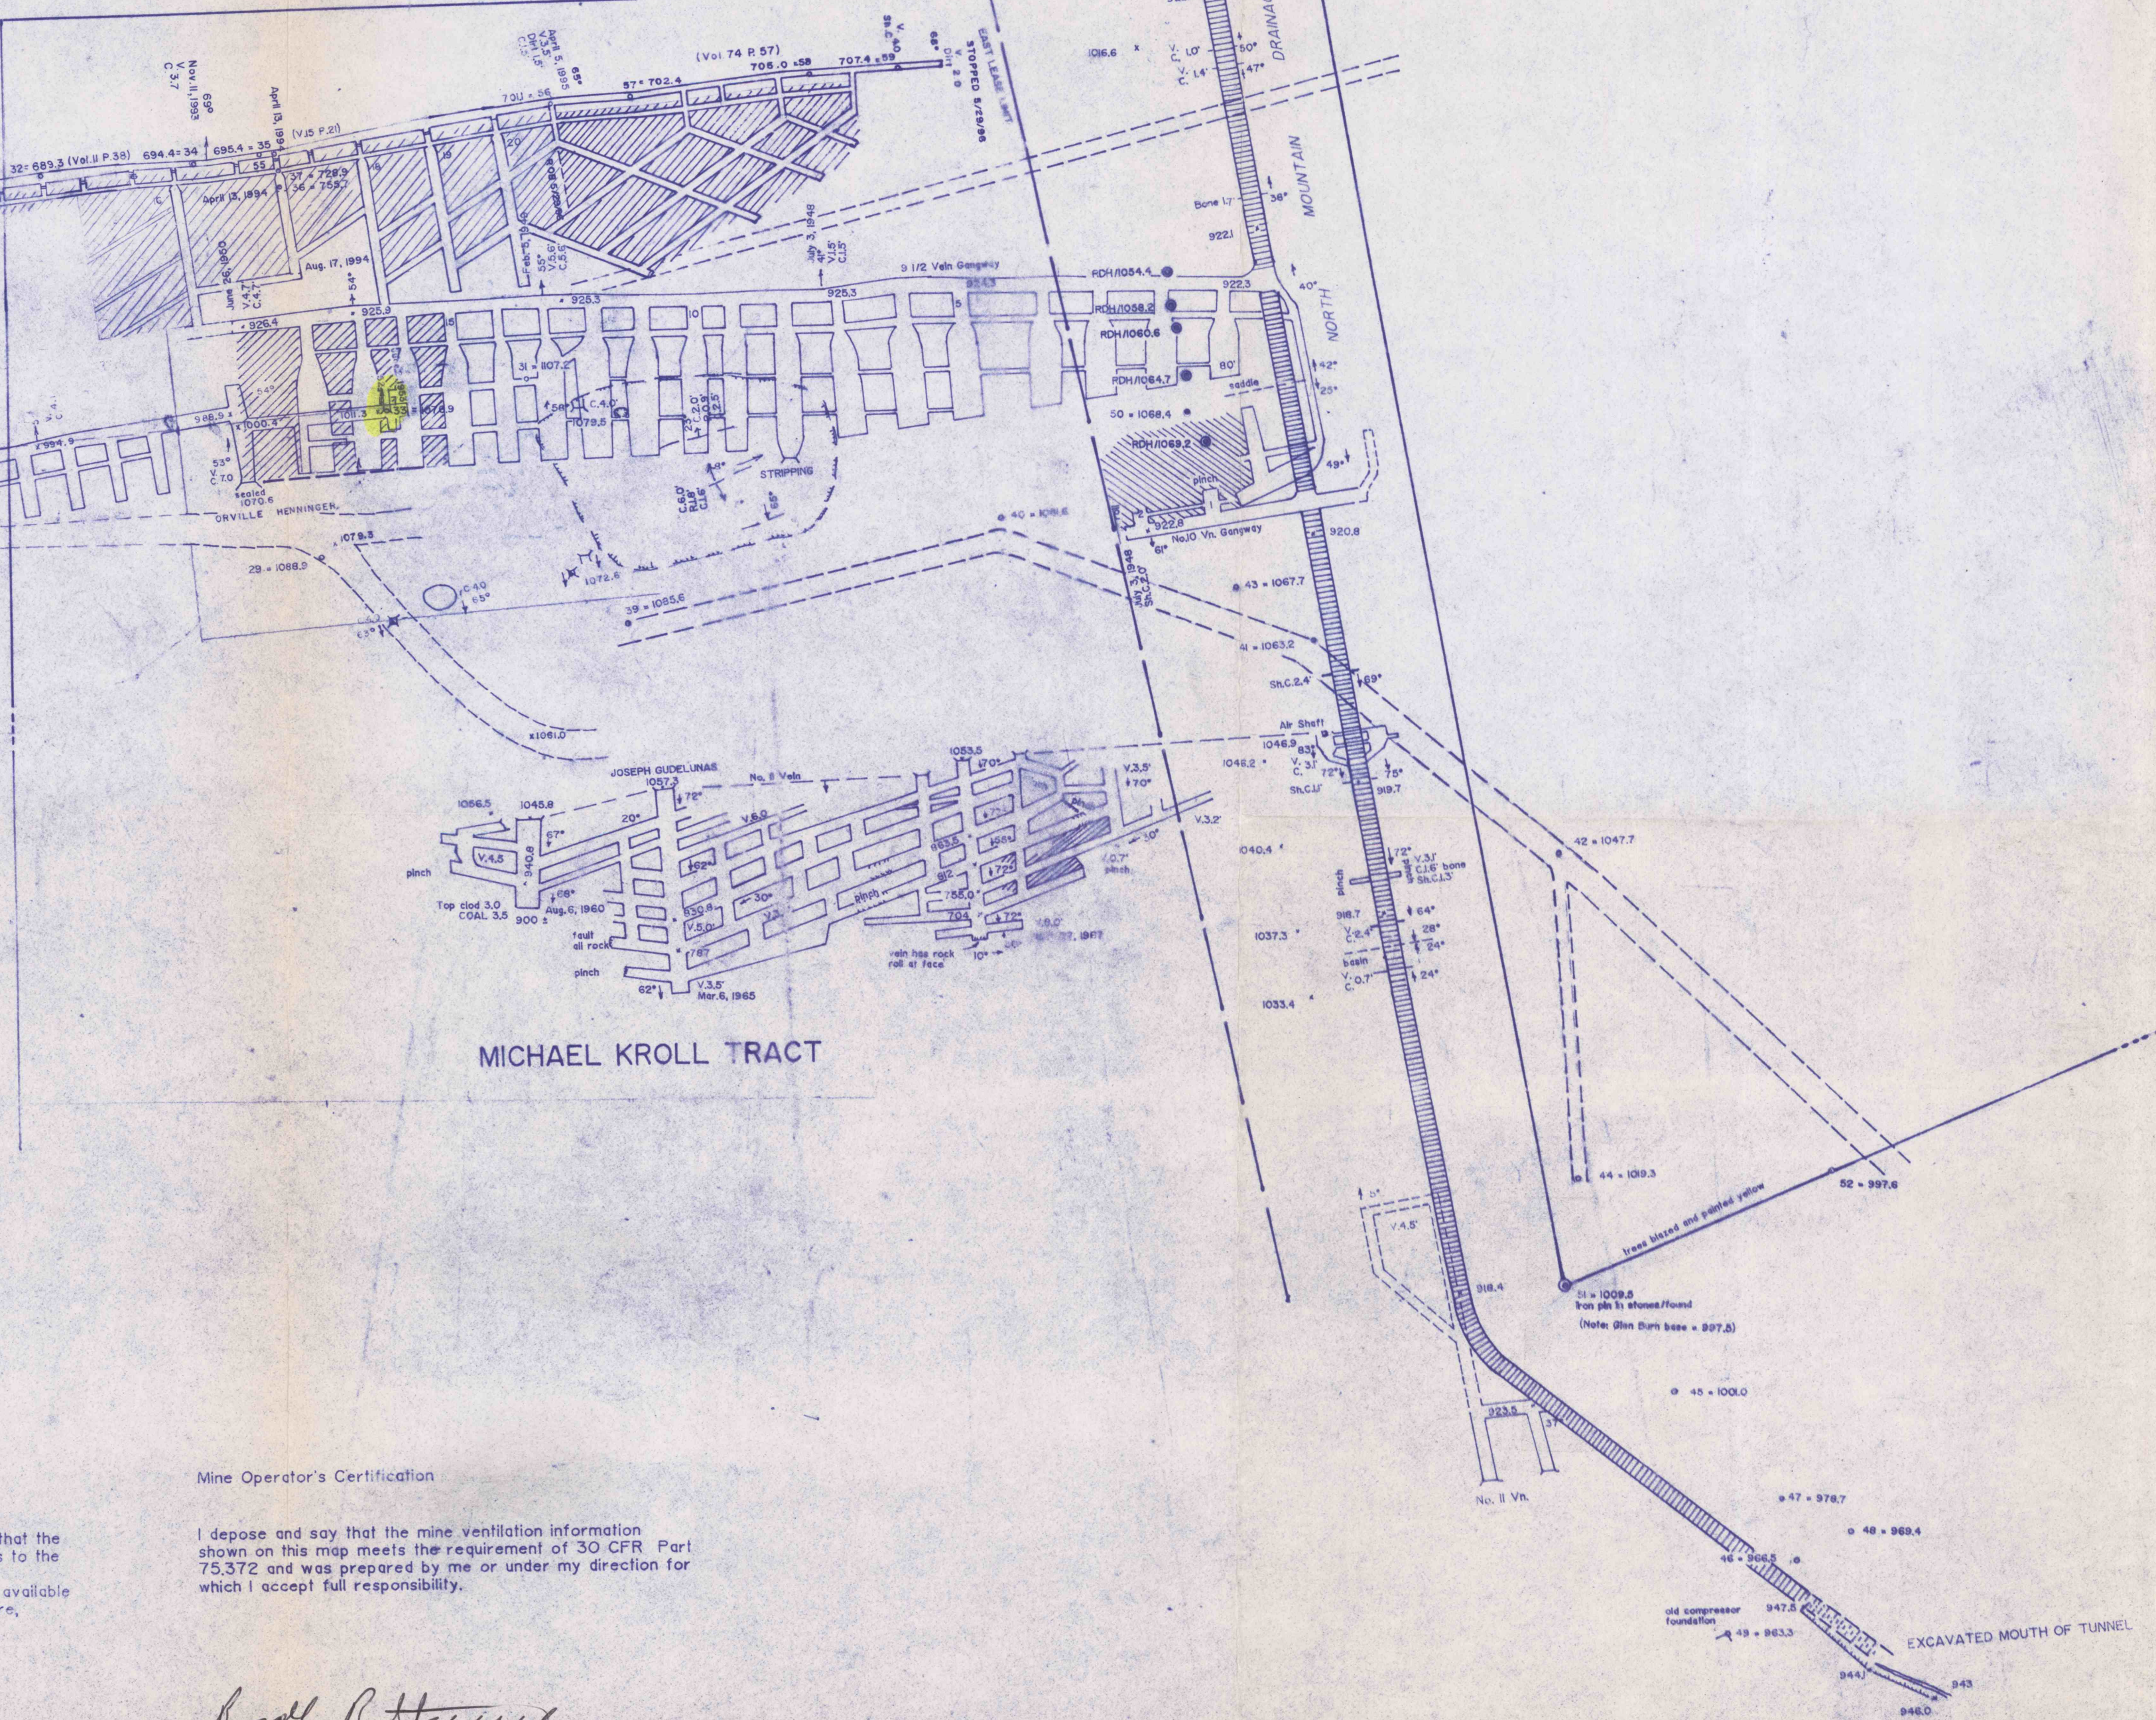

MICHAEL KROLL TRACT