


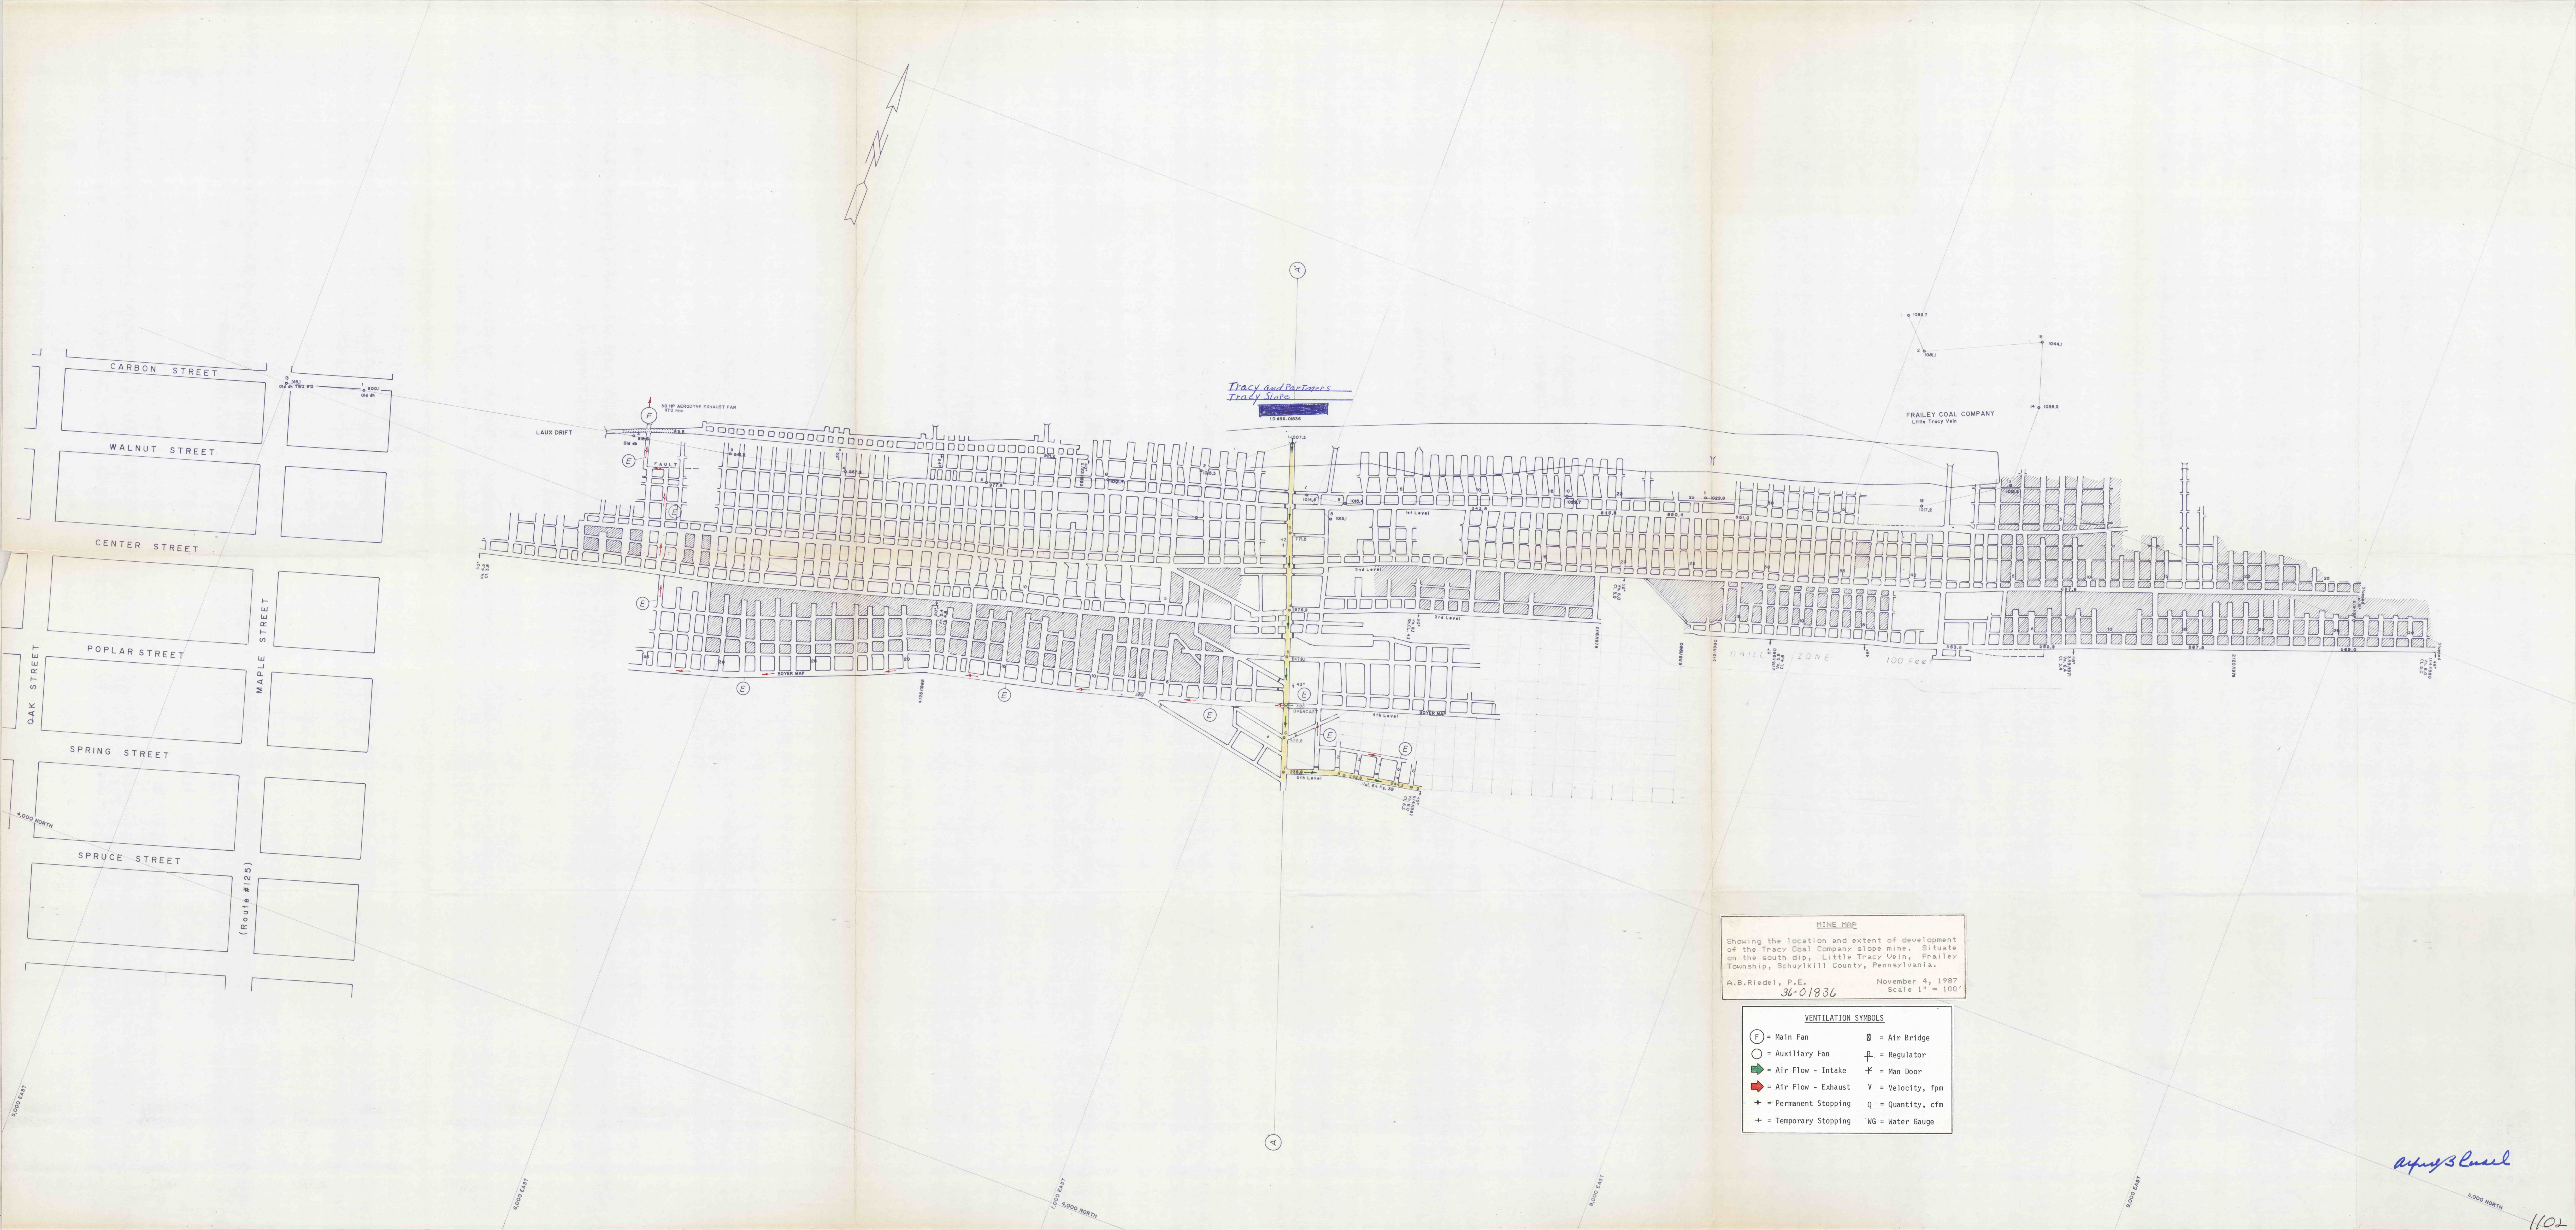

Tracy and Partners
Tracy Slope

FRAILEY COAL COMPANY
Little Tracy Vein

MINE MAP
Showing the location and extent of development
of the Tracy Coal Company slope mine. Situate
on the south dip, Little Tracy Vein, Frailey
Township, Schuylkill County, Pennsylvania.
A.B. Riedel, P.E. November 4, 1987
36-01836 Scale 1" = 100'

VENTILATION SYMBOLS			
(F) = Main Fan	(B) = Air Bridge	(R) = Regulator	(M) = Man Door
(A) = Auxiliary Fan	(I) = Air Flow - Intake	(V) = Velocity, fpm	(Q) = Quantity, cfm
(E) = Air Flow - Exhaust	(P) = Permanent Stopping	(T) = Temporary Stopping	(WG) = Water Gauge

A.B. Riedel