


[REDACTED] COAL COMPANY
 FRAILEY TWP - SCHUYLKILL COUNTY - PA.
 MINE I D No 36-01836

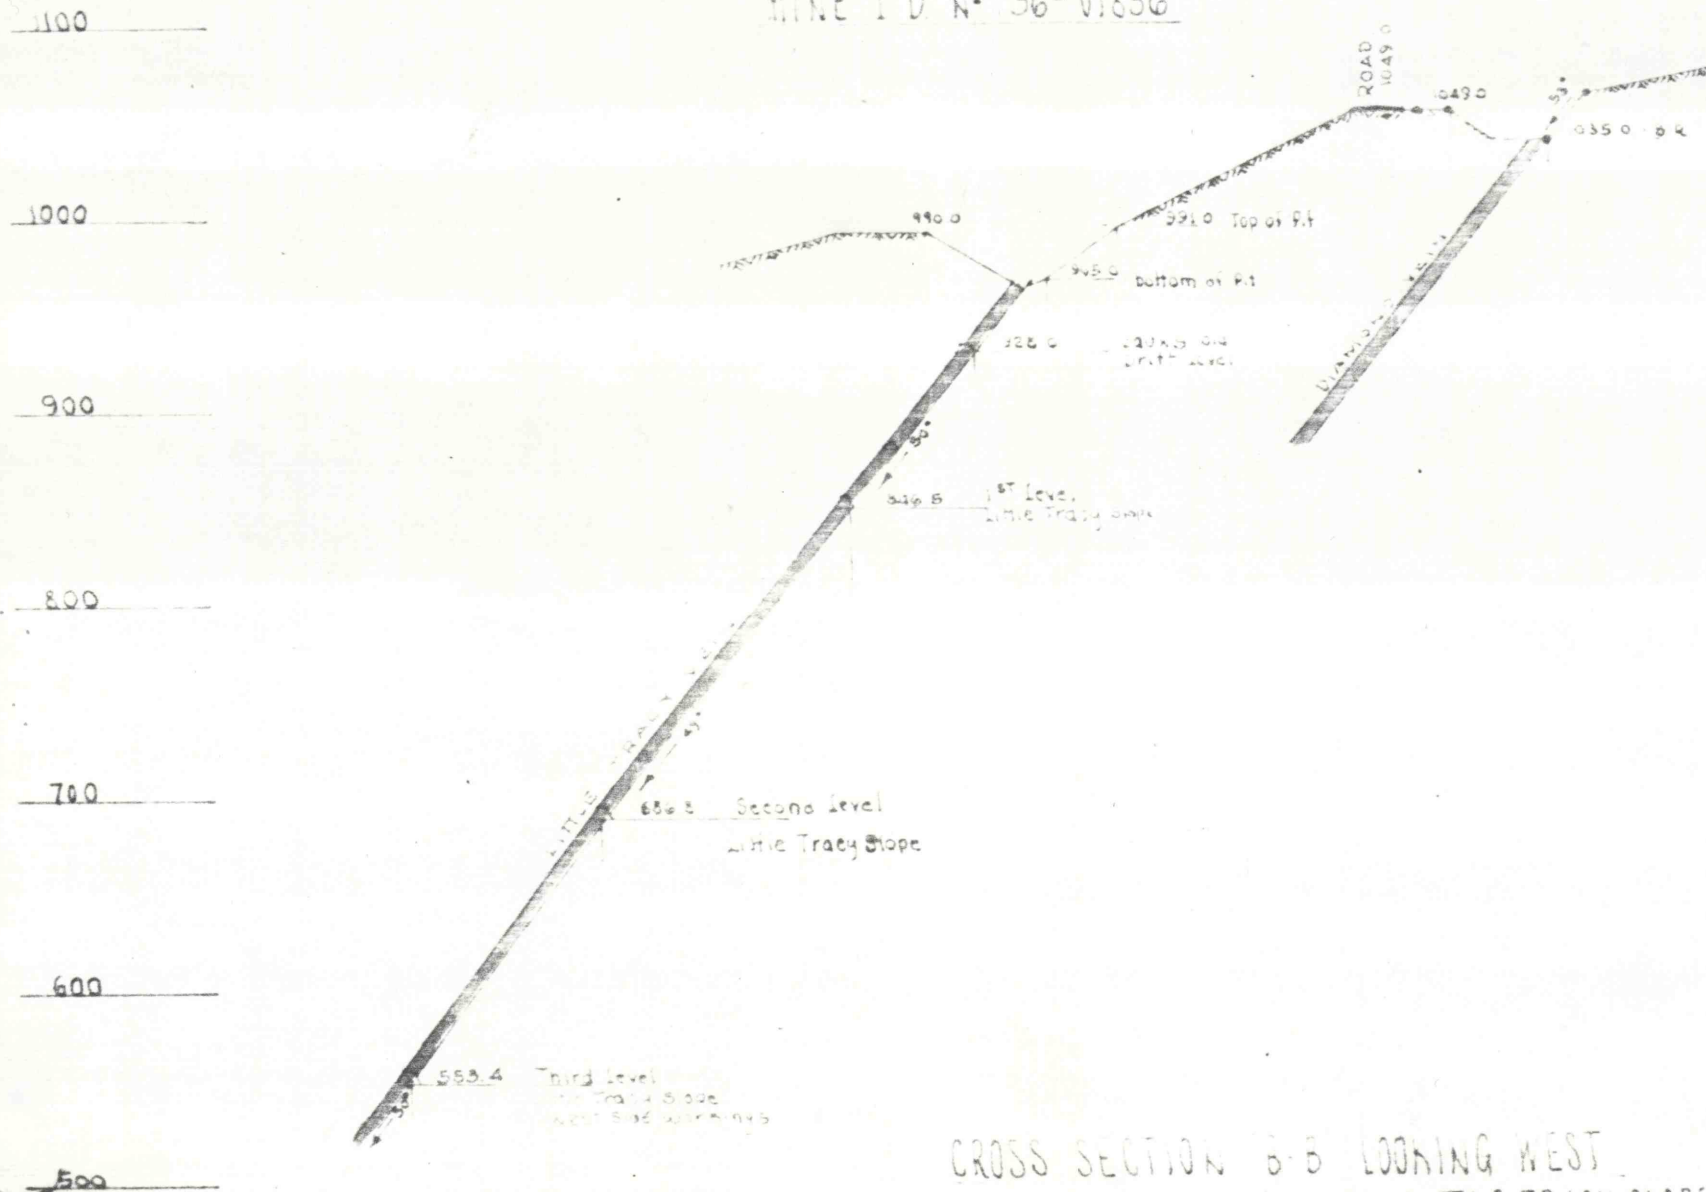

CROSS SECTION B-B LOOKING WEST
 THRU No 13 BREAST 3rd LEVEL LITTLE TRACY SLOPE
 WEST SIDE
 Scale 1" = 100' Hor & Vert

Jan. 14, 1980

1603