
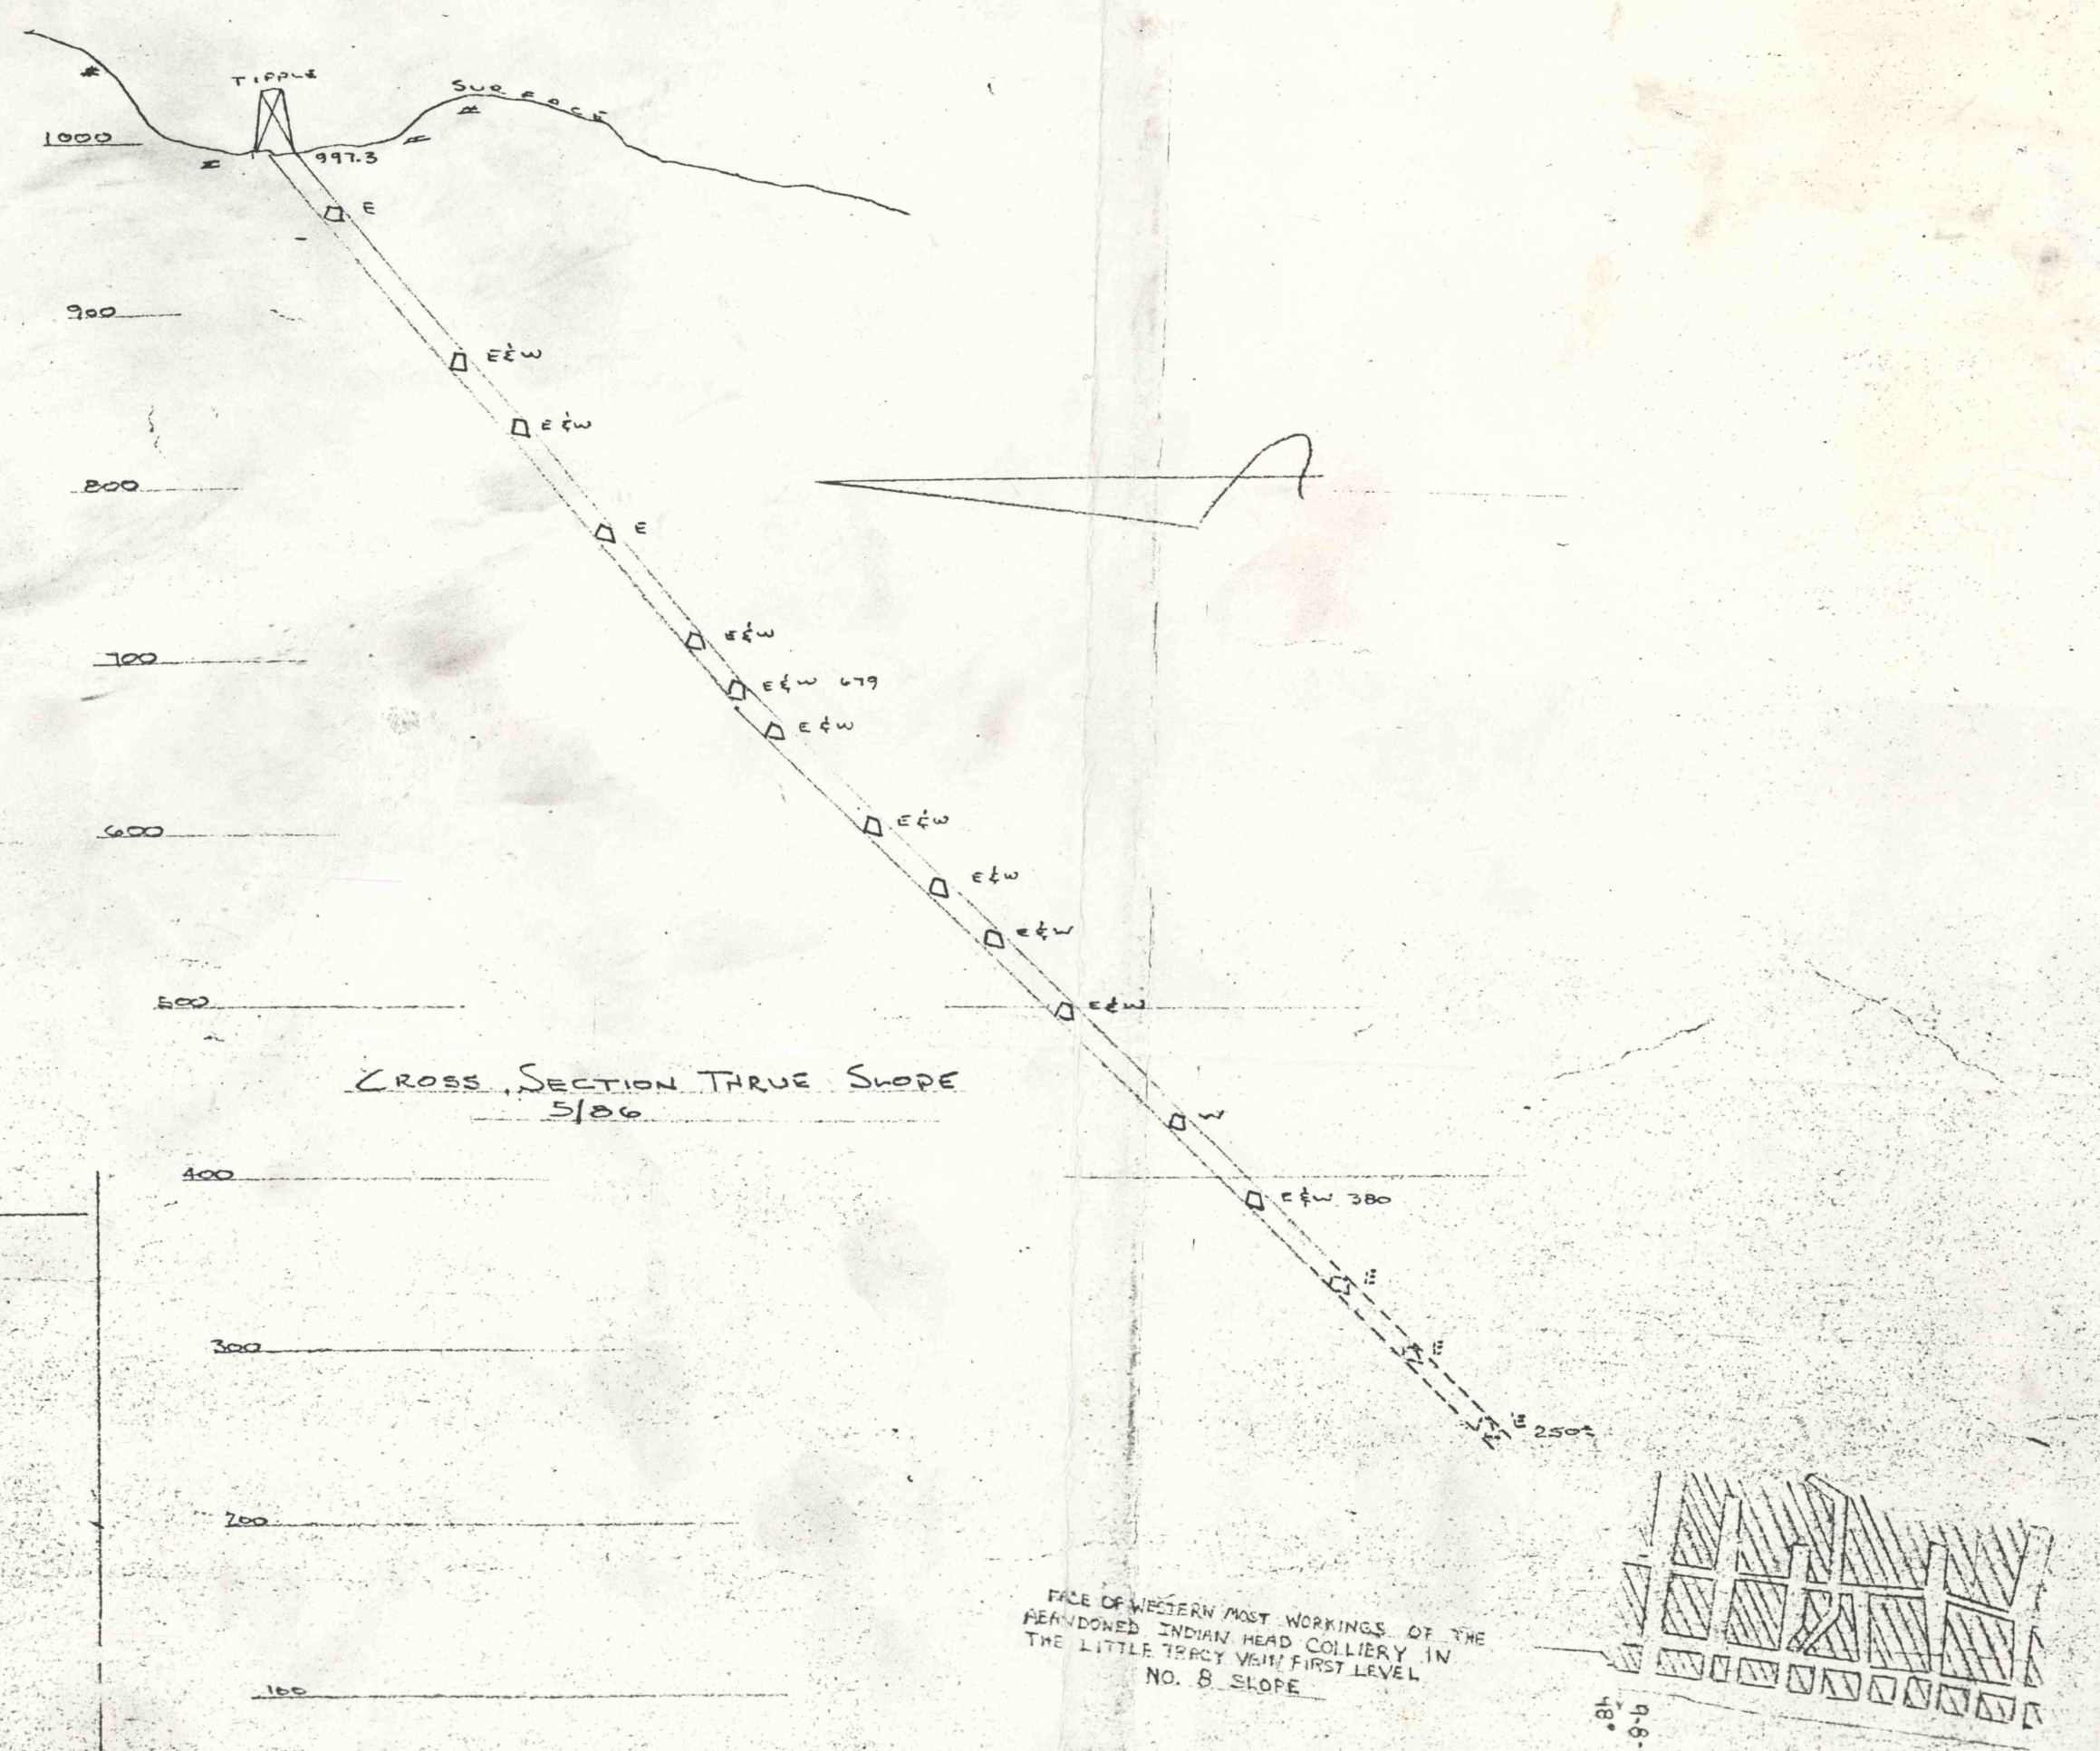


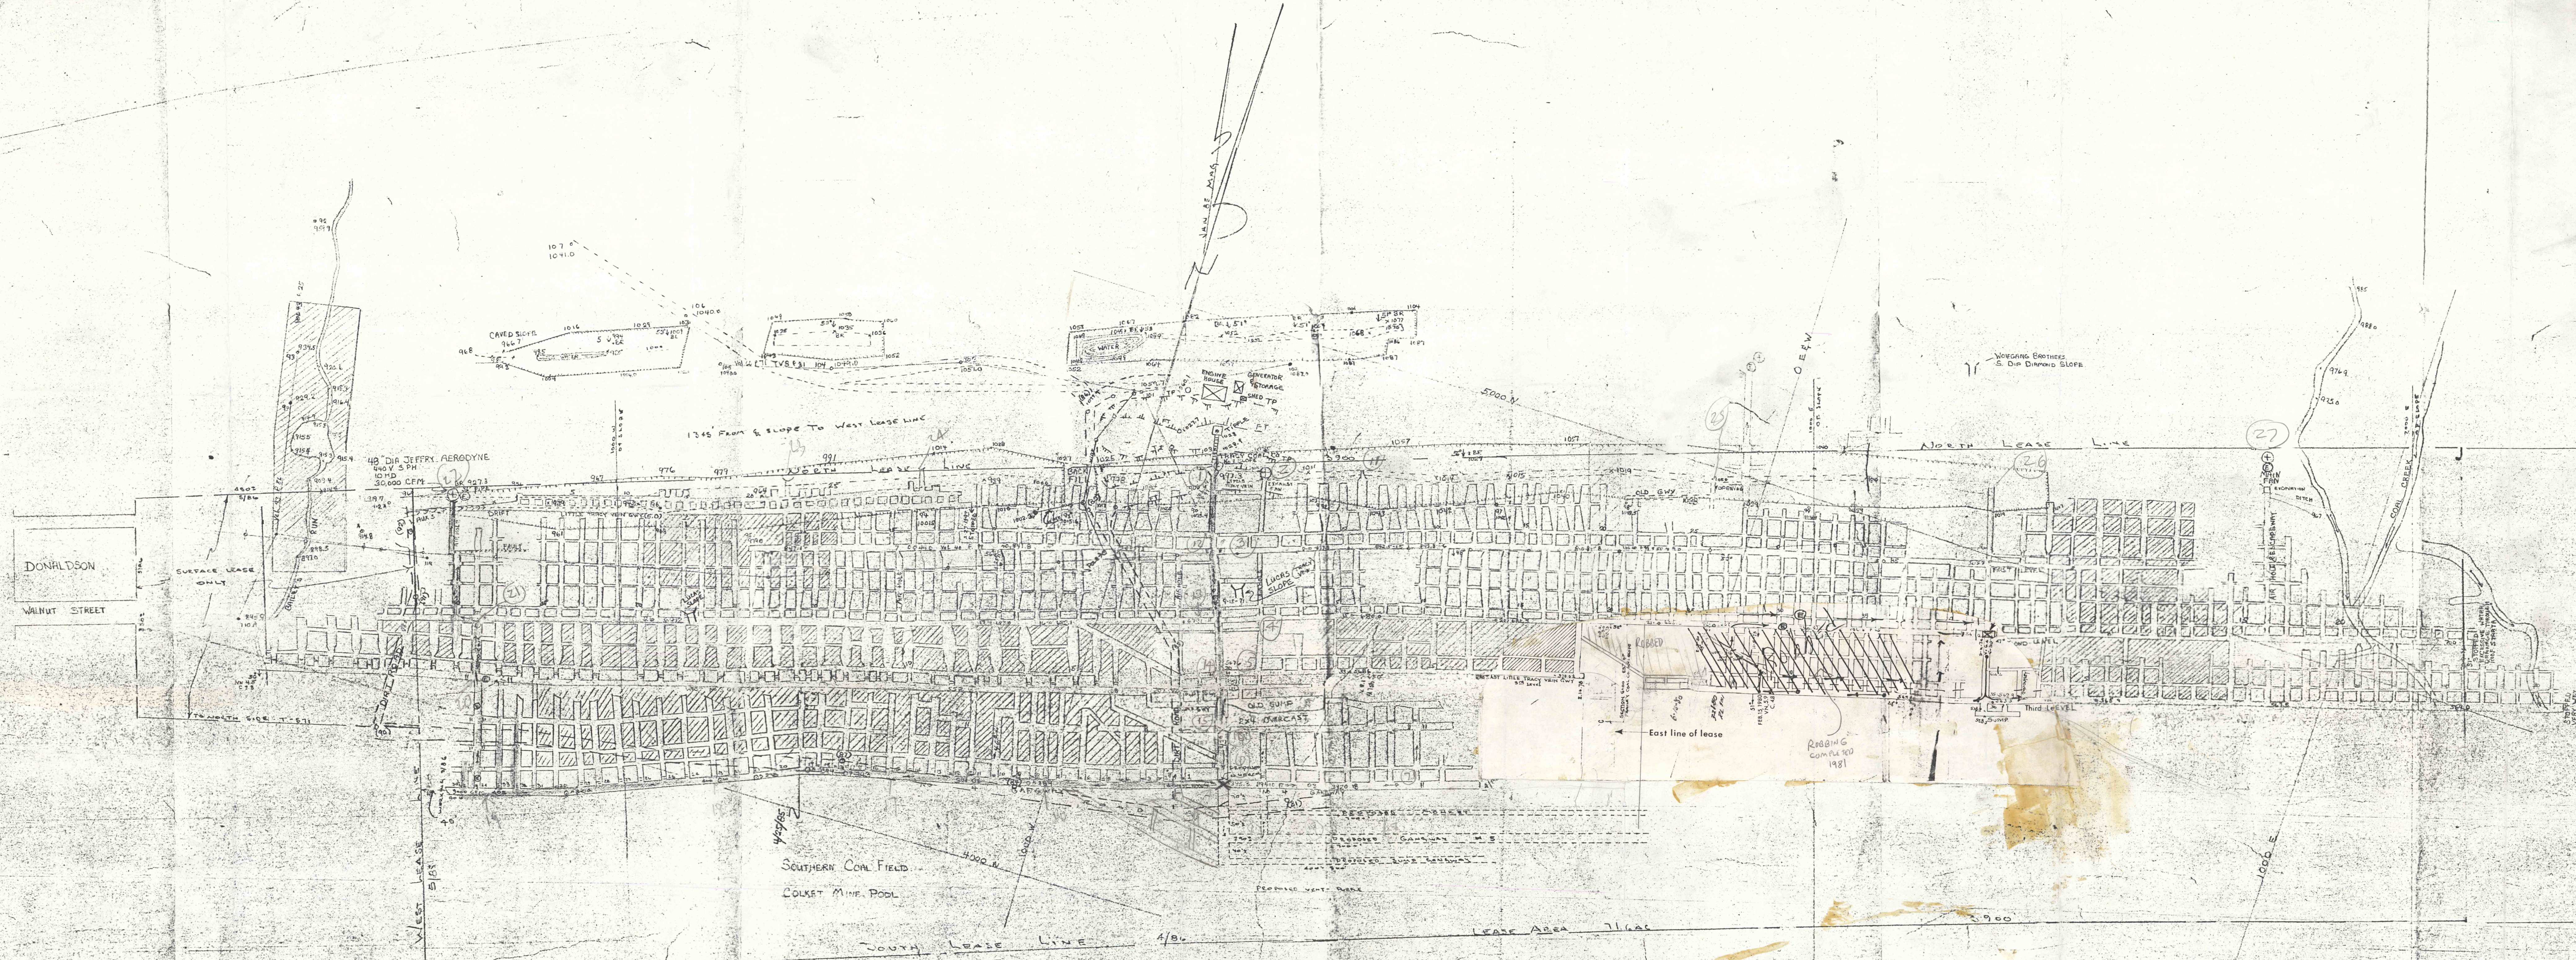

MAP REFERENCES
0154 SC STEVEN C. BOYER
92202 WAGNER ASSC
FRT. 102 FIDLER & SLANE

LEGEND
1. LEASE LINE
2. UPGRADE
3. ...

REVISION
1. LEASE LINE 5/85
2. UPGRADE 5/85

	STEVEN C. BOYER HESING, PA. 682-3756	
	PARLEY TWP. SCHUYLKILL COUNTY PENNSYLVANIA	
	I & C COAL 70" 36-0836	
	ISSUE DATE: 4-16-85	DATE: 4-16-85
SCALE: 1" = 100'	CHKD. BY: Y.W.	ORDER NO.:
DWG. NO.:	DEPT. NO.:	DWG. NO.:
PROJ. MGR.:		015