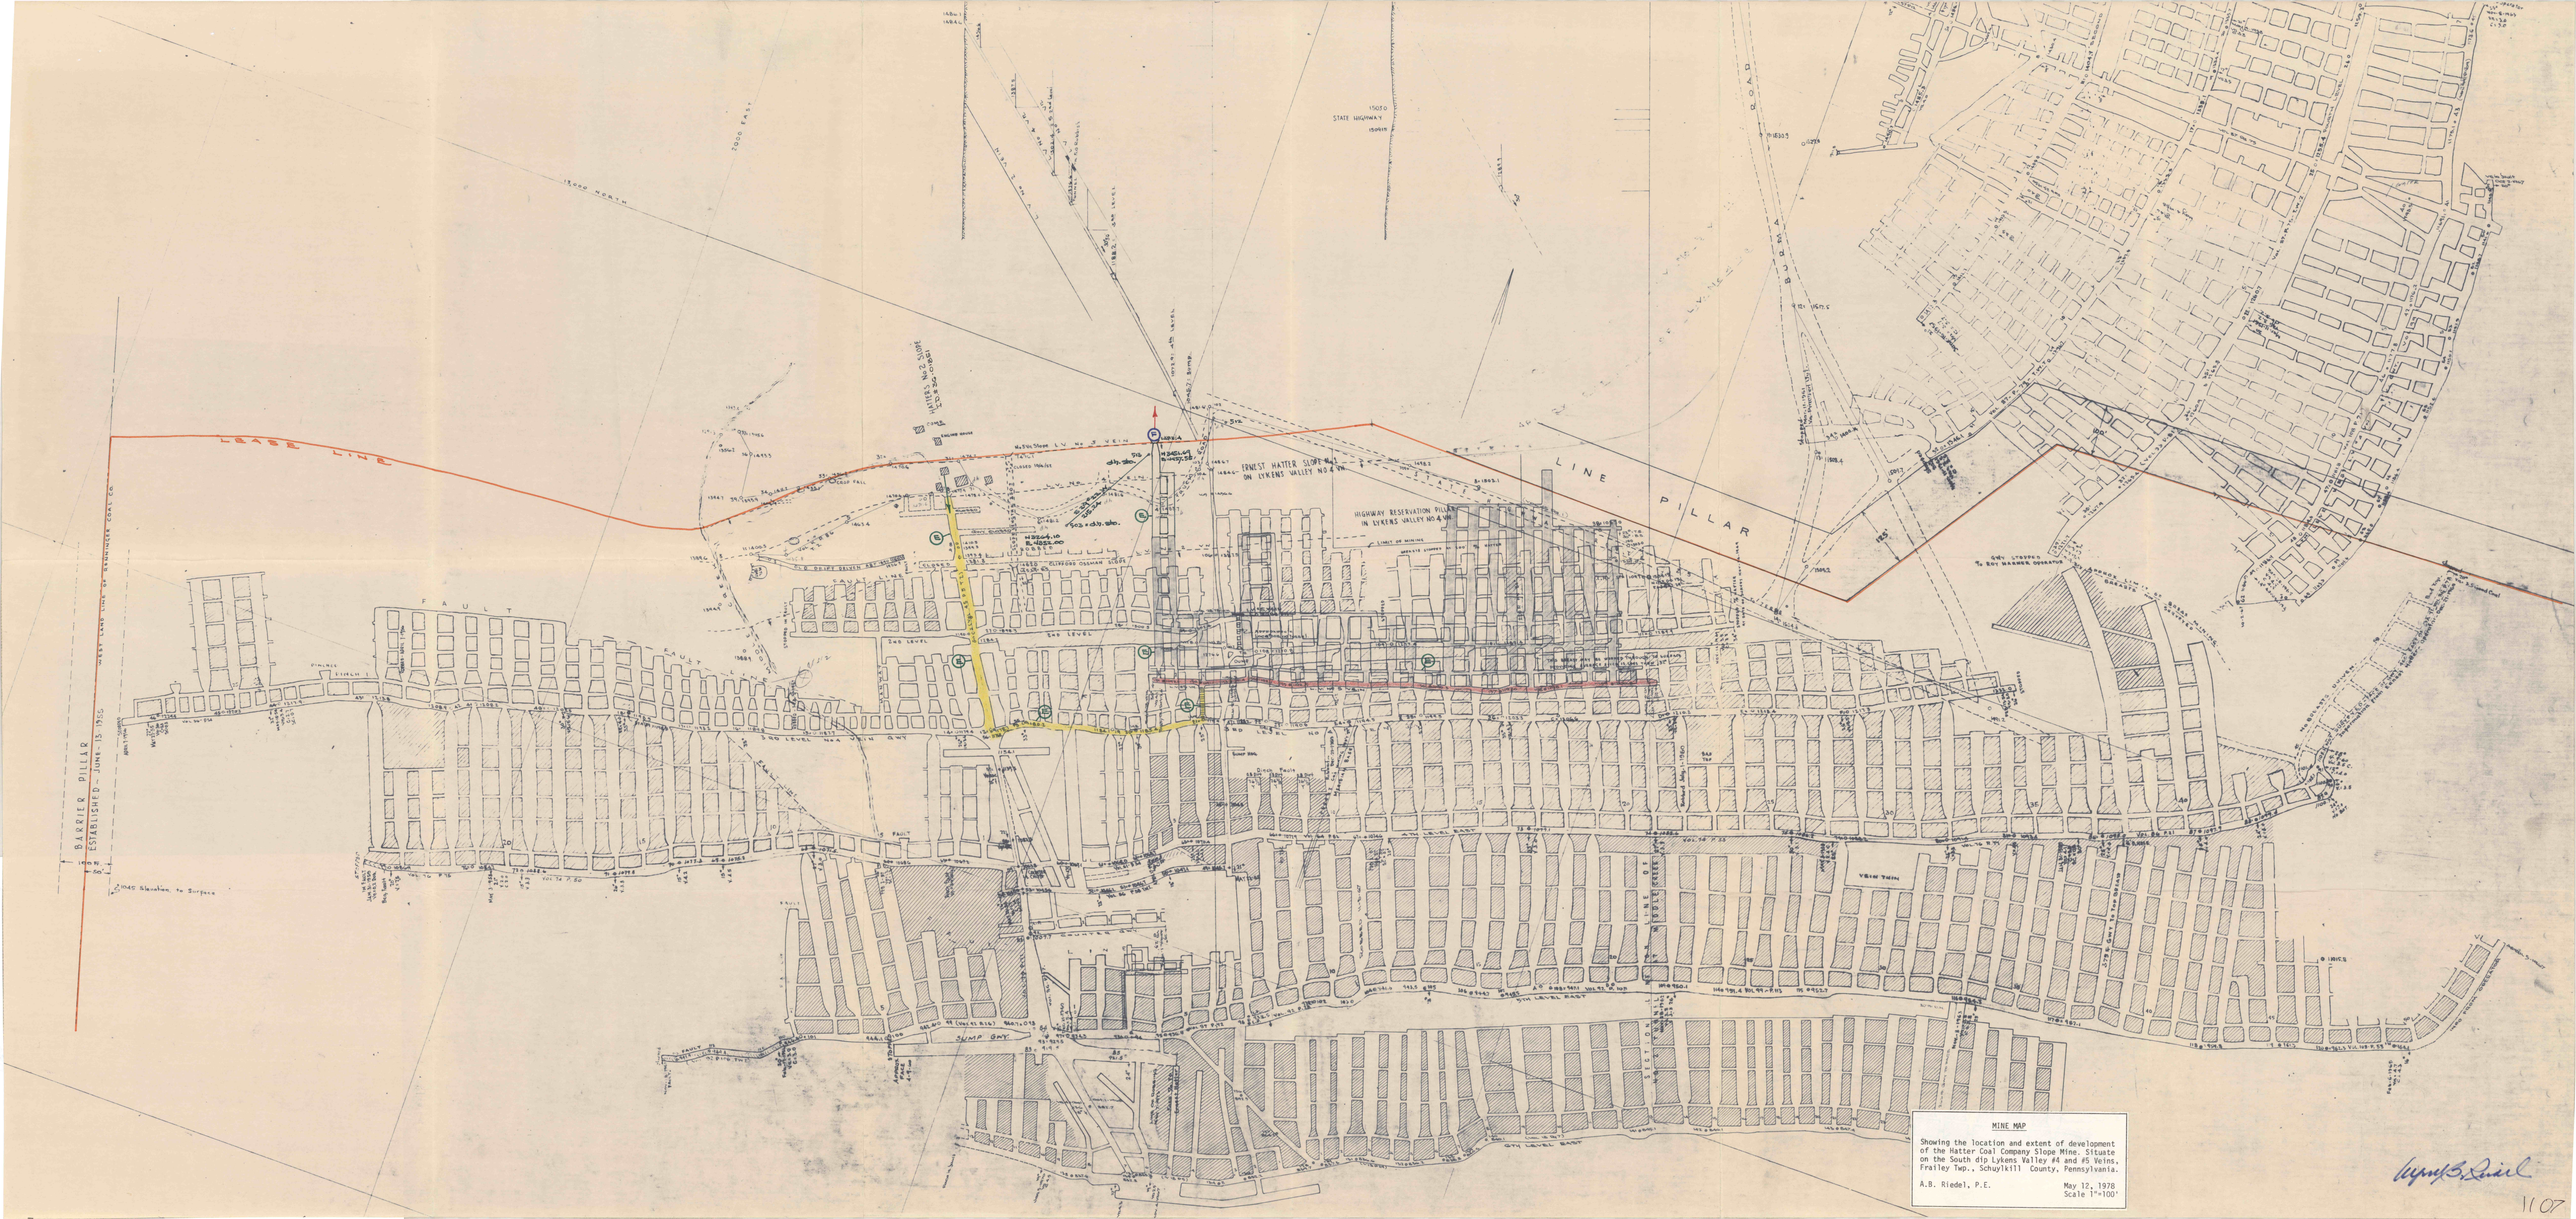

MINE MAP

Showing the location and extent of development of the Hatter Coal Company Slope Mine. Situate on the South dip Lykens Valley #4 and #5 Veins, Frailey Twp., Schuylkill County, Pennsylvania.

A.B. Riedel, P.E.

May 12, 1978
Scale 1"=100'

1107