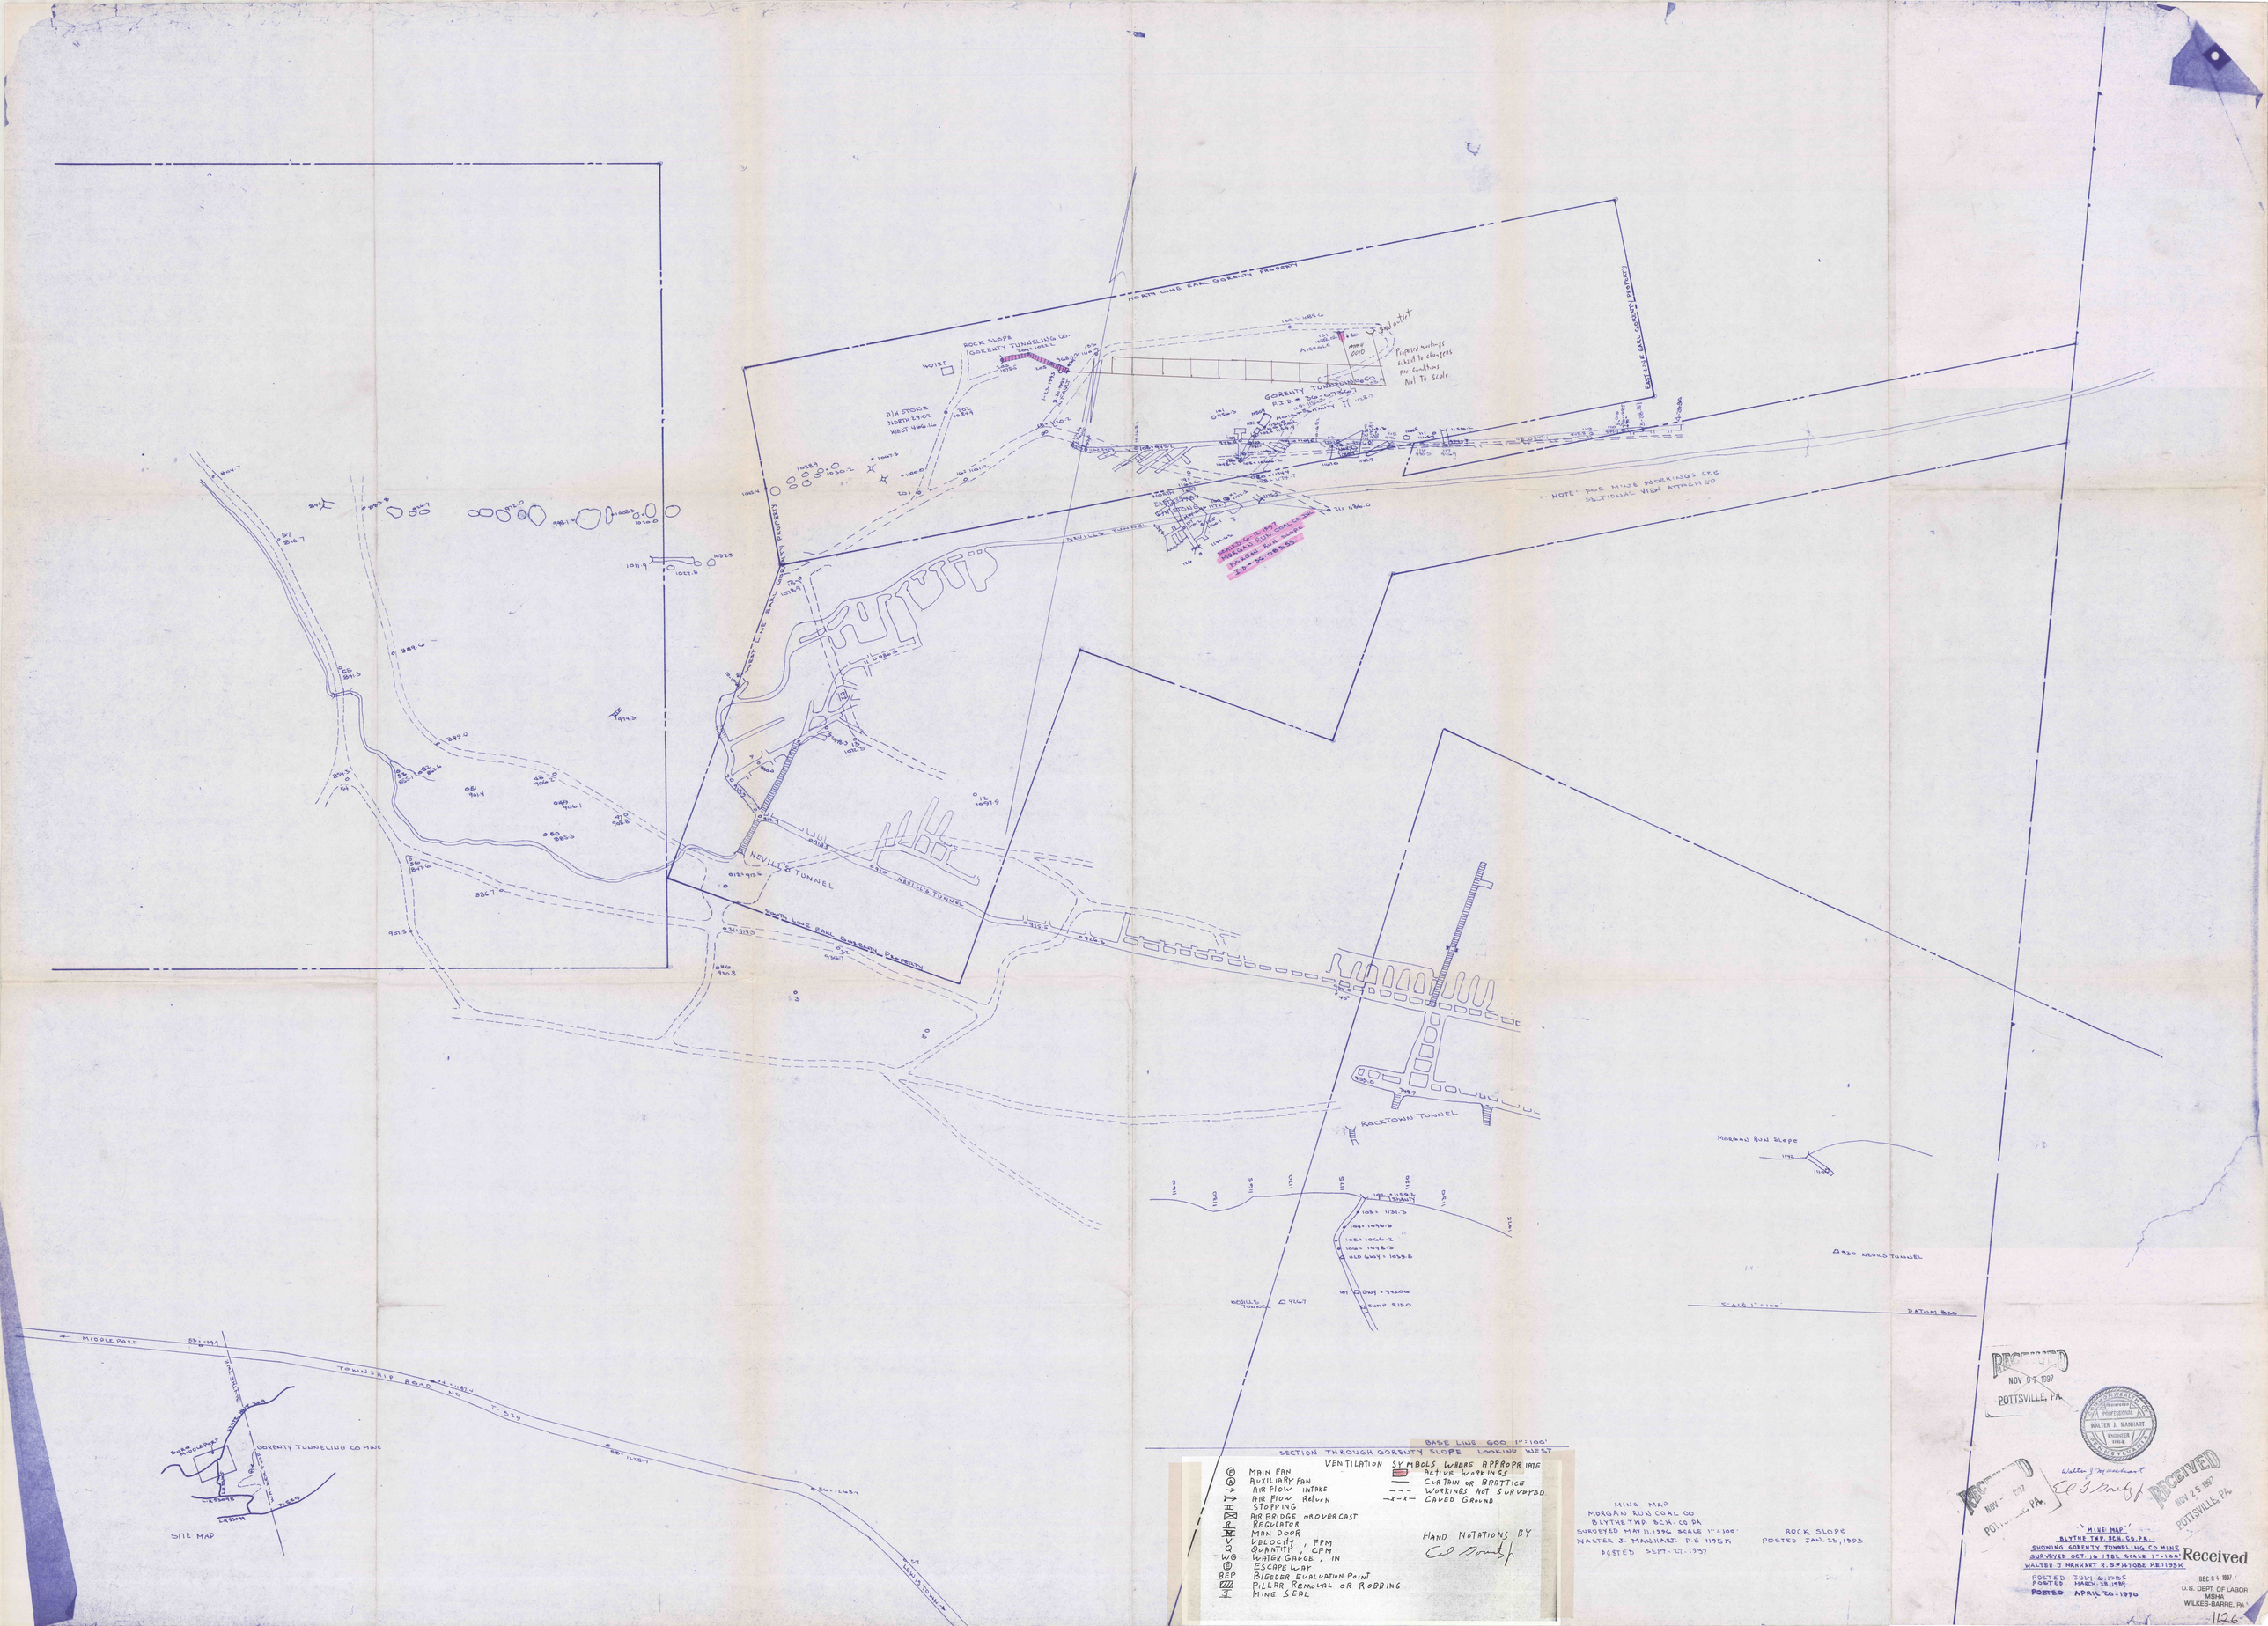
NO MIN LINE EARL GORENTY PROPERTY
EAST LINE EARL GORENTY PROPERTY
WEST LINE EARL GORENTY PROPERTY
SOUTH LINE EARL GORENTY PROPERTY
ROCK SLOPE
GORENTY TUNNELING CO.
HOIST
DIP STONE
NORTH 1296.0
WEST 1496.16
AIRVALE
Pad outlet
Proposed workings subject to changes per conditions
Not To Scale
GORENTY TUNNELING CO.
N.E.D. = 36-00-1962
HOIST-GORENTY
NOTE: FOR MINE WORKINGS SEE SECTIONAL VIEW ATTACHED
NEVILLE TUNNEL
ROCKTOWN TUNNEL
MORGAN RUN SLOPE
NEVILLE TUNNEL
SCALE 1" = 100'
DATUM 800
MIDDLE PORT
TOWNSHIP ROAD NO. T-529
GORENTY TUNNELING CO MINE
SITE MAP
BASE LINE 600 1" = 100'
SECTION THROUGH GORENTY SLOPE LOOKING WEST
VENTILATION SYMBOLS WHERE APPROPRIATE
MAIN FAN
AUXILIARY FAN
AIR FLOW INTAKE
AIR FLOW RETURN
STOPPING
AIR BRIDGE OVERCAST
REGULATOR
MAN DOOR
VELOCITY, FPM
QUANTITY, CFM
WATER GAUGE, IN
ESCAPE WAY
BIEDDER EVALUATION POINT
PILLAR REMOVAL OR ROBBING
MINE SEAL
ACTIVE WORKINGS
CURTAIN OR BRATTICE
WORKINGS NOT SURVEYED
CAVED GROUND
HAND NOTATIONS BY
Ed Smith
MINE MAP
MORGAN RUN COAL CO
BLYTHE TWP. SCH. CO. PA
SURVEYED MAY 11, 1996 SCALE 1" = 100'
WALTER J. MANHART P.E 11953K
POSTED SEPT. 27, 1997
ROCK SLOPE
POSTED JAN. 23, 1993
RECEIVED
NOV 07 1997
POTTSVILLE, PA.
WALTER J. MANHART
PROFESSIONAL ENGINEER
11953-E
Walter J. Manhart
RECEIVED
NOV 25 1997
POTTSVILLE, PA.
MINE MAP
BLYTHE TWP. SCH. CO. PA.
SHOWING GORENTY TUNNELING CO MINE
SURVEYED OCT. 16 1982 SCALE 1" = 100'
WALTER J MANHART R. S. # 11953E PE 11953K
POSTED JULY 6, 1985
POSTED MARCH 28, 1991
POSTED APRIL 20, 1990
Received
DEC 04 1997
U.S. DEPT. OF LABOR
MSHA
WILKES-BARRE, PA.
1126