

Mine Foreman's Certification

I depose and say that the mine ventilation information shown on this map meets the requirements of 30 CFR Part 75.372 and was prepared by me or under my direction for which I accept full responsibility.


James Lewis
Mine Foreman

Surveyor's Certification

I hereby certify that to the best of my knowledge that the areas that I have surveyed are true and correct as to the requirements of 30 CFR Part 75.200. All other information shown has been derived from the best available information but can not be field checked. Therefore, surveyor makes no certification to their accuracy.

David L. Williams
David L. Williams, P.E.

Ventilation Symbols (where applicable)	
(F)	Main Fan
(A)	Auxiliary Fan
—	Air Flow - Intake
—	Air Flow - Return
—	Stopping
—	Overcast
R	Regulator
—	Man Door
Q	Quantity, cfm
wg	Water Gauge, in.
(E)	Escapeway
BEP	Bleeder Evaluation Point
■	Pillar Removal
—	Mine Seal
—	Active Workings
—	Curtain or Brattice
---	Workings Not Surveyed
---	Caved Ground

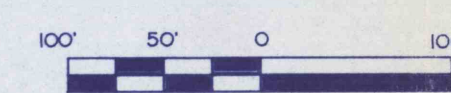

Note: no changes in No. 2 Vein Workings since survey of May 10, 1995

MINE MAP
of the
WEST CAMERON MINING #0 VEIN WORKINGS
situate in
West Cameron Twp., Northumberland County