




MINE MAP
FOSTER TWP. SCH. CO. PA.
SHOWING MINE WORKS OF
NICK DEMINSKY
MAY-1-79 1001001
WALTER J. MANHART R.S. #14708E
Nick Deminski
36-01252

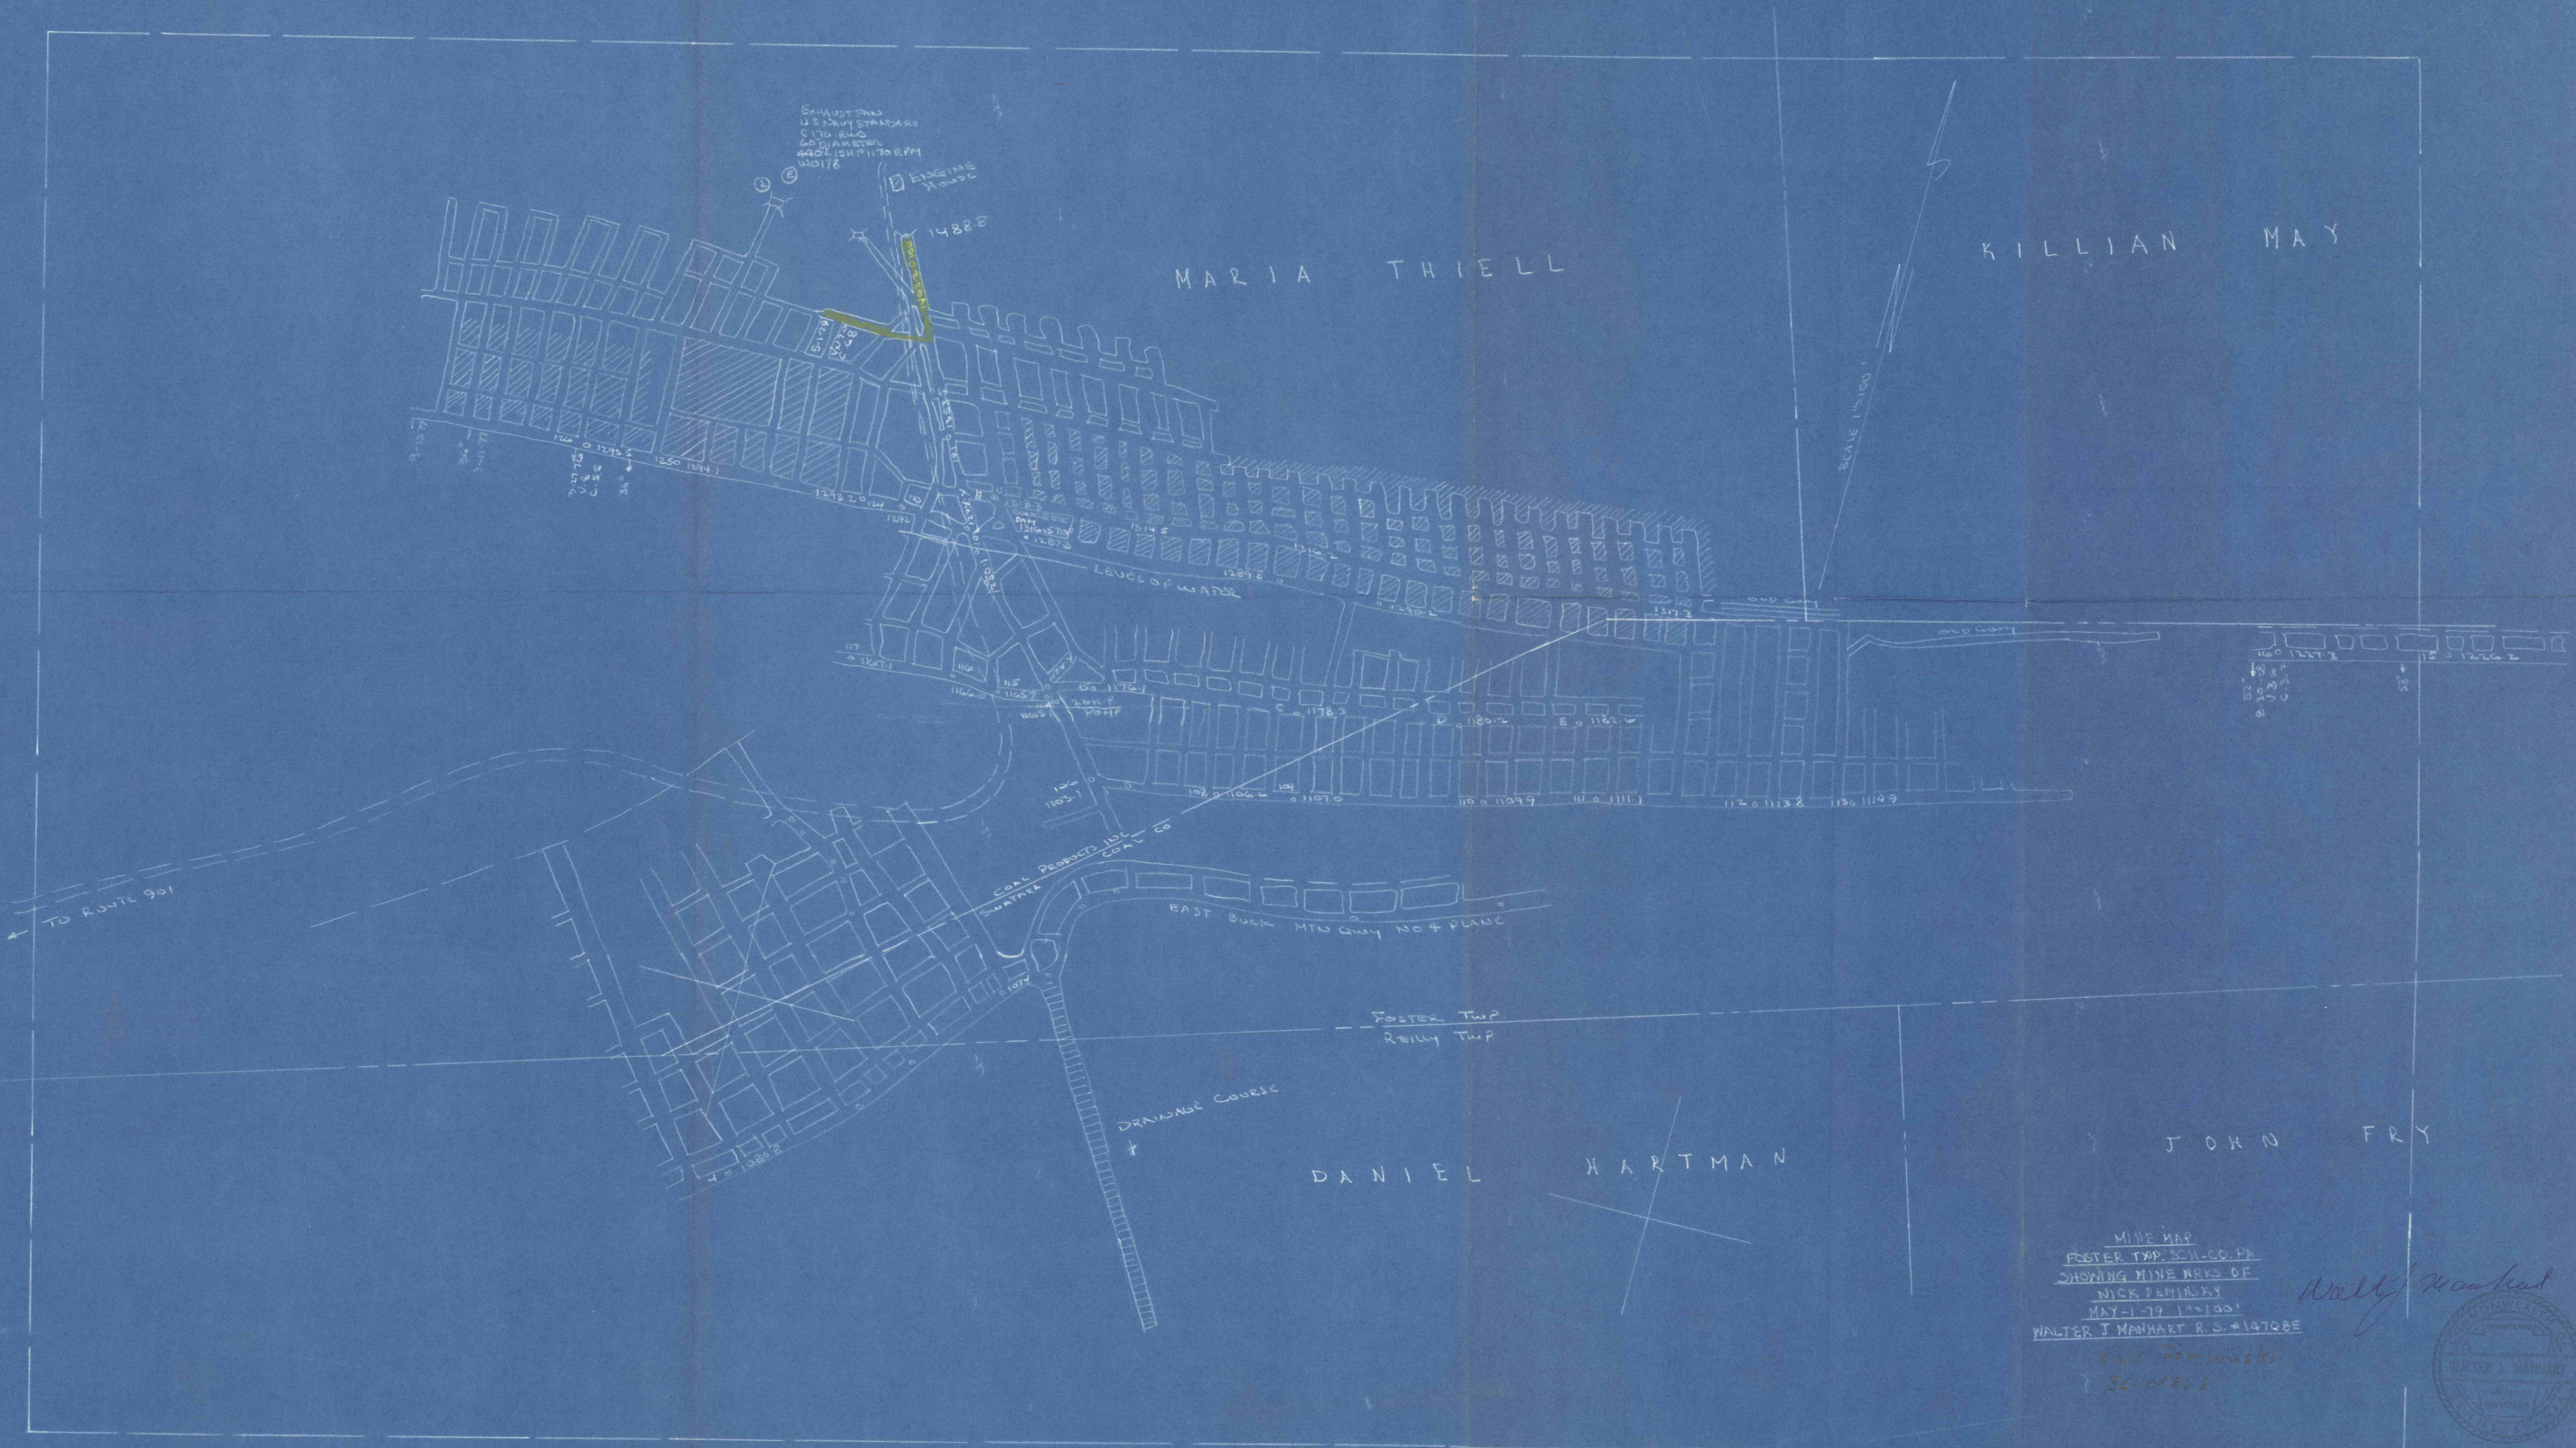