




LEGEND

- X OVERCAST
- DIRECTION OF AIR FLOW
- STOPPING
- BOUNDARY
- /// ROBBING
- ACTIVE WORKINGS SHOWN IN YELLOW

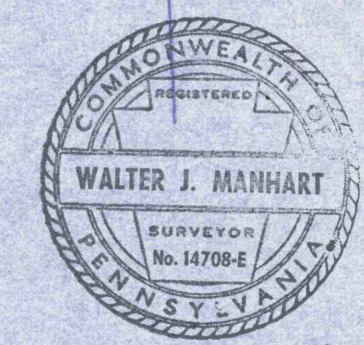

MINE MAP
FOSTER TWP. SCH. CO. PA.
SHOWING MINE WORKS OF
NICK DEMIRAKY - 36-01888
MAY-1-79 1"=100'
WALTER J. MANHART R.S. #14708E
POSTED MAY-20-1980
POSTED JUNE 10-1980

Walter J. Manhart