


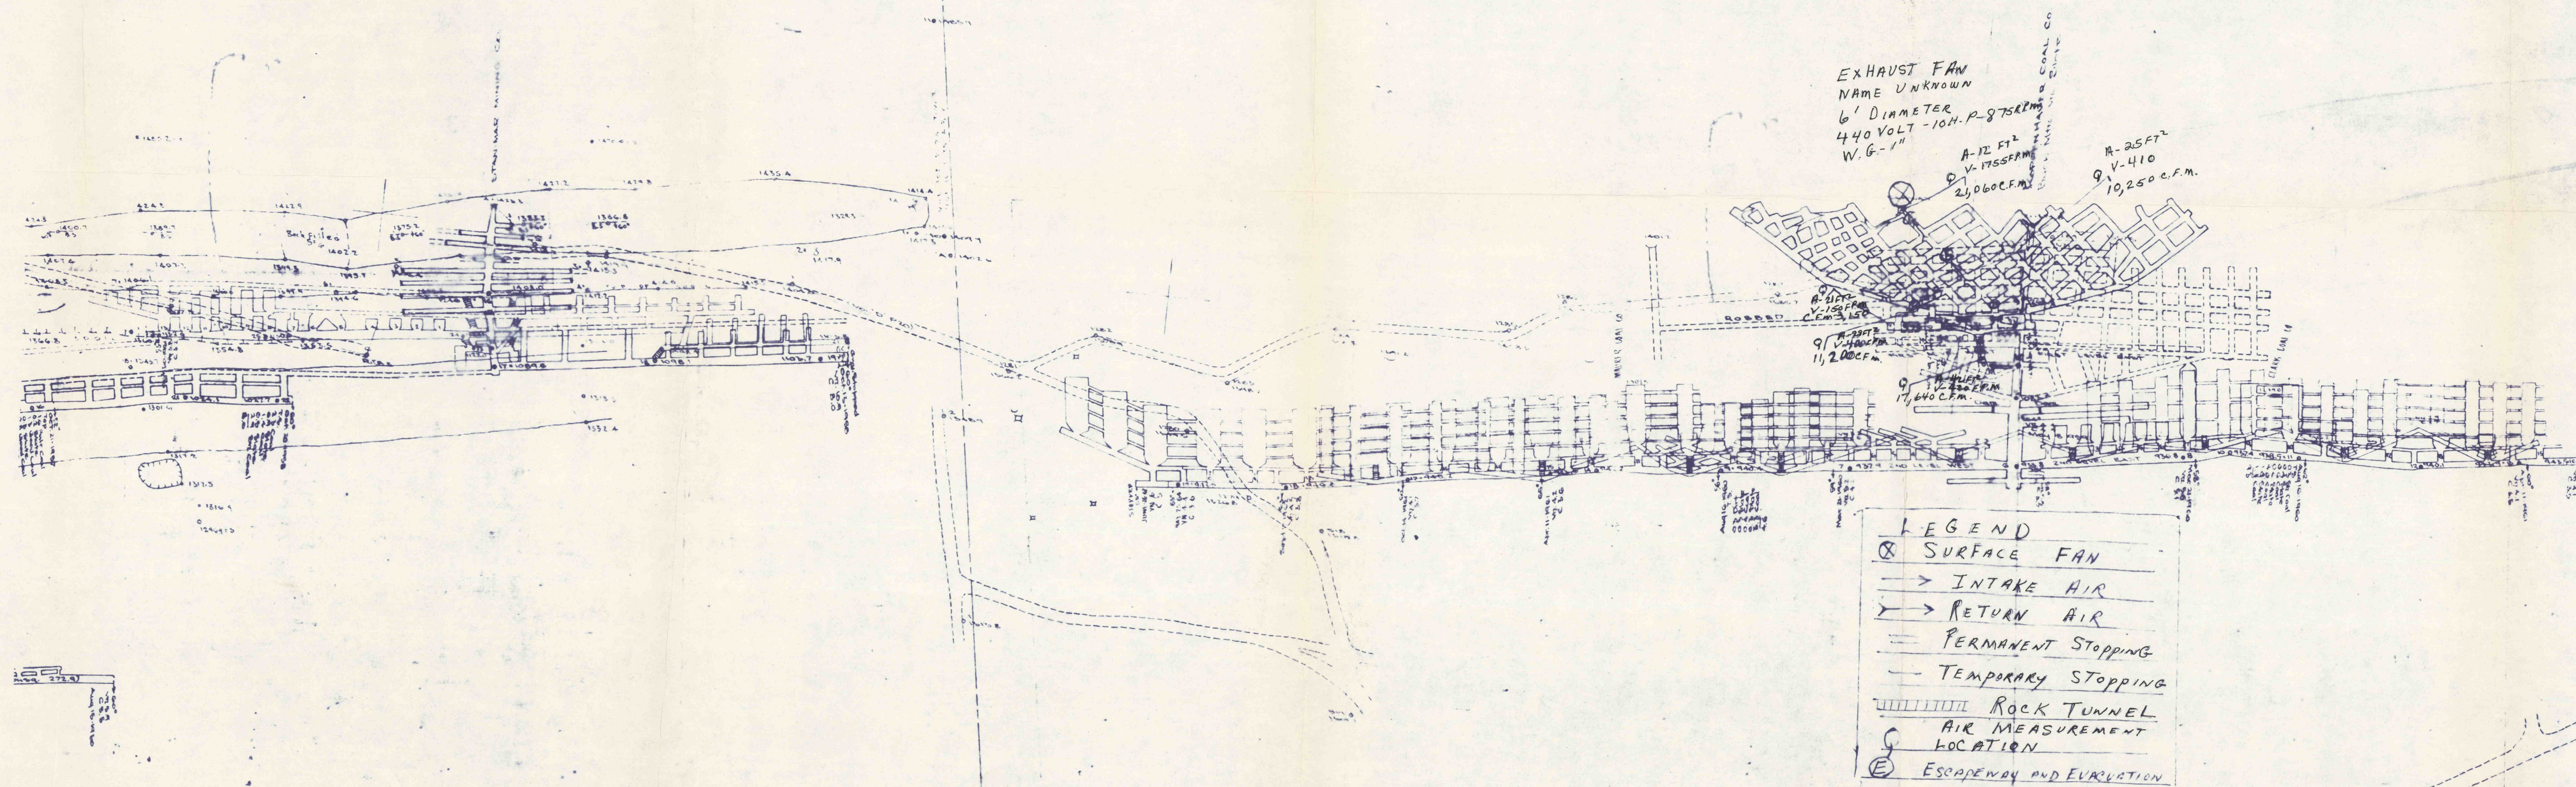

W I L S O N C O A L C O .

RECEIVED
7-3-75 V.J.S.

MINING DEPARTMENT AND SAFETY ASSOCIATION	
COAL MINE SAFETY & HEALTH REGULATION 1	
APPROVED 8-13-75	
(DATE)	

MINE MAP
Showing the location and extent of development of the Howard Kopperhaver Coal Co. Slope Mine. Situate on the So. dip Buck Mountain and Scotty Steel Beds, Hogsins Twp., Schuylkill County, Pa.
A.B. Riedel, P.E. June 12, 1975 Scale 1"=100'
ID 36-01897

Schub
PA MAP
Vaid 2-14-83
4/8