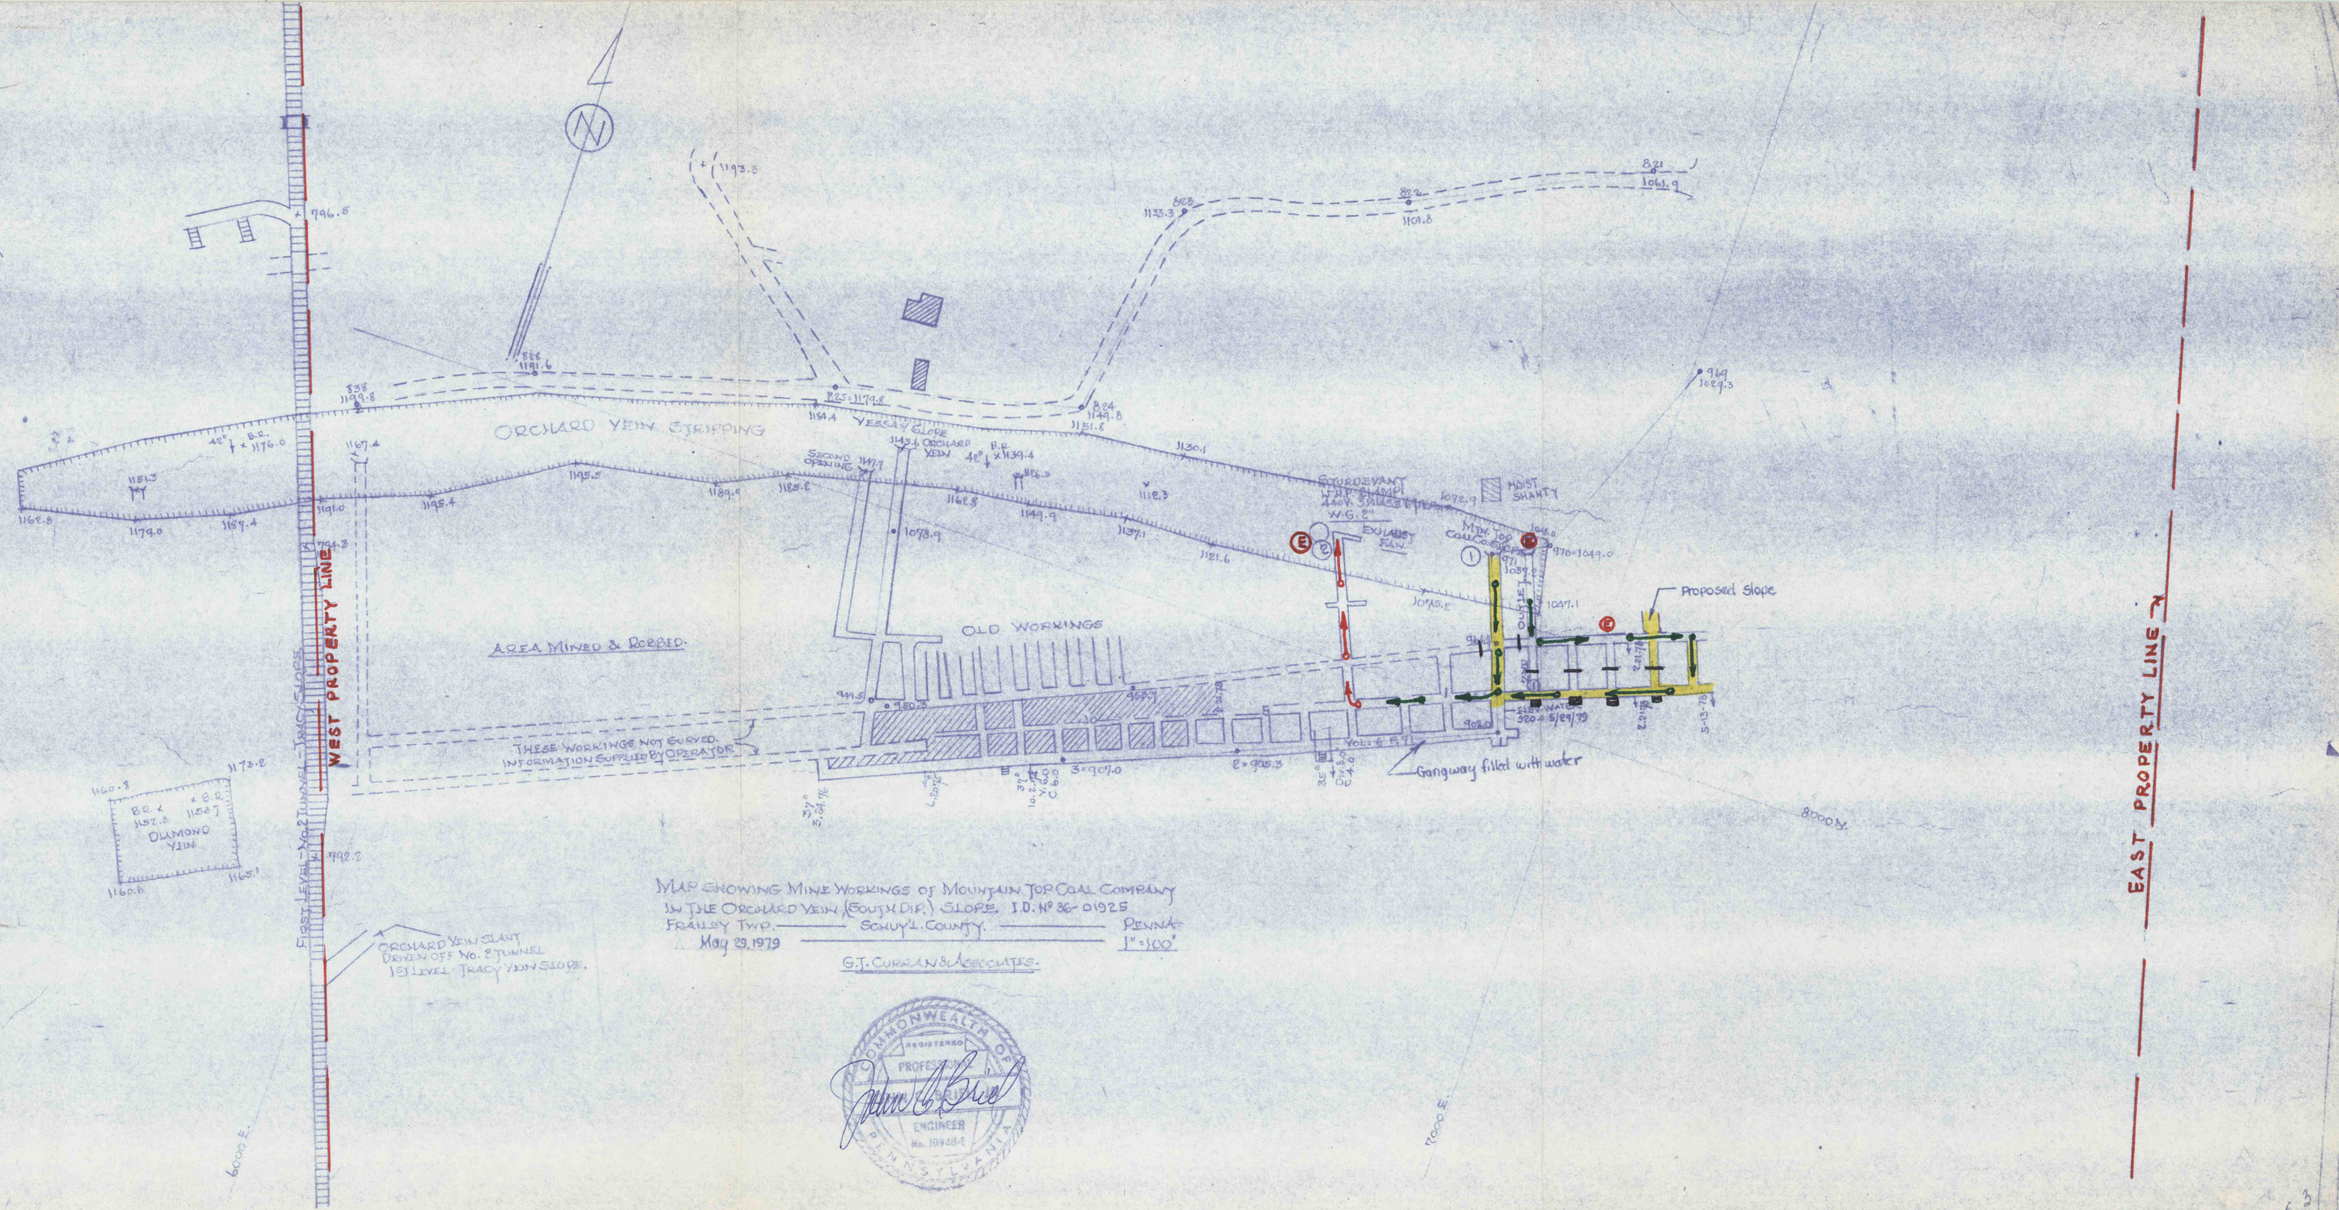

MAP SHOWING MINE WORKINGS OF MOUNTAIN TOP COAL COMPANY
IN THE ORCHARD VEIN (SOUTH DIP.) SLOPE. I.D. Nº 36-01925
FRANKLIN TWP. — SCHUYL. COUNTY. — PENNA.
May 29, 1979 — 1" = 100'

G.J. CURRAN & ASSOCIATES.

COMMONWEALTH OF PENNSYLVANIA
REGISTERED PROFESSIONAL ENGINEER
No. 10938-E

1142