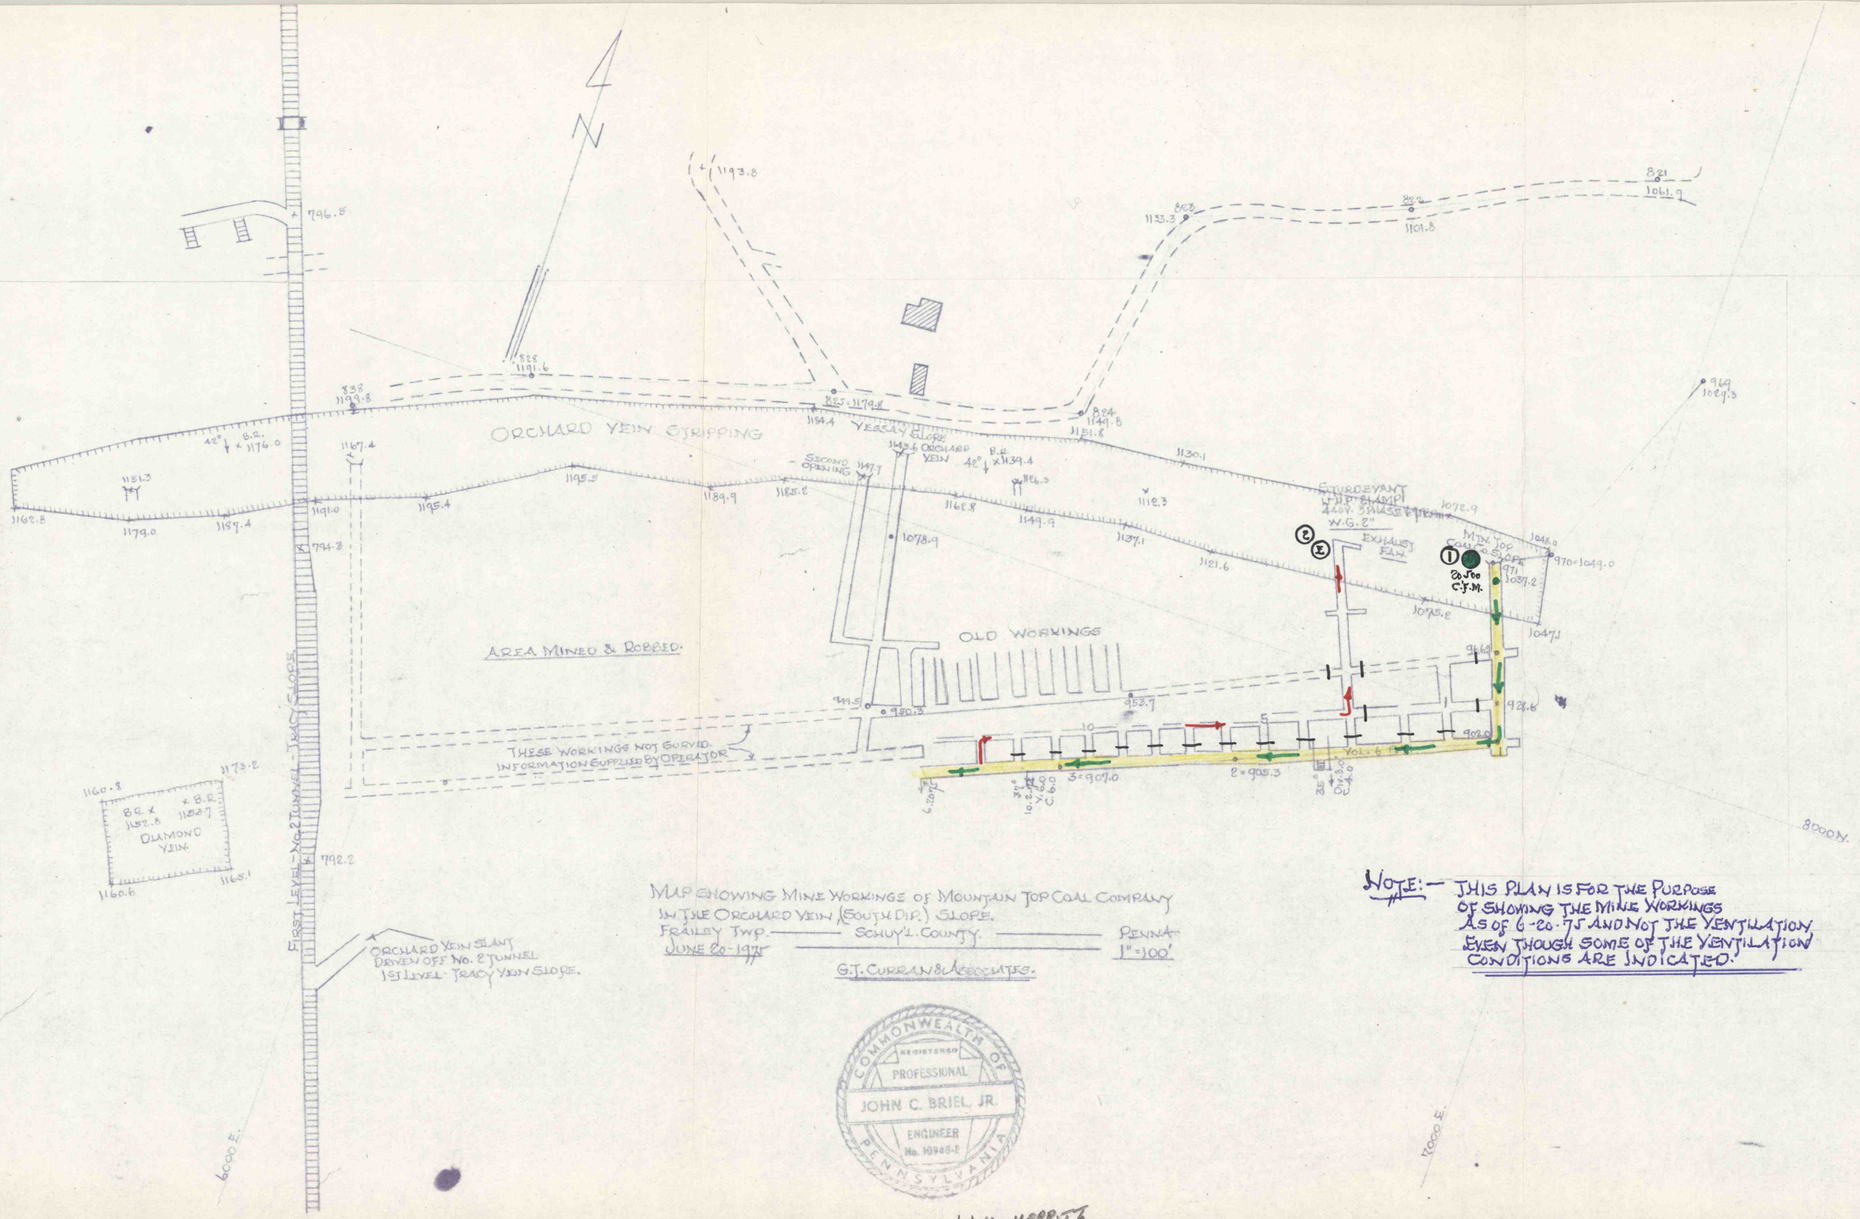

MAP SHOWING MINE WORKINGS OF MOUNTAIN TOP COAL COMPANY
IN THE ORCHARD VEIN (SOUTH DIP.) SLOPE.
FRAILEY TWP. — SCHUYL. COUNTY. — PENNA.
JUNE 20-1975 — 1" = 100'

G.T. CURRAN & ASSOCIATES.

NOTE:— THIS PLAN IS FOR THE PURPOSE OF SHOWING THE MINE WORKINGS AS OF 6-20-75 AND NOT THE VENTILATION EVEN THOUGH SOME OF THE VENTILATION CONDITIONS ARE INDICATED.

COMMONWEALTH OF PENNSYLVANIA
REGISTERED PROFESSIONAL
JOHN C. BRIEL, JR.
ENGINEER
No. 10946-E

W. M. MERRITT

1143