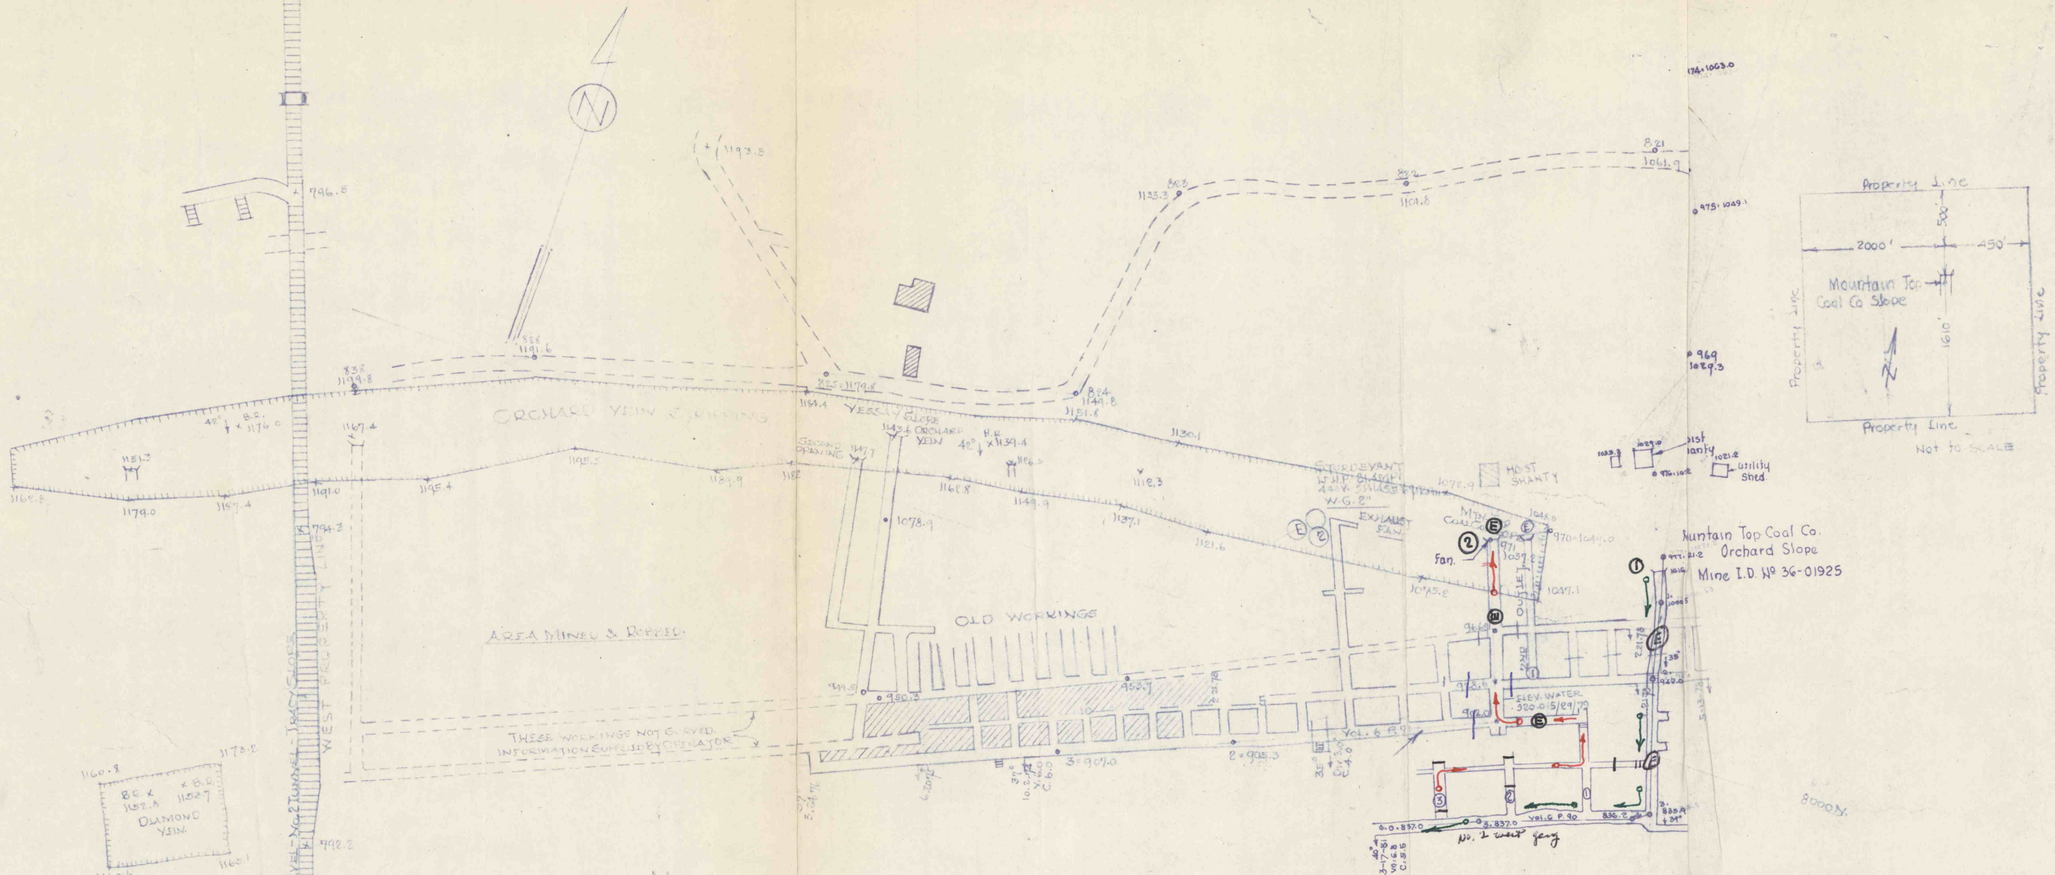

MAP SHOWING MINE WORKINGS OF MOUNTAIN TOP COAL COMPANY IN THE ORCHARD VEIN (SOUTH DIP) SLOPE. I.D. № 36-01925
FRANKLIN TWP. — SCHUYL. COUNTY. — PENNA.
May 29, 1979 — 1" = 100'

Surveyed June 29, 1981

G.J. CUMMINS & ASSOCIATES.

COMMONWEALTH OF PENNSYLVANIA
REGISTERED PROFESSIONAL ENGINEER
ELWOOD F. WIRTH
No. 642-K

Elwood F. Wirth

1145