


VENTILATION SYMBOLS
(where appropriate)

- Map Air
- Auxiliary Fan
- Air Flow Meter
- Air Flow Return
- Stoppage
- Air Bridge
- Regulator
- Mock Door
- Velocity fan
- Quantity fan
- Water Gauge, in
- Exhaust fan
- Smelter Exhaust Fan
- Pillar Removal or Robbing
- Mine Seal
- Active Workings (Yellow)
- Curled or Brattice
- Workings Not Surveyed
- Contour Ground

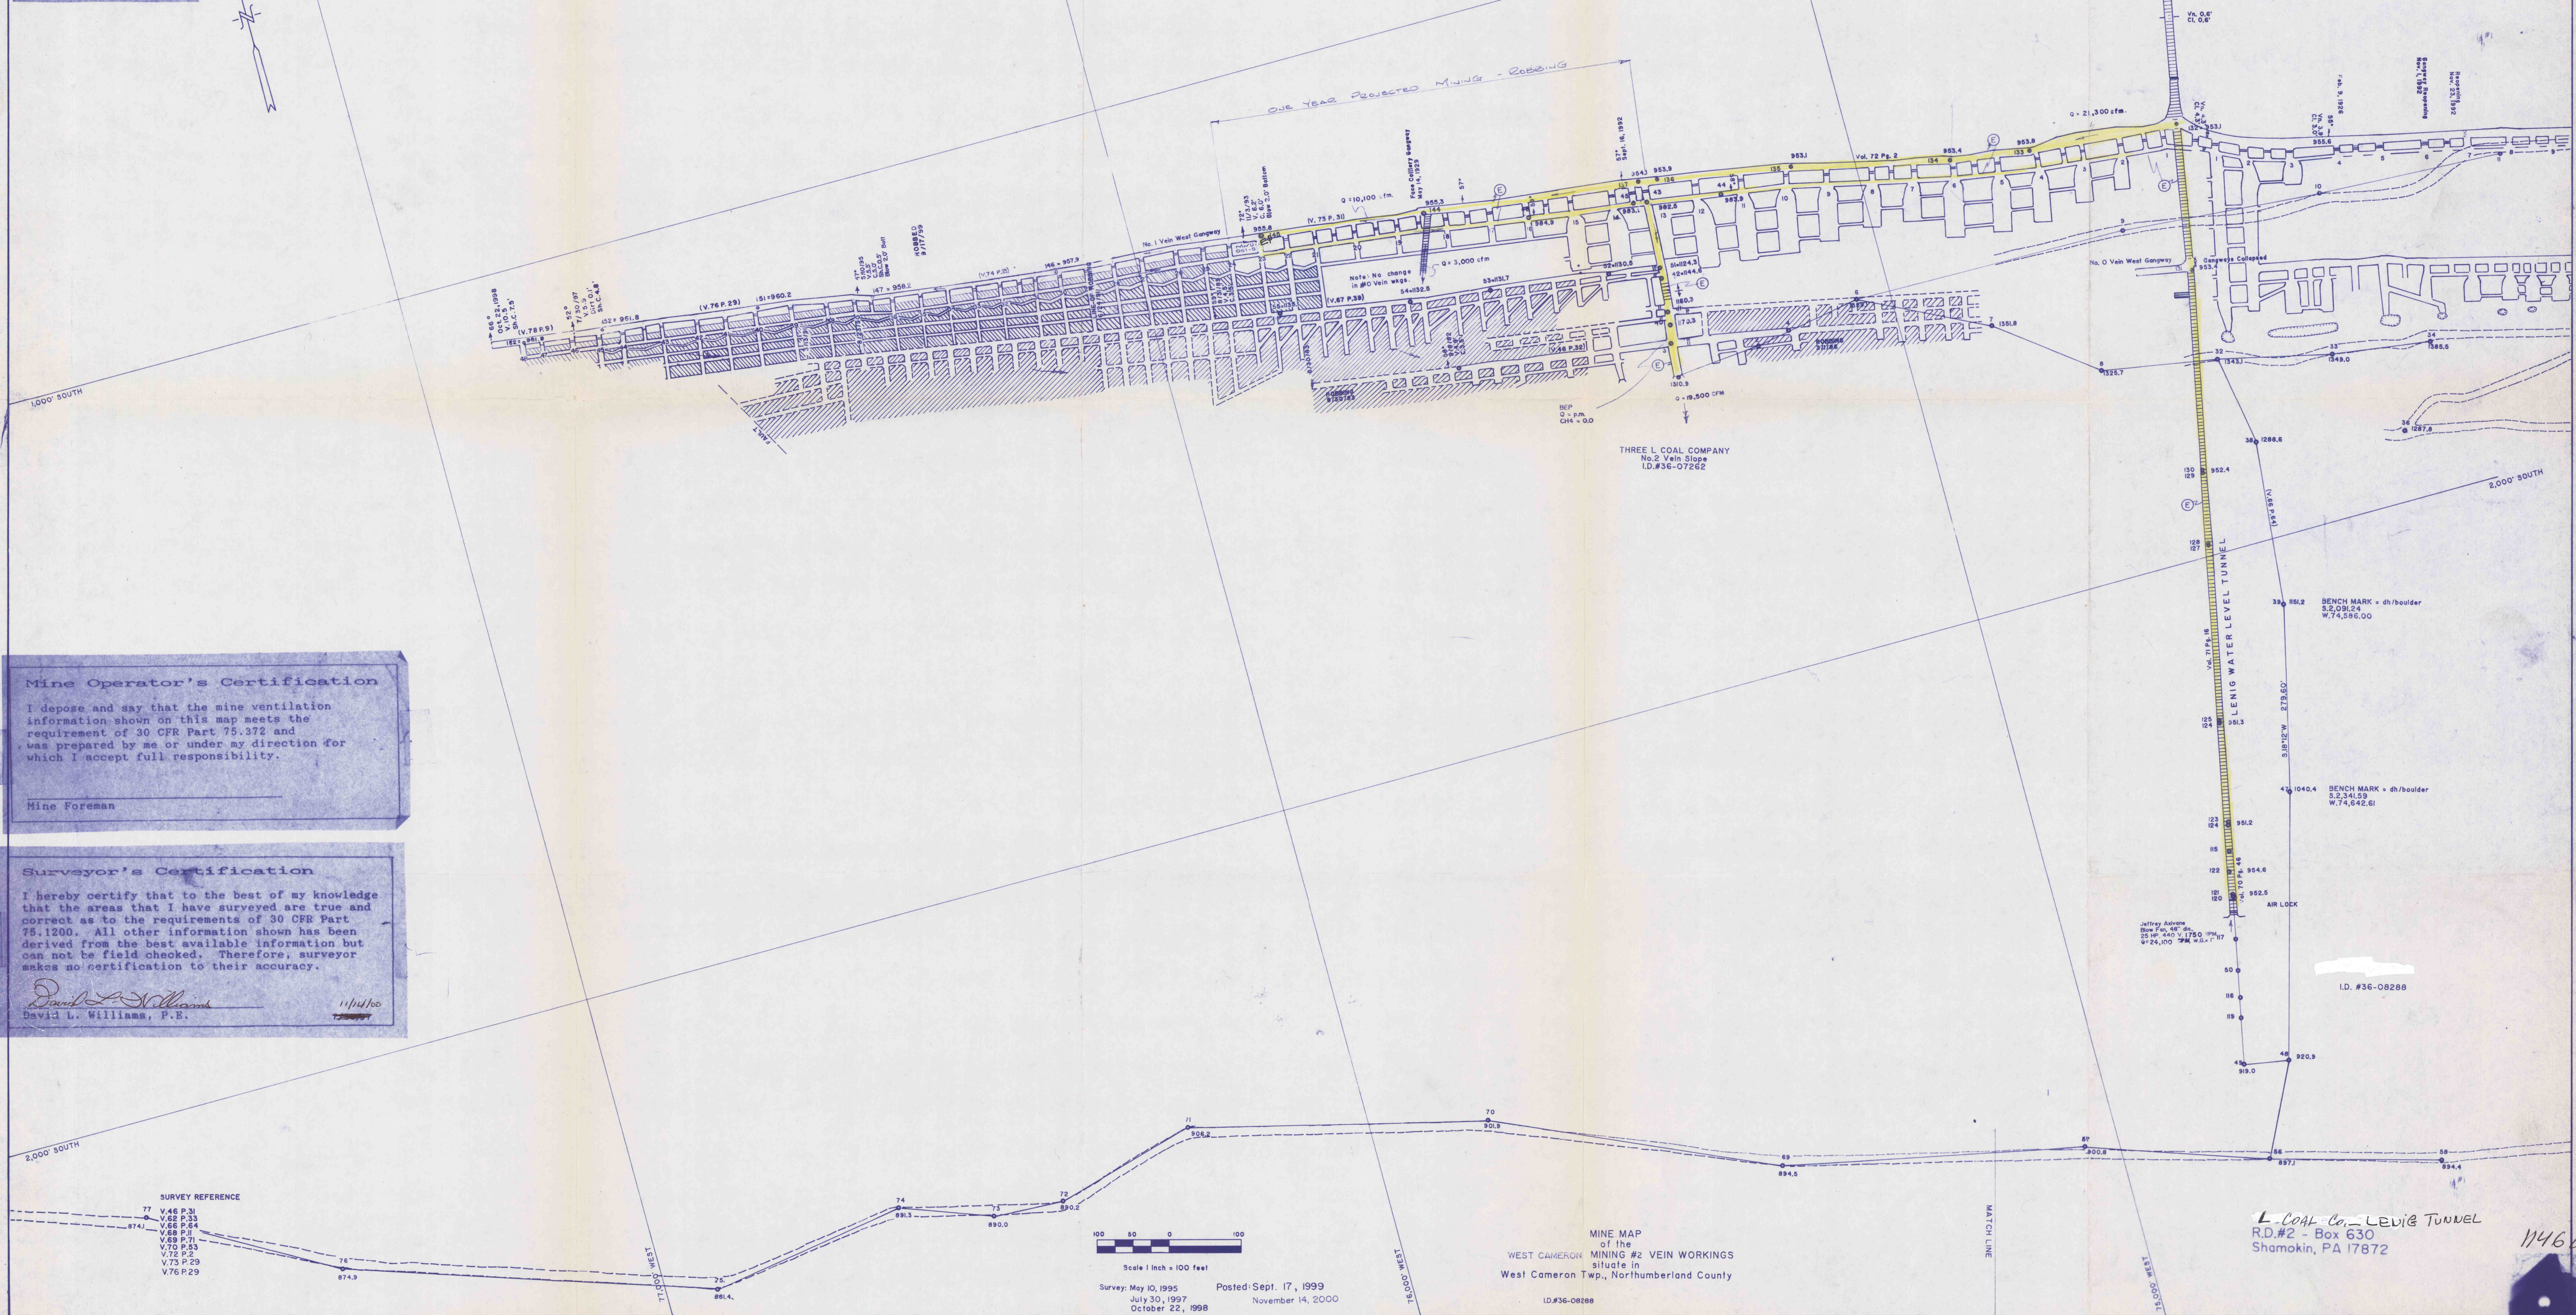

Mine Operator's Certification

I depose and say that the mine ventilation information shown on this map meets the requirement of 30 CFR Part 75.372 and was prepared by me or under my direction for which I accept full responsibility.

Mine Foreman

Surveyor's Certification

I hereby certify that to the best of my knowledge that the areas that I have surveyed are true and correct as to the requirements of 30 CFR Part 75.1200. All other information shown has been derived from the best available information but can not be field checked. Therefore, surveyor makes no certification to their accuracy.

David L. Williams
David L. Williams, P.E. 11/14/00

Scale 1 inch = 100 feet

Survey: May 10, 1995
July 30, 1997
October 22, 1998

Posted: Sept. 17, 1999
November 14, 2000

MINE MAP
of the
WEST CAMERON MINING #2 VEIN WORKINGS
situate in
West Cameron Twp., Northumberland County

I.D. #36-08288

L. COAL Co. LEWIS TUNNEL
R.D.#2 - Box 630
Shamokin, PA 17872

1146