


VENTILATION SYMBOLS
(where appropriate)

- Main Fan
- Auxiliary Fan
- Air Flow Indicator
- Air Flow Reversal
- Stopping
- Air Bridge
- Regulator
- Main Road
- Y-branch
- Dead-end
- Water Supply
- Emergency
- Stakeholder's Point
- Pillar Removal or Rebuilding
- Wire Seal
- Active Workings (Yellow)
- Current or Draft
- Workings Not Surveyed
- Closed Ground

EP Evaluation Point
PM Perceptible Air Movement

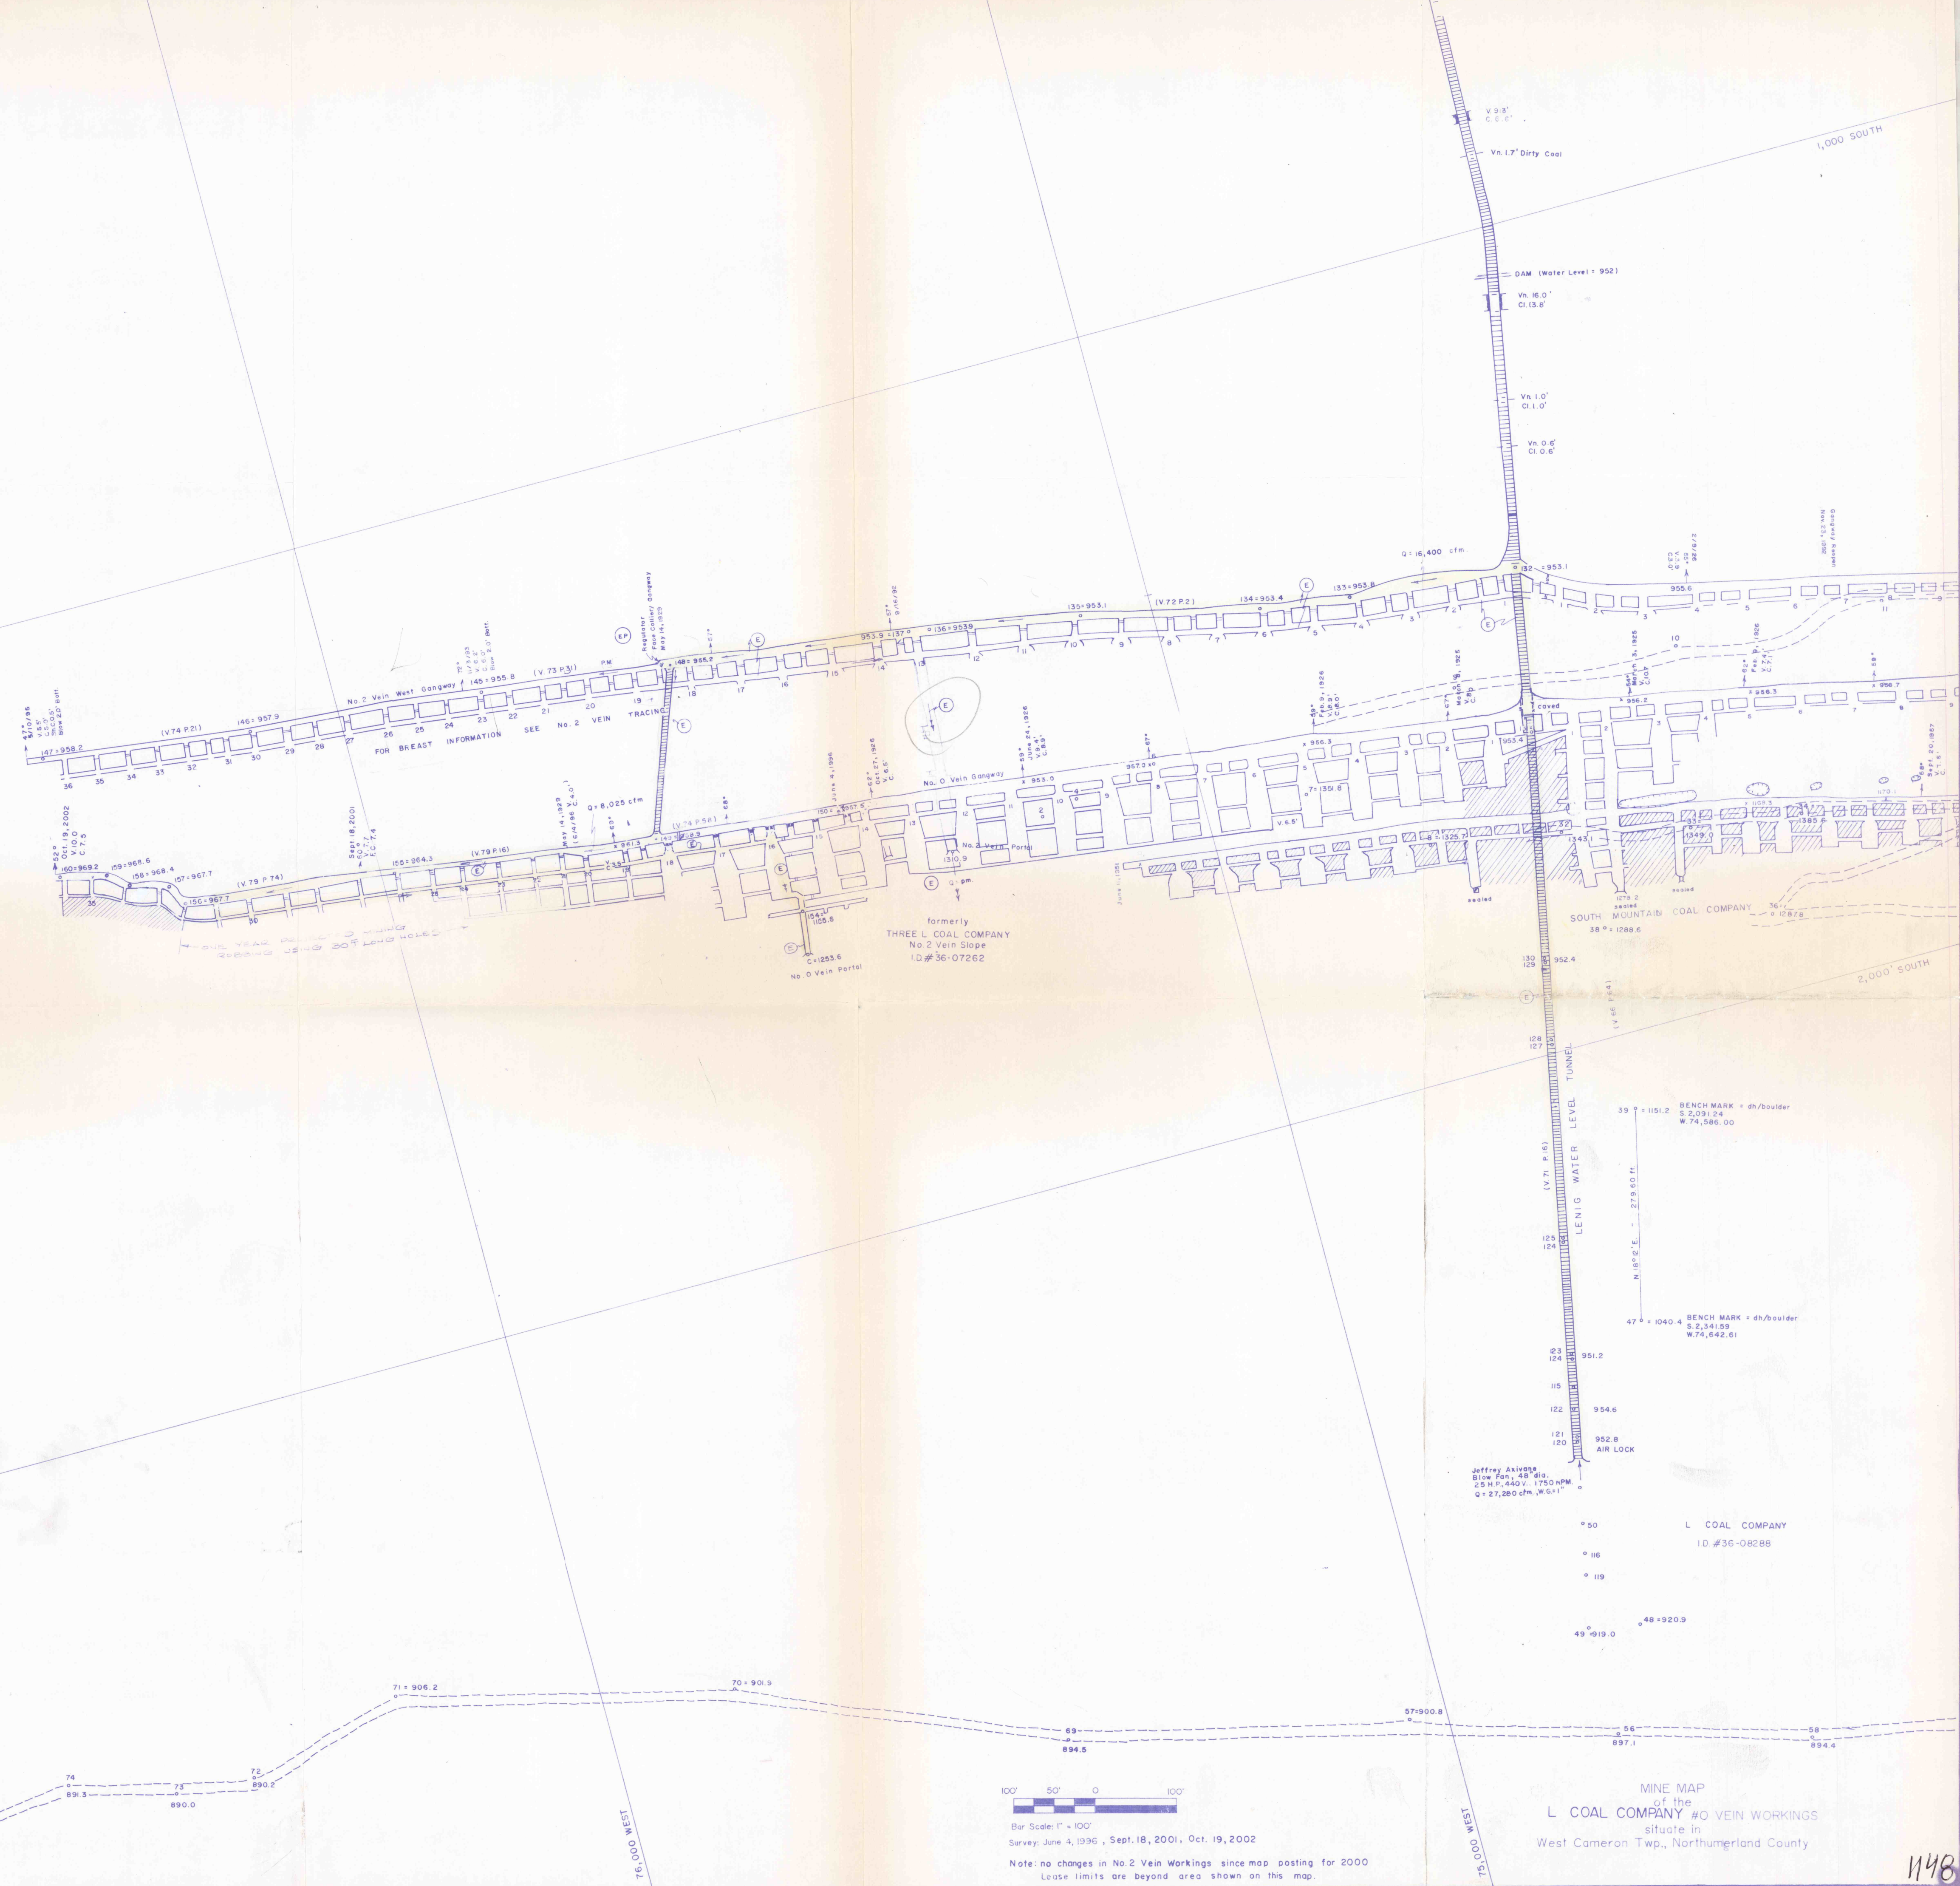

Mine Foreman's Certification


I depose and say that the mine ventilation information shown on this map meets the requirements of 30 CFR Part 75.372 and was prepared by me or under my direction for which I accept full responsibility.

Jim Lenz 5/27/03
Mine Foreman

Surveyor's Certification

I hereby certify that to the best of my knowledge that the areas that I have surveyed are true and correct as to the requirements of 30 CFR Part 75.200. All other information shown has been derived from the best available information but can not be field checked. Therefore, surveyor makes no certification to their accuracy.

David L. Williams
David L. Williams, P.E.

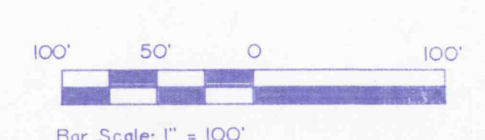

Bar Scale: 1" = 100'
Survey: June 4, 1996, Sept. 18, 2001, Oct. 19, 2002

Note: no changes in No. 2 Vein Workings since map posting for 2000
Lease limits are beyond area shown on this map.

MINE MAP of the
L COAL COMPANY #0 VEIN WORKINGS
situate in
West Cameron Twp., Northumberland County