


VENTILATION SYMBOLS

- Main Fan
- Accessory Fan
- Air Flow/Return
- Air Pipe/Return
- Stoppage
- Air Bridge
- Regulator
- Main Road
- Velocity Fan
- Quantity Fan
- Water Supply
- Escapeway
- Shelter/Exhaustion Point
- Pillar Removal or Raising
- Main Seal
- Active Workings (Yellow)
- Current or Distance
- Workings Not Surveyed
- Closed Group

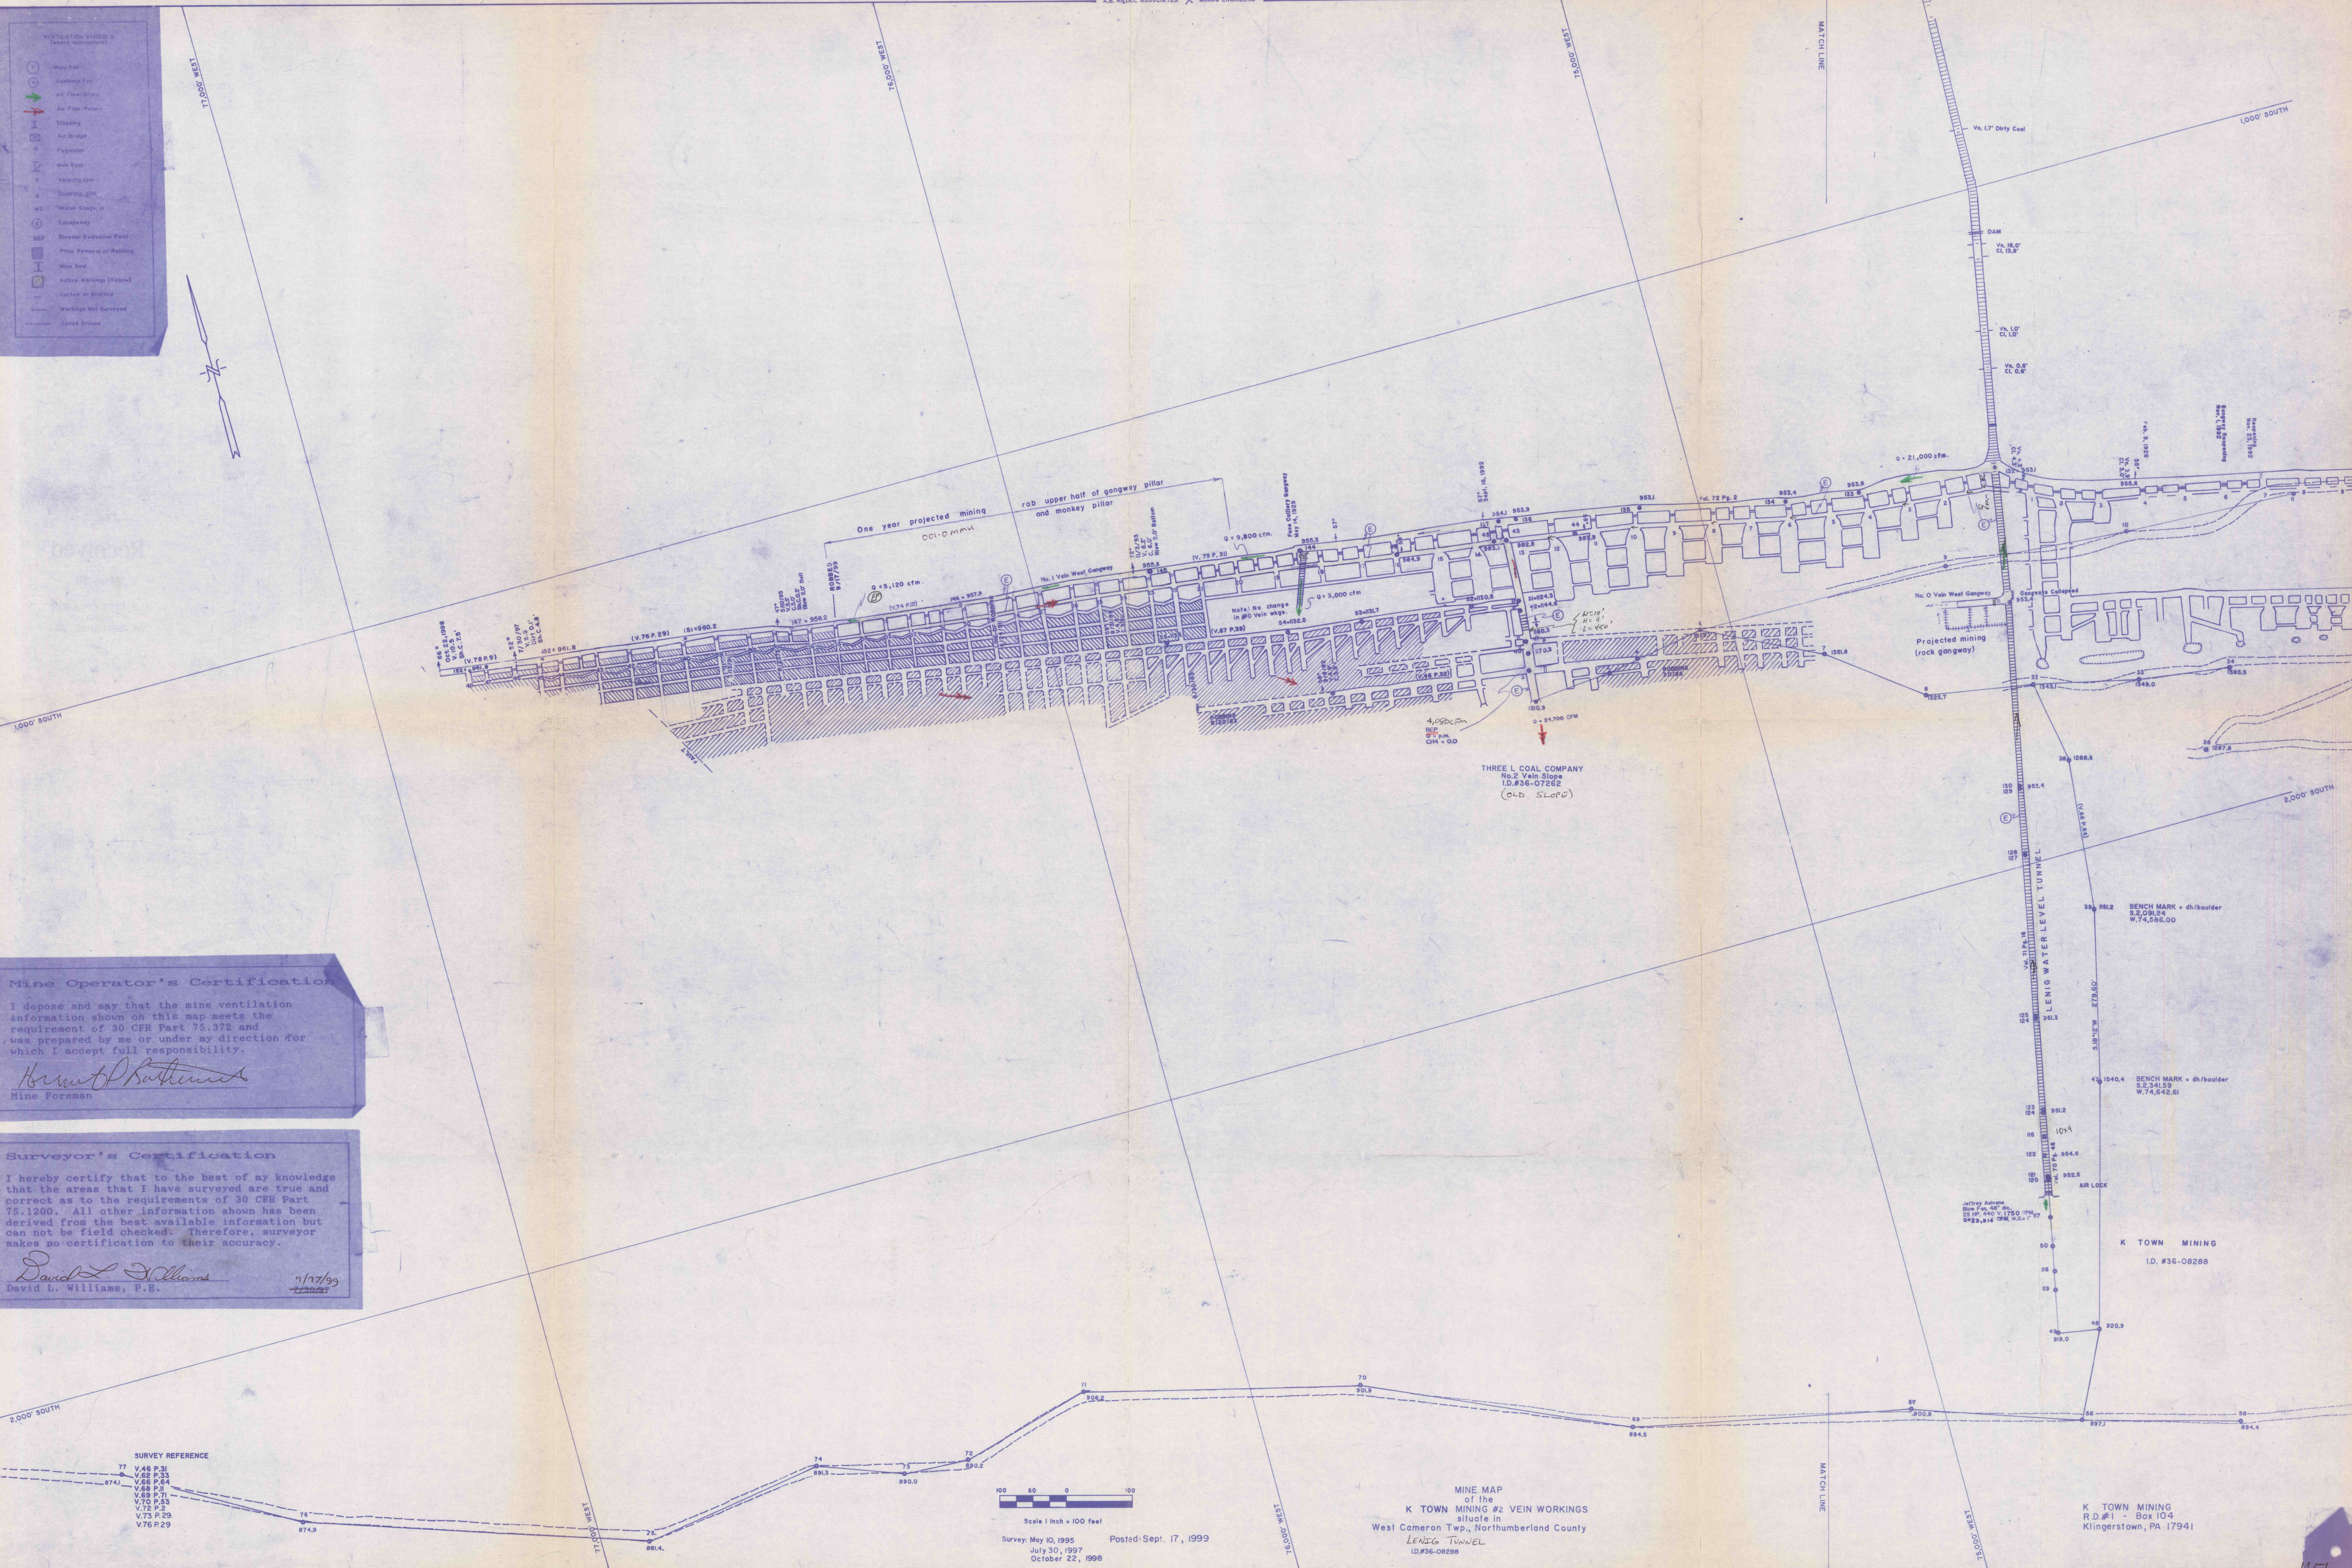

Mine Operator's Certification


I depose and say that the mine ventilation information shown on this map meets the requirement of 30 CFR Part 75.372 and was prepared by me or under my direction for which I accept full responsibility.

Kenneth P. Rattmann
Mine Foreman

Surveyor's Certification

I hereby certify that to the best of my knowledge that the areas that I have surveyed are true and correct as to the requirements of 30 CFR Part 75.1200. All other information shown has been derived from the best available information but can not be field checked. Therefore, surveyor makes no certification to their accuracy.

David L. Williams
David L. Williams, P.E. 7/17/99

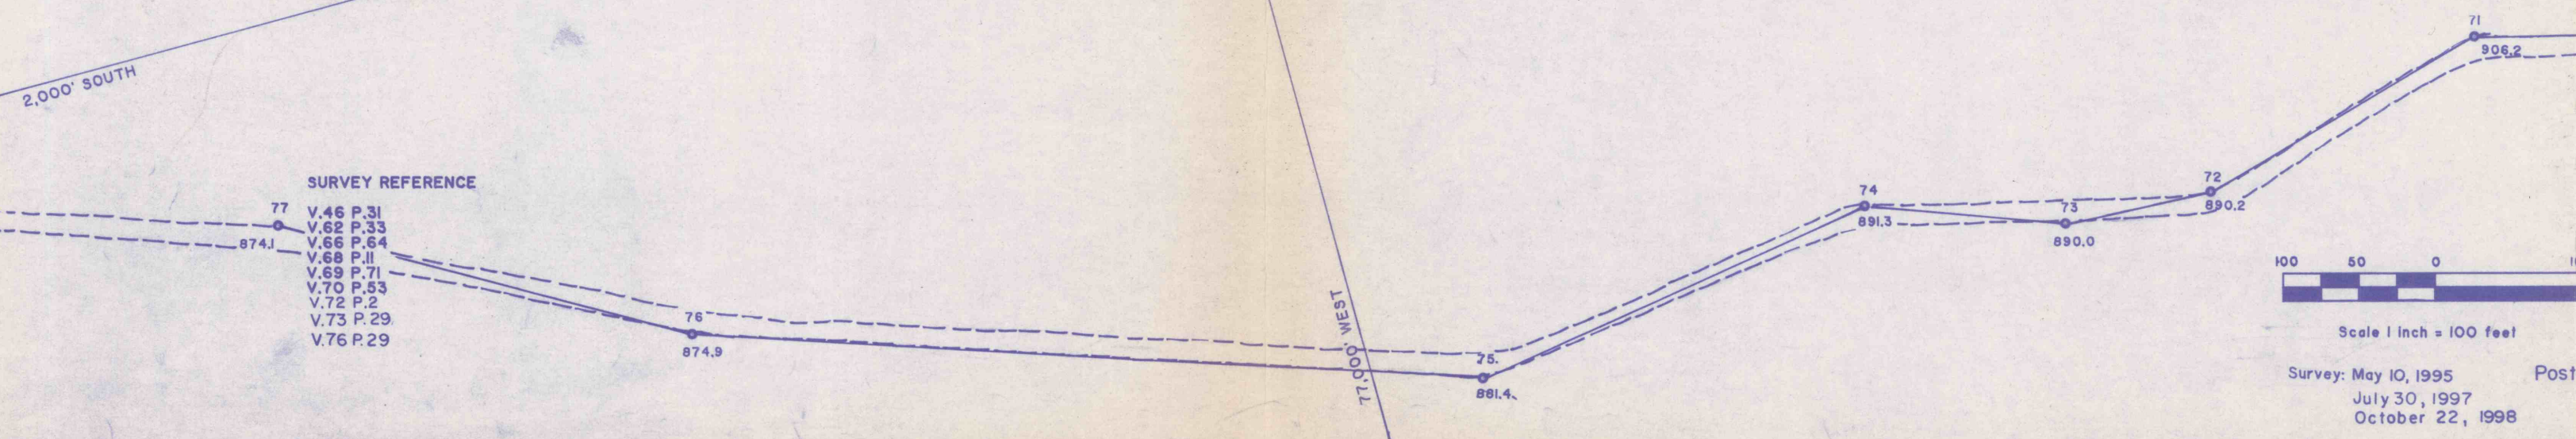

MINE MAP
of the
K TOWN MINING #2 VEIN WORKINGS
situated in
West Cameron Twp., Northumberland County
LENG TUNNEL
ID. #36-08288

K TOWN MINING
R.D. #1 - Box 104
Klingerstown, PA 17941