


- Ventilation Symbols
- Main Fan
 - Auxiliary Fan
 - Intake Air
 - Return Air
 - Stoppings
 - Air Bridge
 - Regulator
 - Man Door
 - Quantity of Air
 - Water Gauge
 - Escapeway
 - Altered Evaluation Point
 - Isolation
 - Active Workings (yellow)

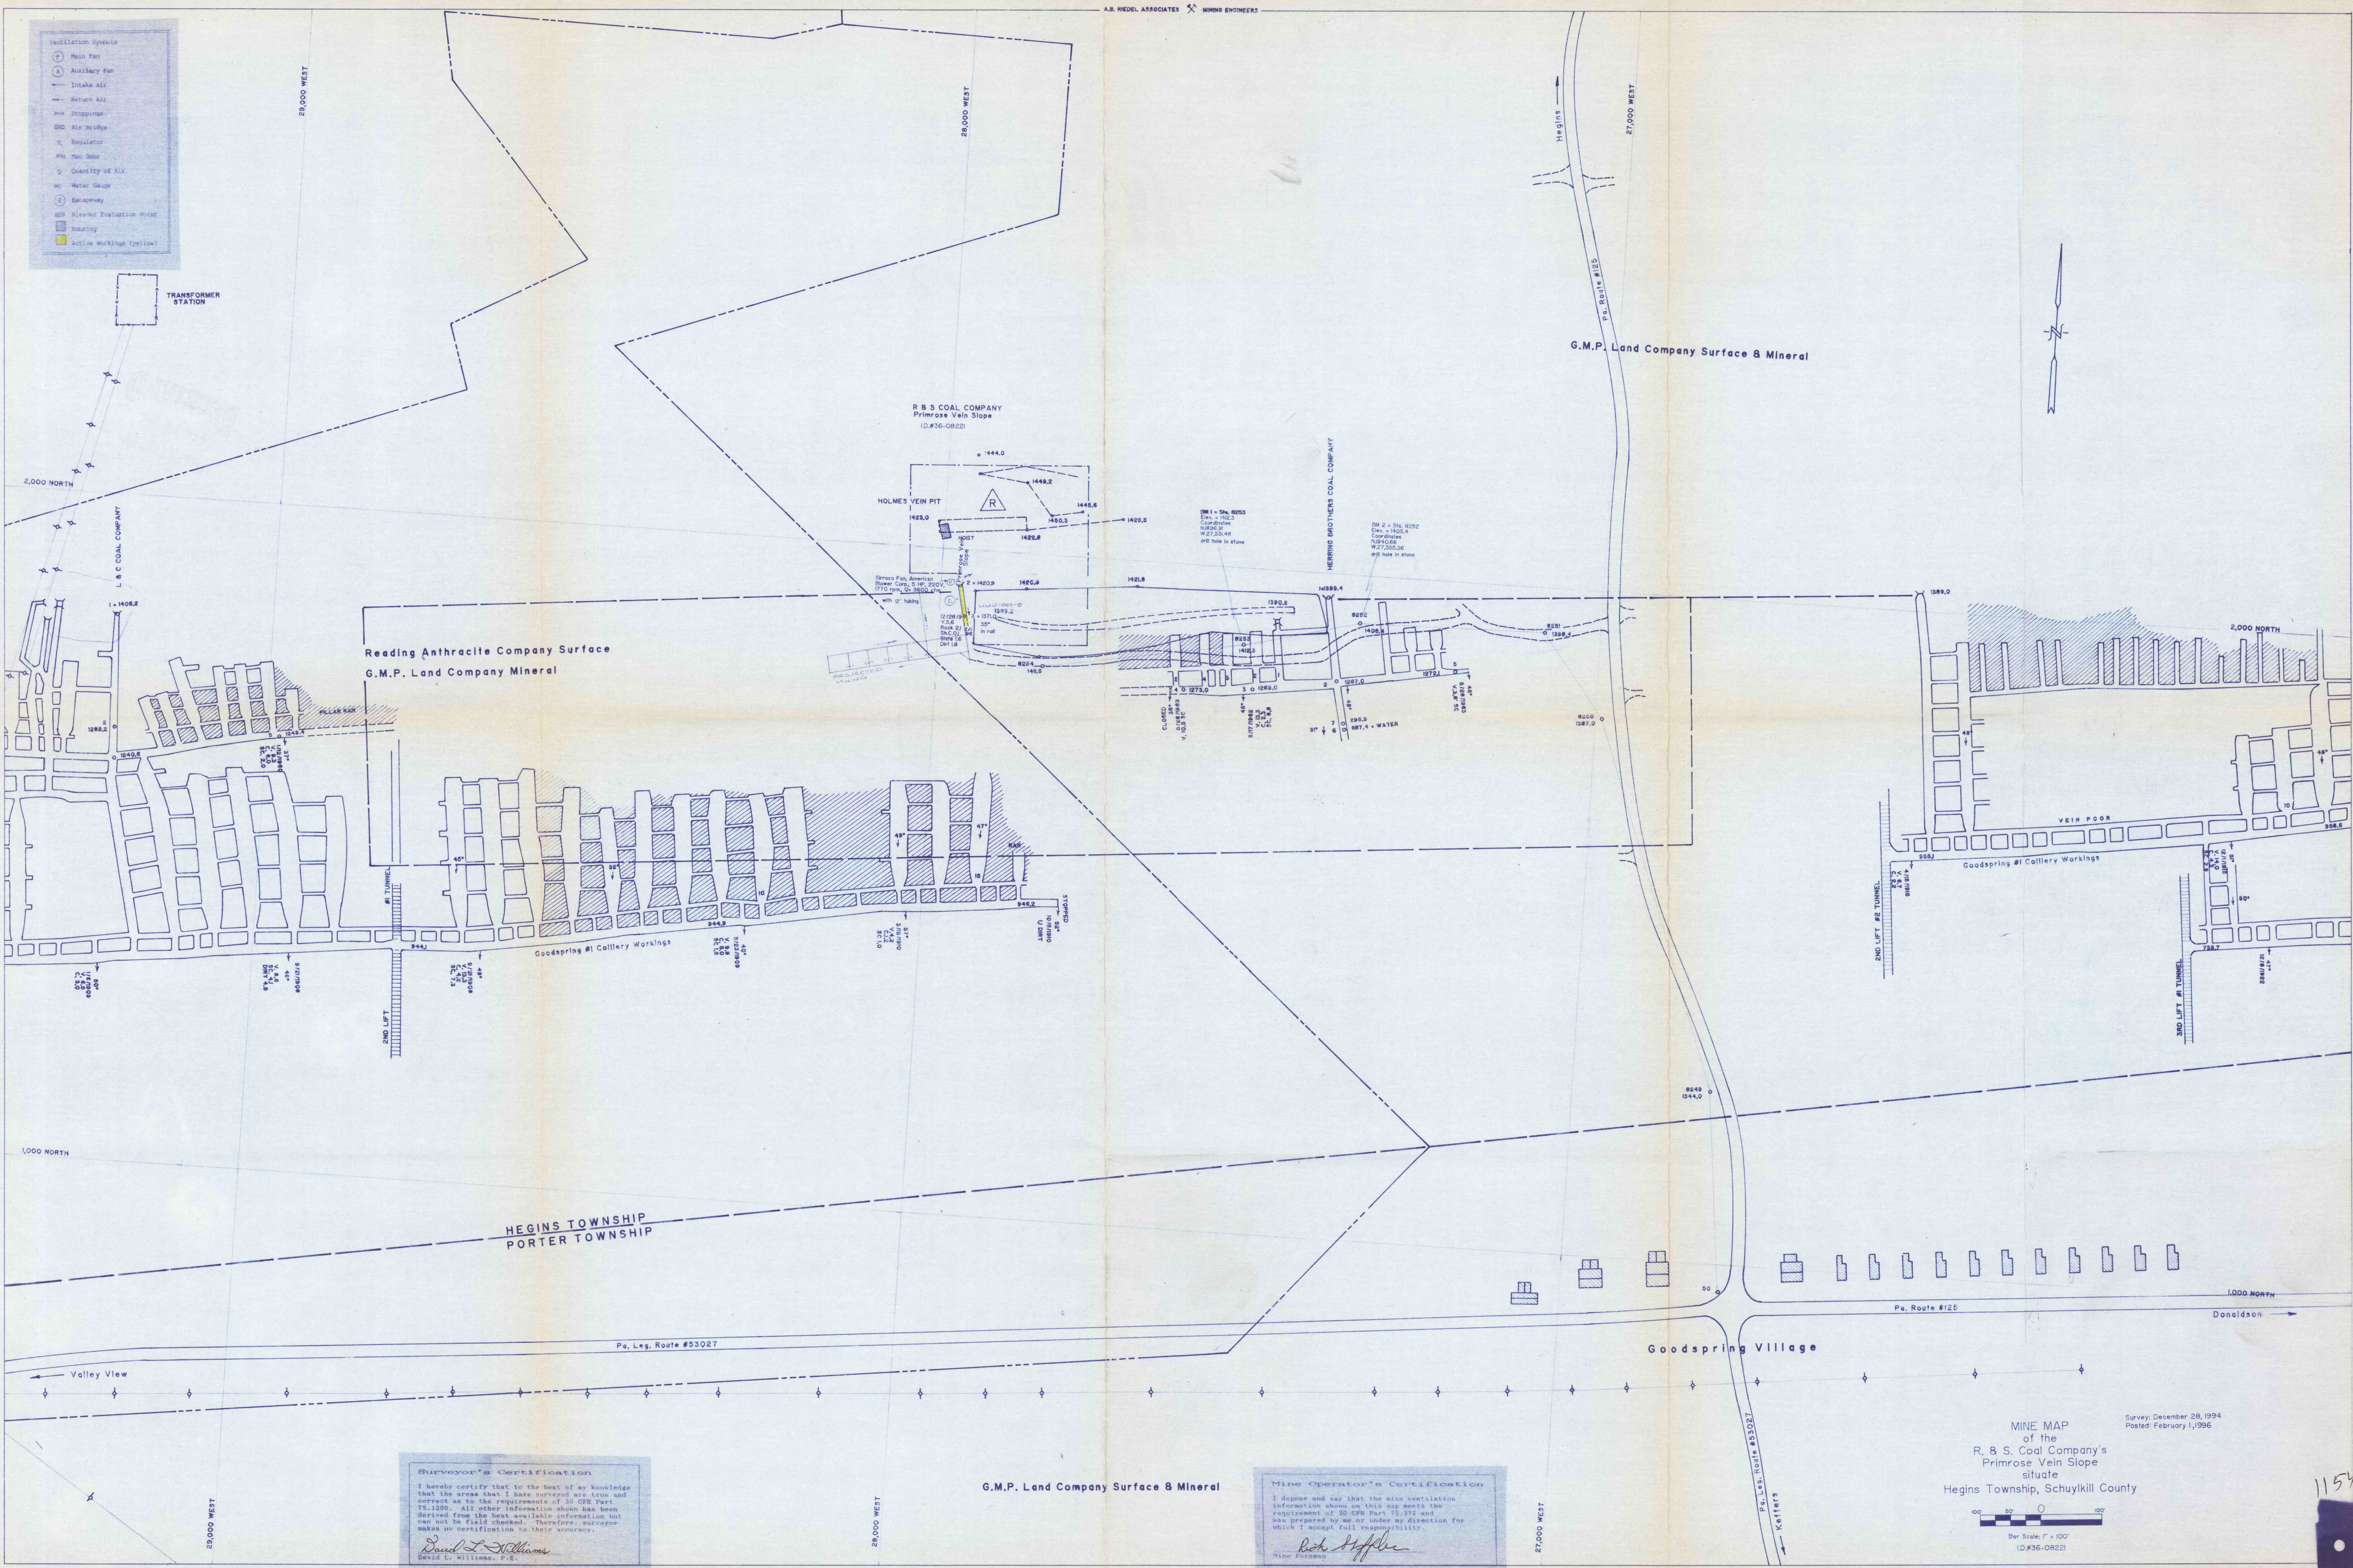

Surveyor's Certification
I hereby certify that to the best of my knowledge and belief the area shown on this map is true and correct as to the requirements of 30 CFR Part 75.1200. All other information shown has been derived from the best available information but was not field checked. Therefore, surveyor makes no certification to their accuracy.
David L. Williams
David L. Williams, P.E.

G.M.P. Land Company Surface & Mineral

Mine Operator's Certification
I depose and say that the mine ventilation information shown on this map meets the requirement of 30 CFR Part 75.372 and was prepared by me or under my direction for which I accept full responsibility.
Rob Haffner
Mine Operator

MINE MAP
of the
R. & S. Coal Company's
Primrose Vein Slope
situate
Hegins Township, Schuylkill County
Survey: December 28, 1994
Posted: February 1, 1996
Bar Scale: 1" = 100'
ID #36-0922