



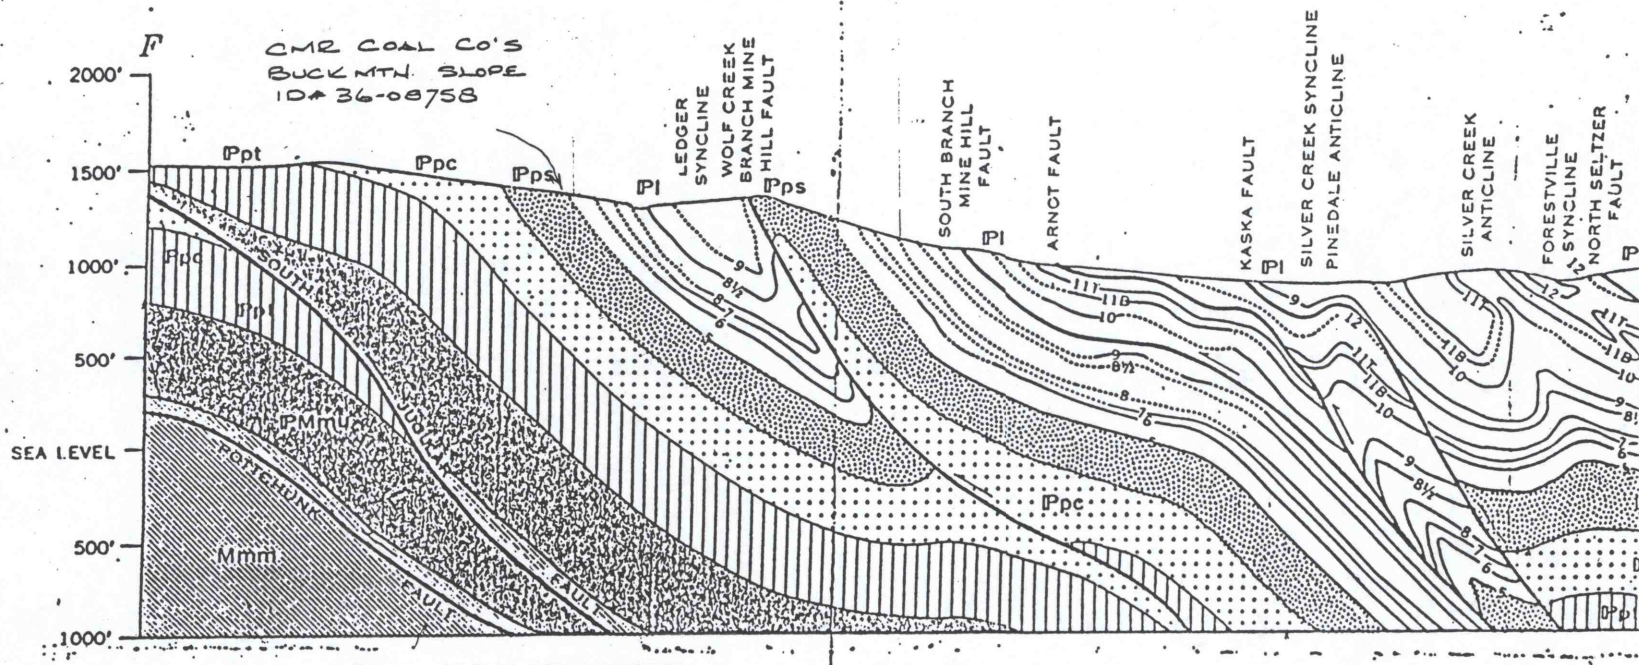

STRUCTURAL CROSS SECTIONS

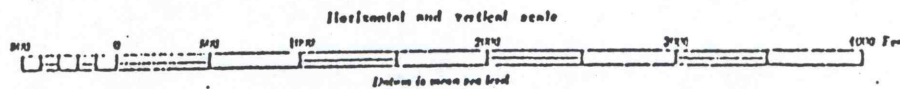

GEOLOGICAL CROSS SECTION

SCALE 1" = 1000'

David L. Williams