

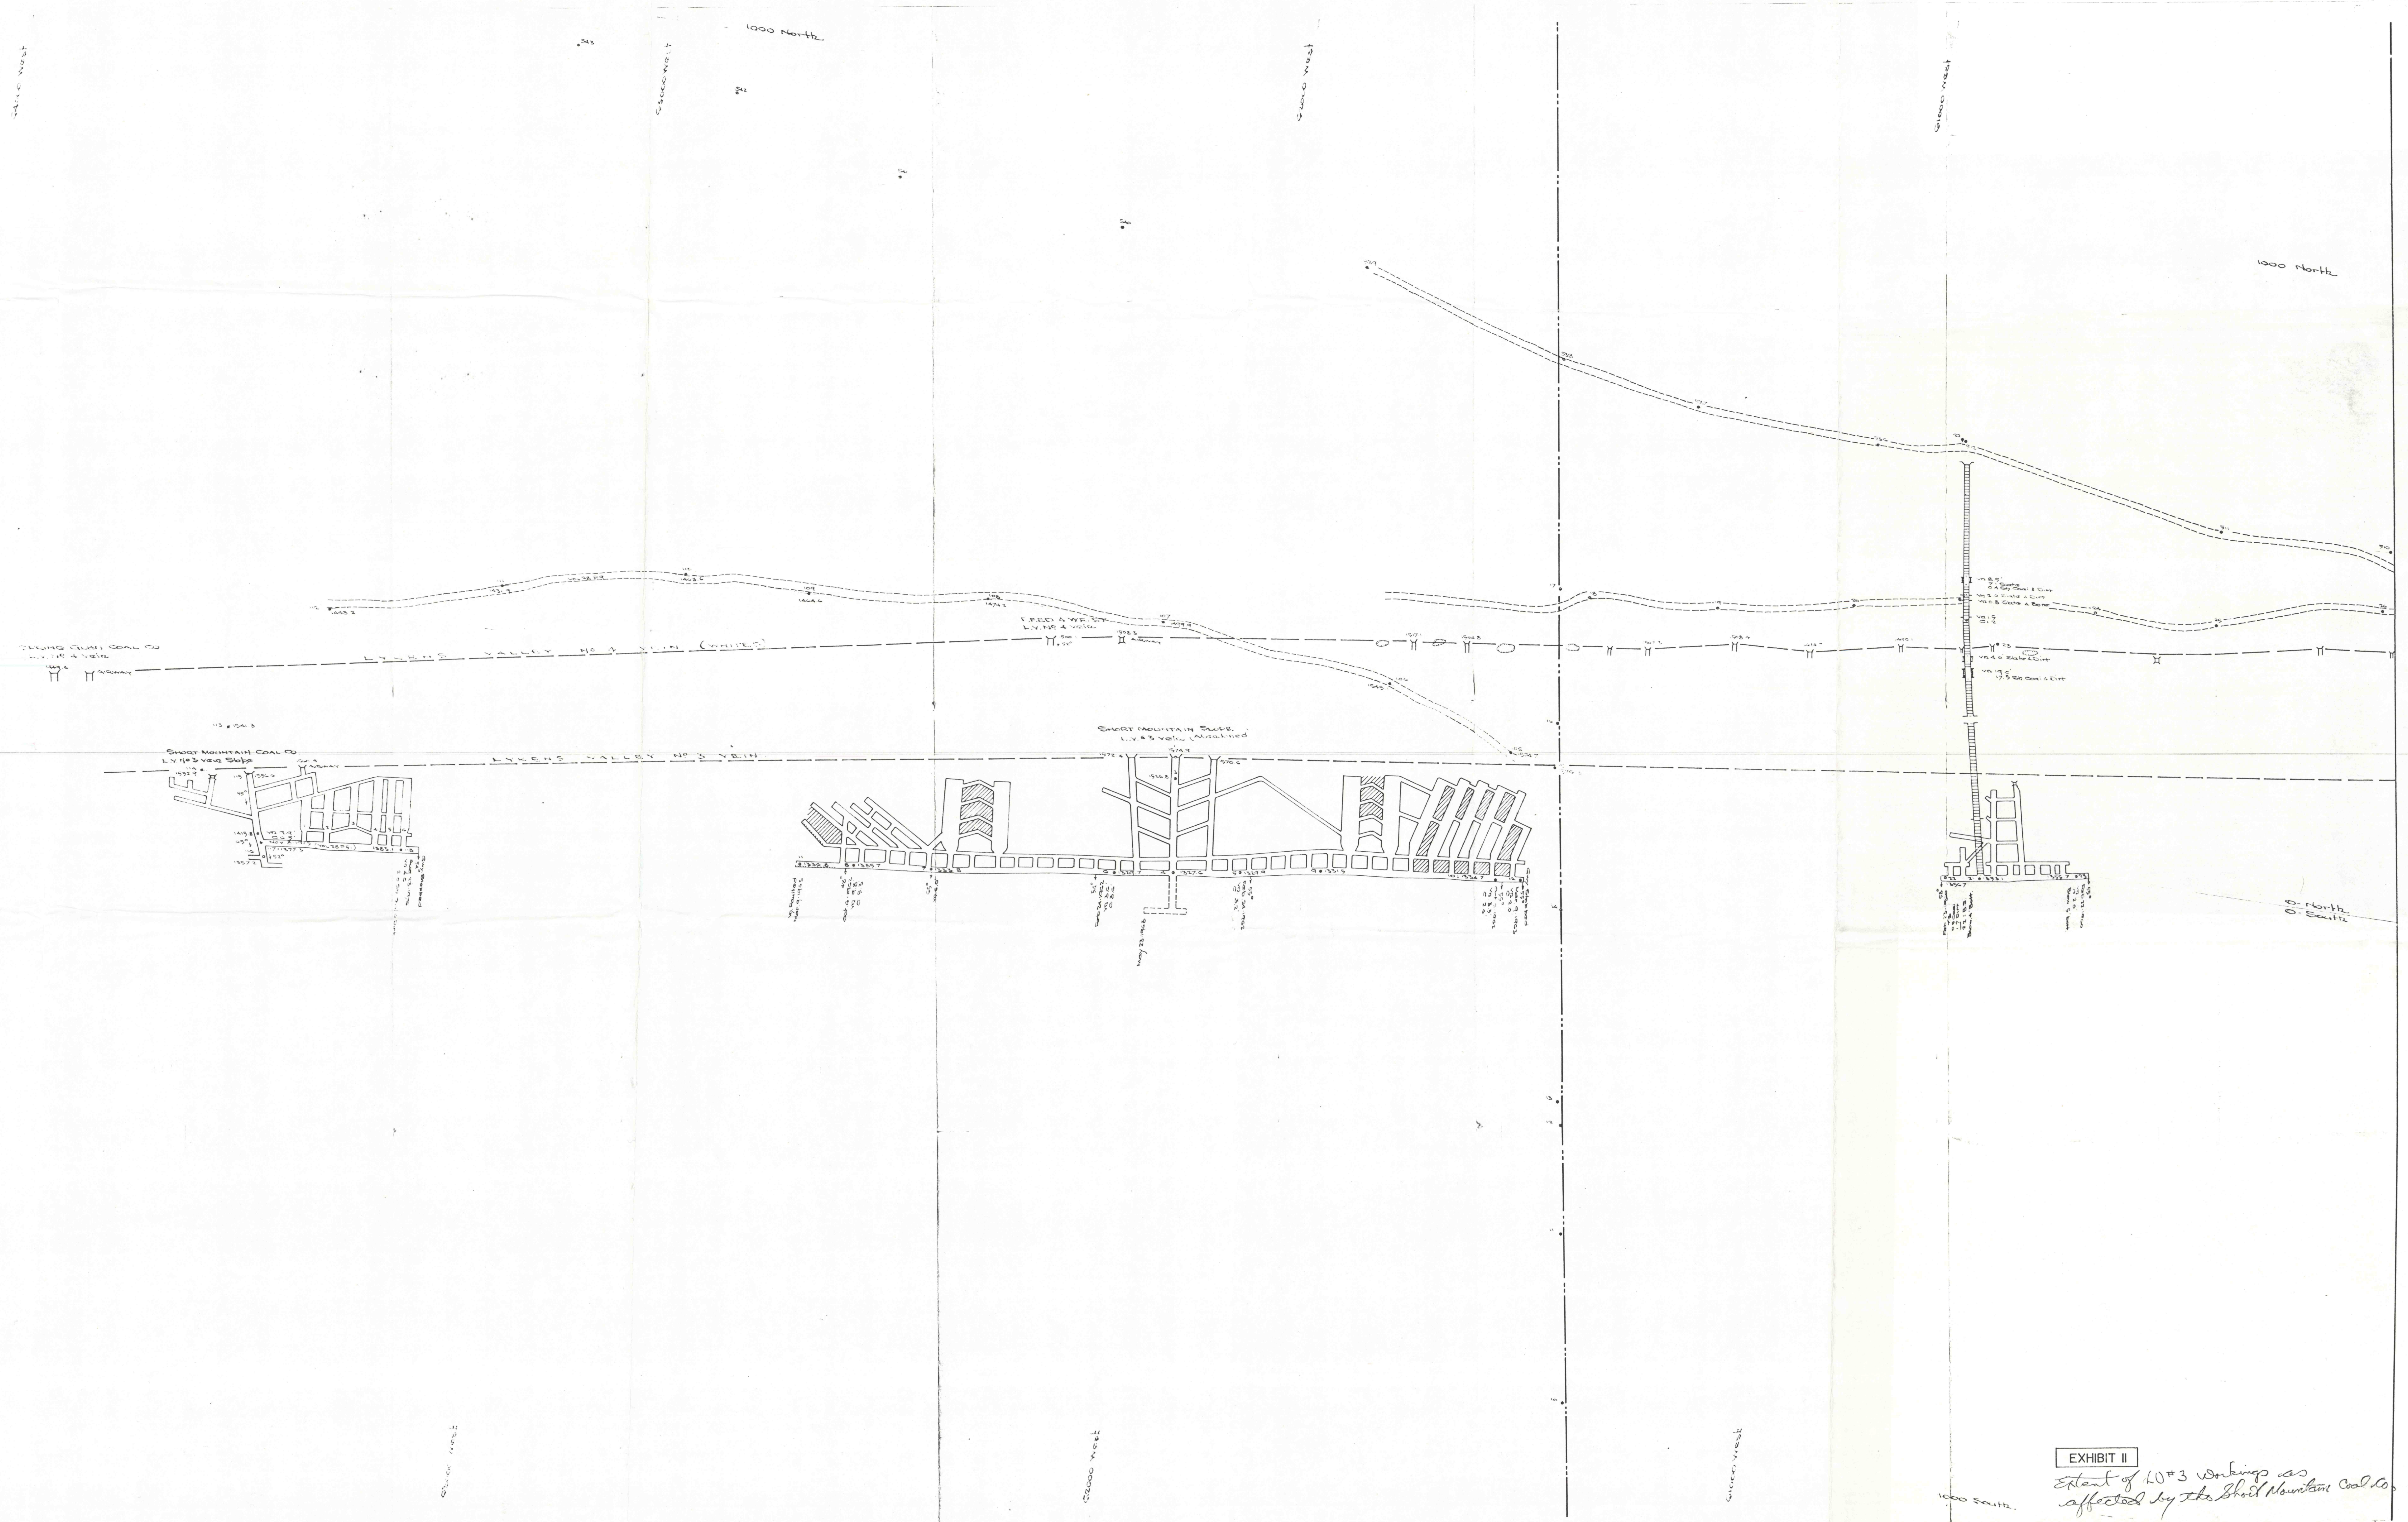


EXHIBIT II
Extent of L0*3 workings as
affected by the Shoot Mountain Coal Co.