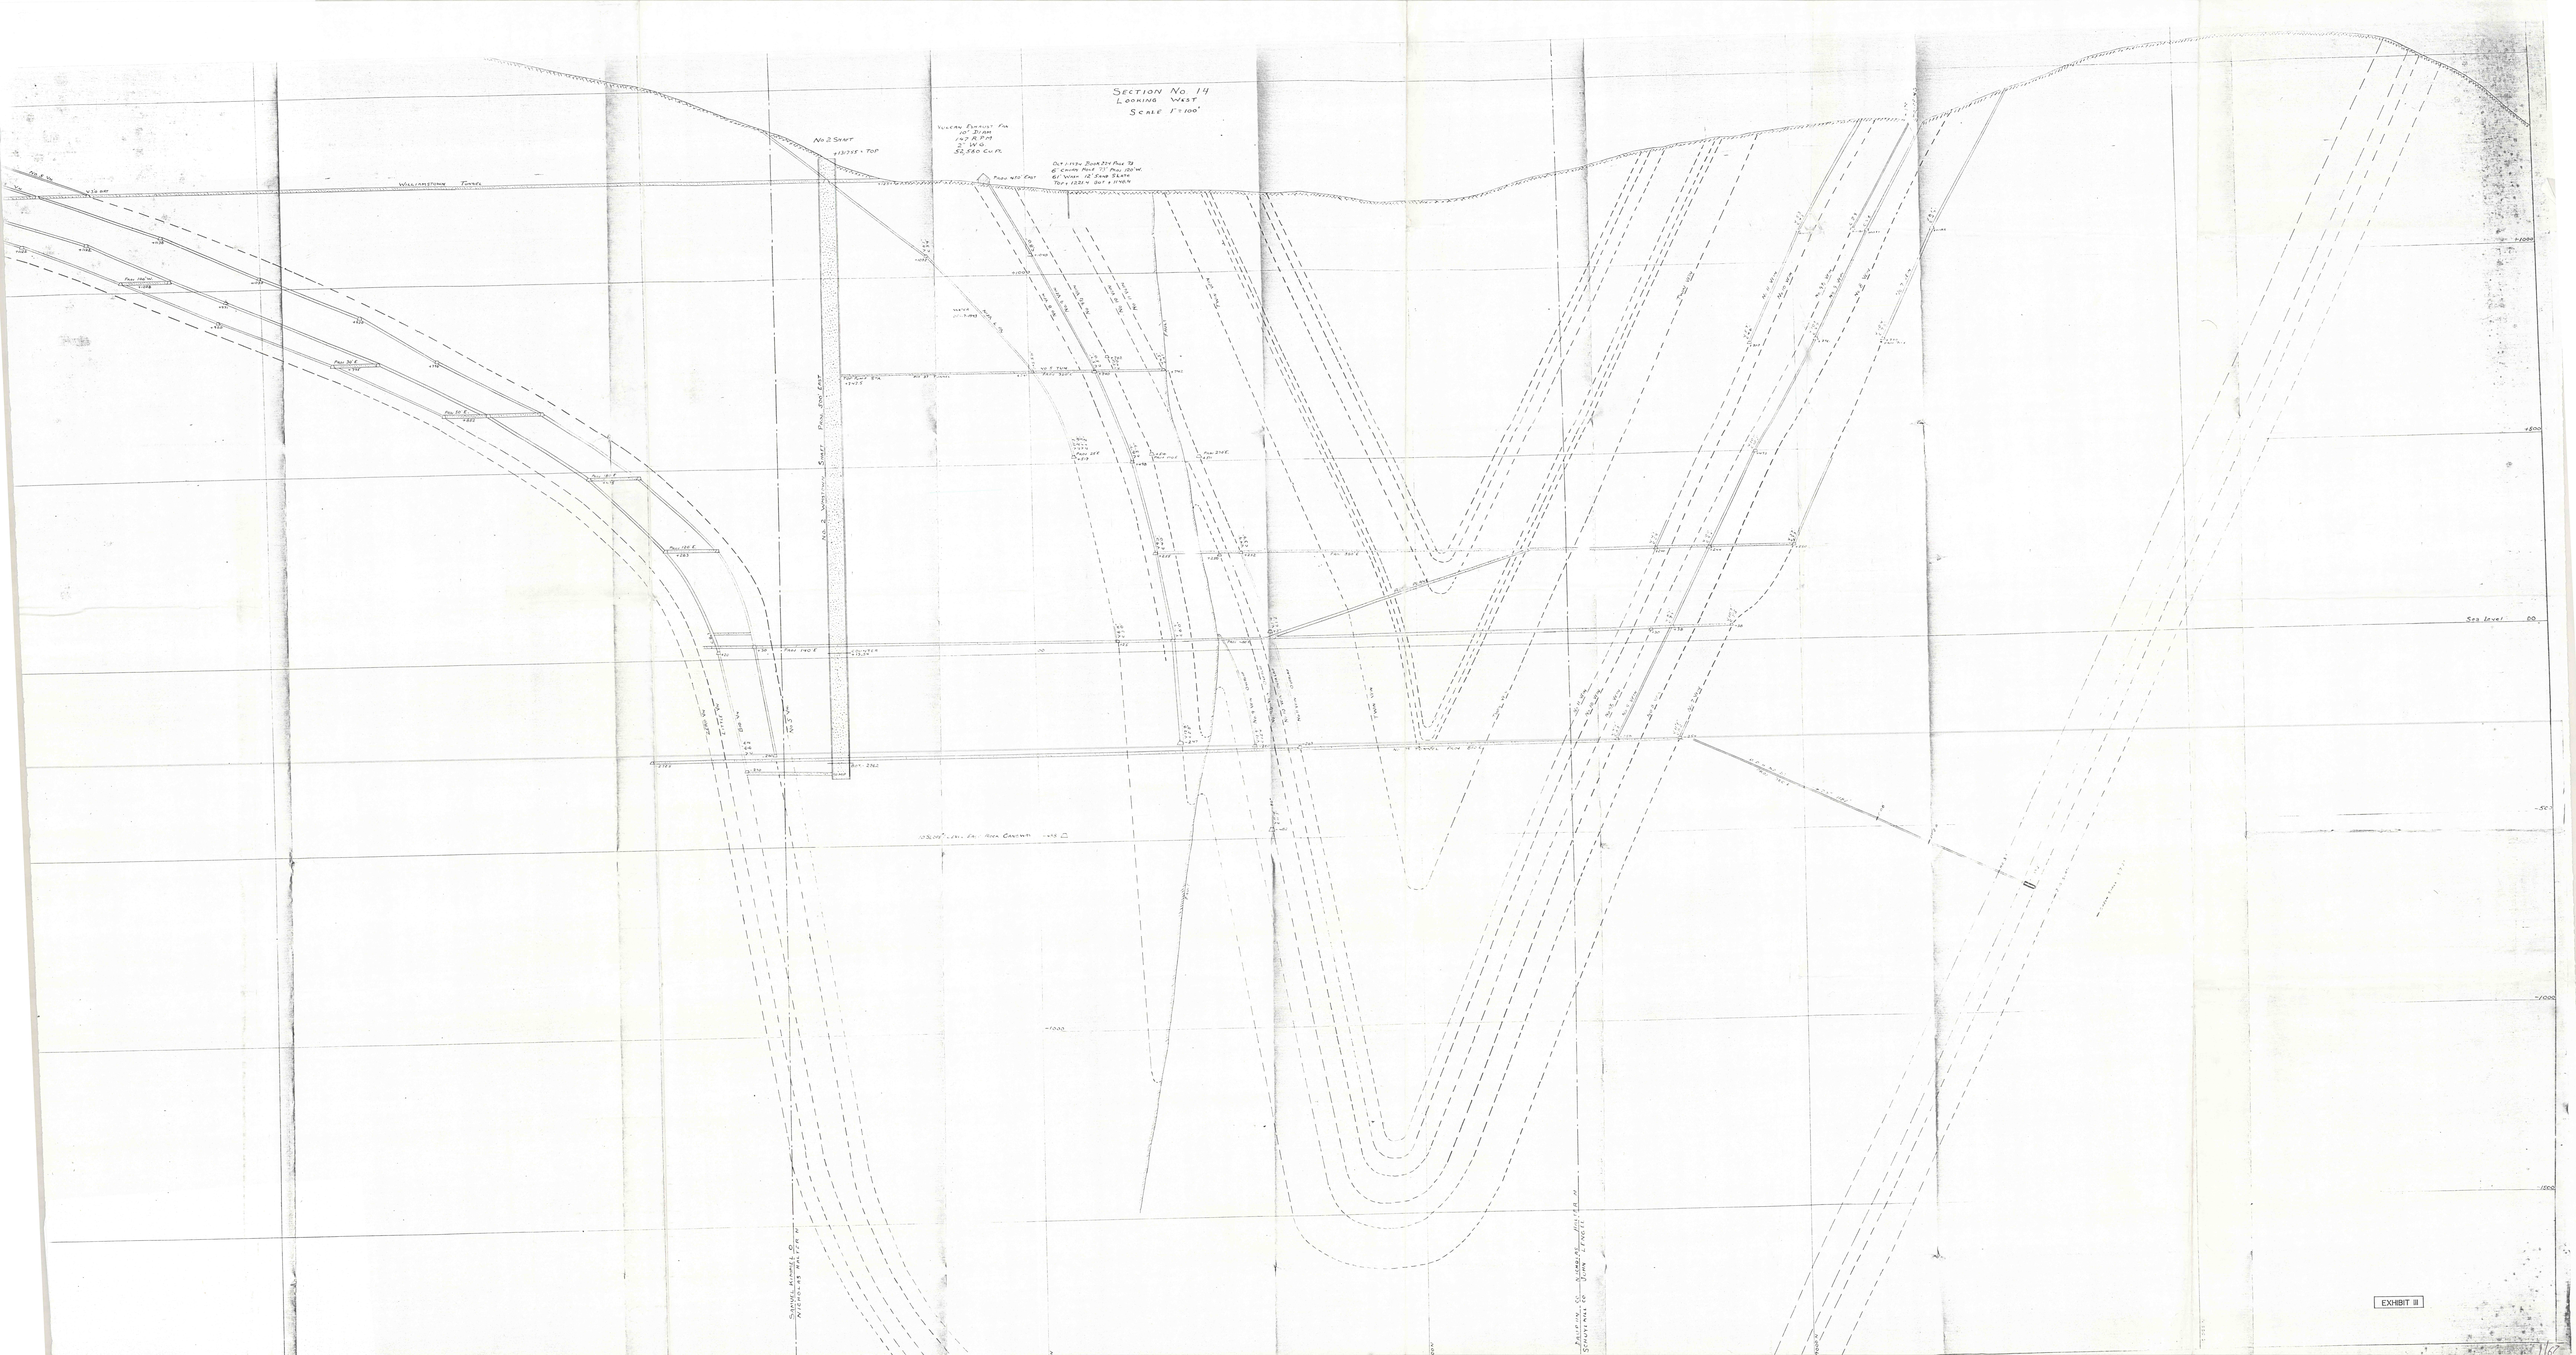

SECTION No. 14
LOOKING WEST
SCALE 1"=100'
No 2 SHAFT
WILLIAMSTOWN TUNNEL
No 2 WORKING SHAFT
PENN. R.R. EAST
Sea level
EXHIBIT III