


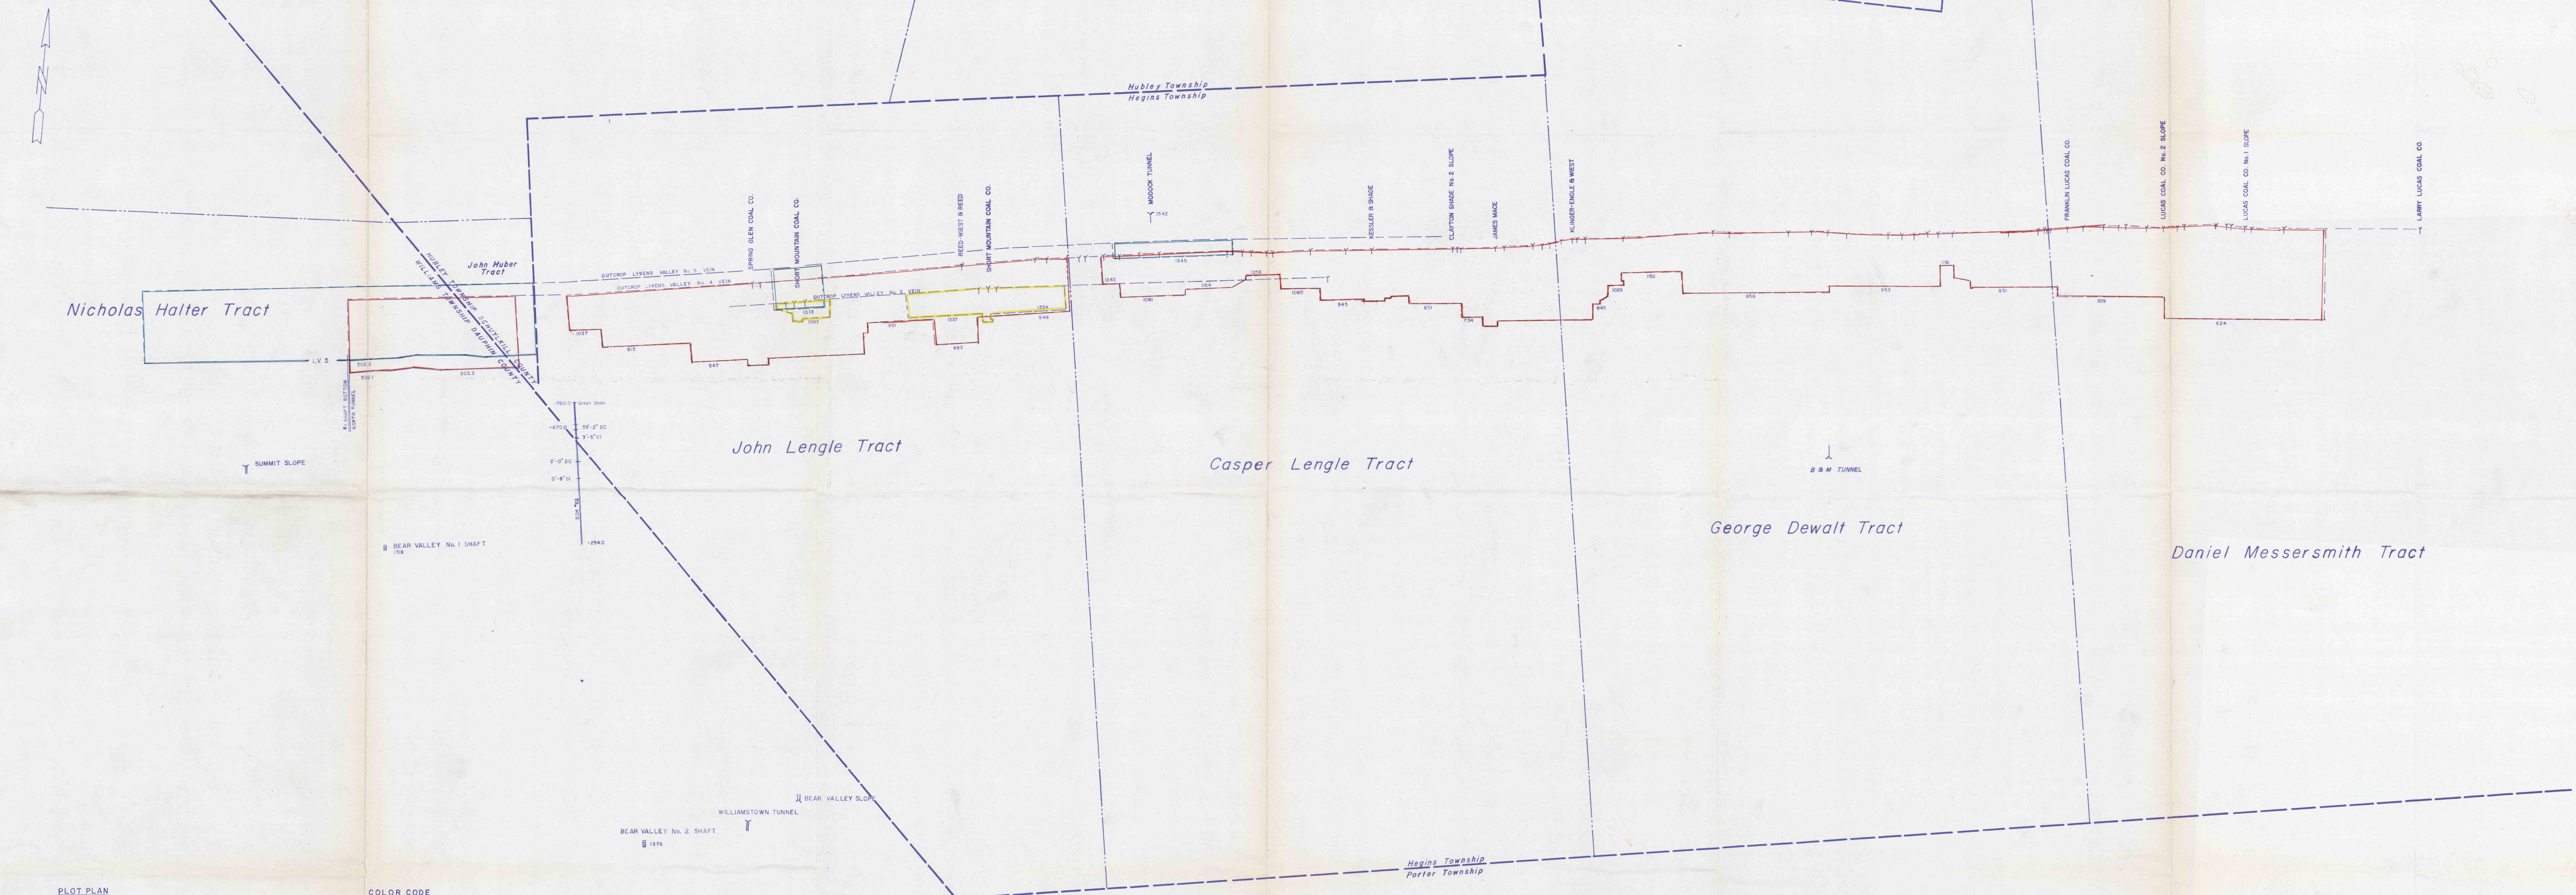

**PLOT PLAN**  
for  
International Anthracite Corporation  
showing  
Known Extent Of Abandoned Mining  
A.B. Riedel, Min. Engr. Sept. 20, 1987

**COLOR CODE**  
Lykens Valley No. 3 Vein  
Lykens Valley No. 4 Vein  
Lykens Valley No. 5 Vein

\* Tracing of a Map Drawn by A.B. Riedel for International Anthracite Corporation

85 1172