


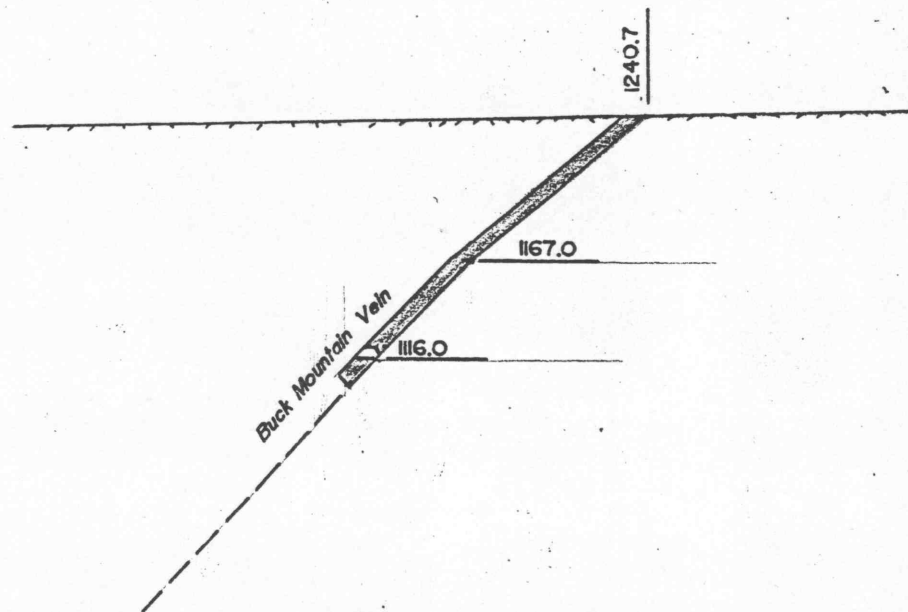


Mouth of Rowe Tunnel = 961 ft. A.M.T.

DATUM 900 ft. A.M.T.

Cross Section
Through
Little Buck Coal Company's
No.3 Slope

LOOKING WEST

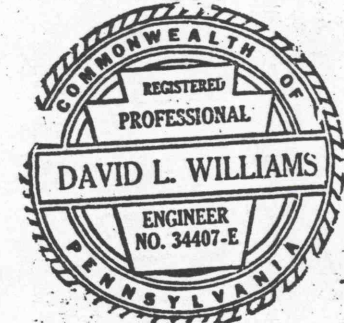

May 22, 1997

I.D.#36-08568

Scale: 1" = 100'