


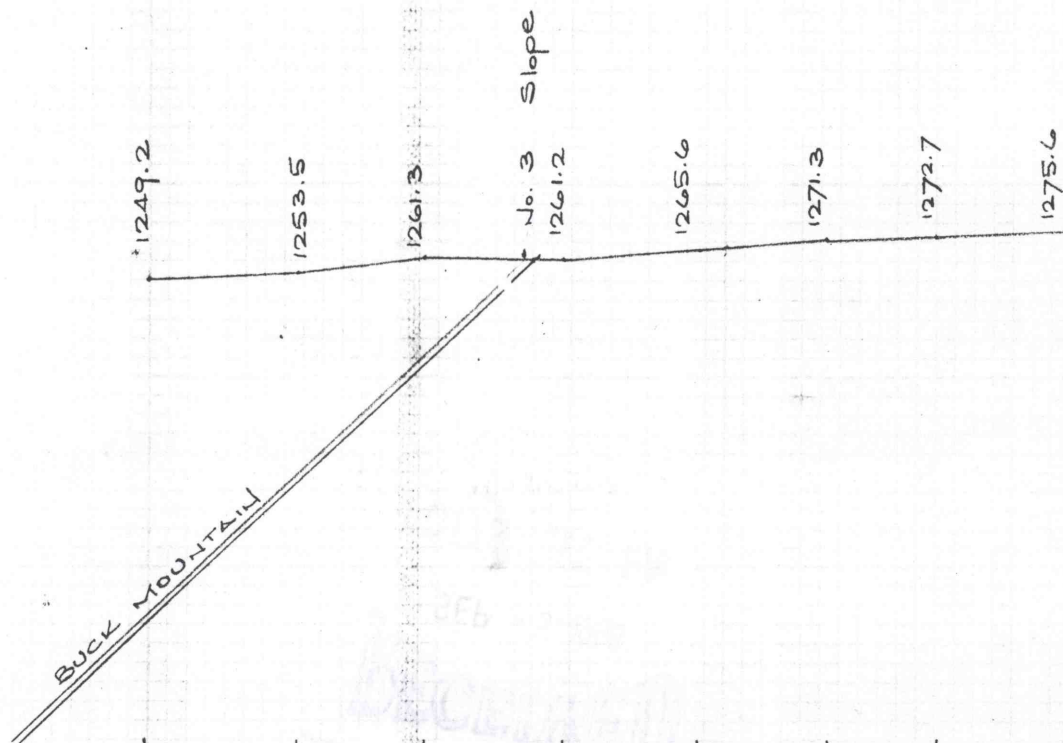

CROSS-SECTION THRU LITTLE BUCK
COAL COMPANY'S NO. 3 SLOPE

David Williams

SCALE: 1" = 100'

1186 I.D. # 36-08568
986 SEPT. 4, 1996