


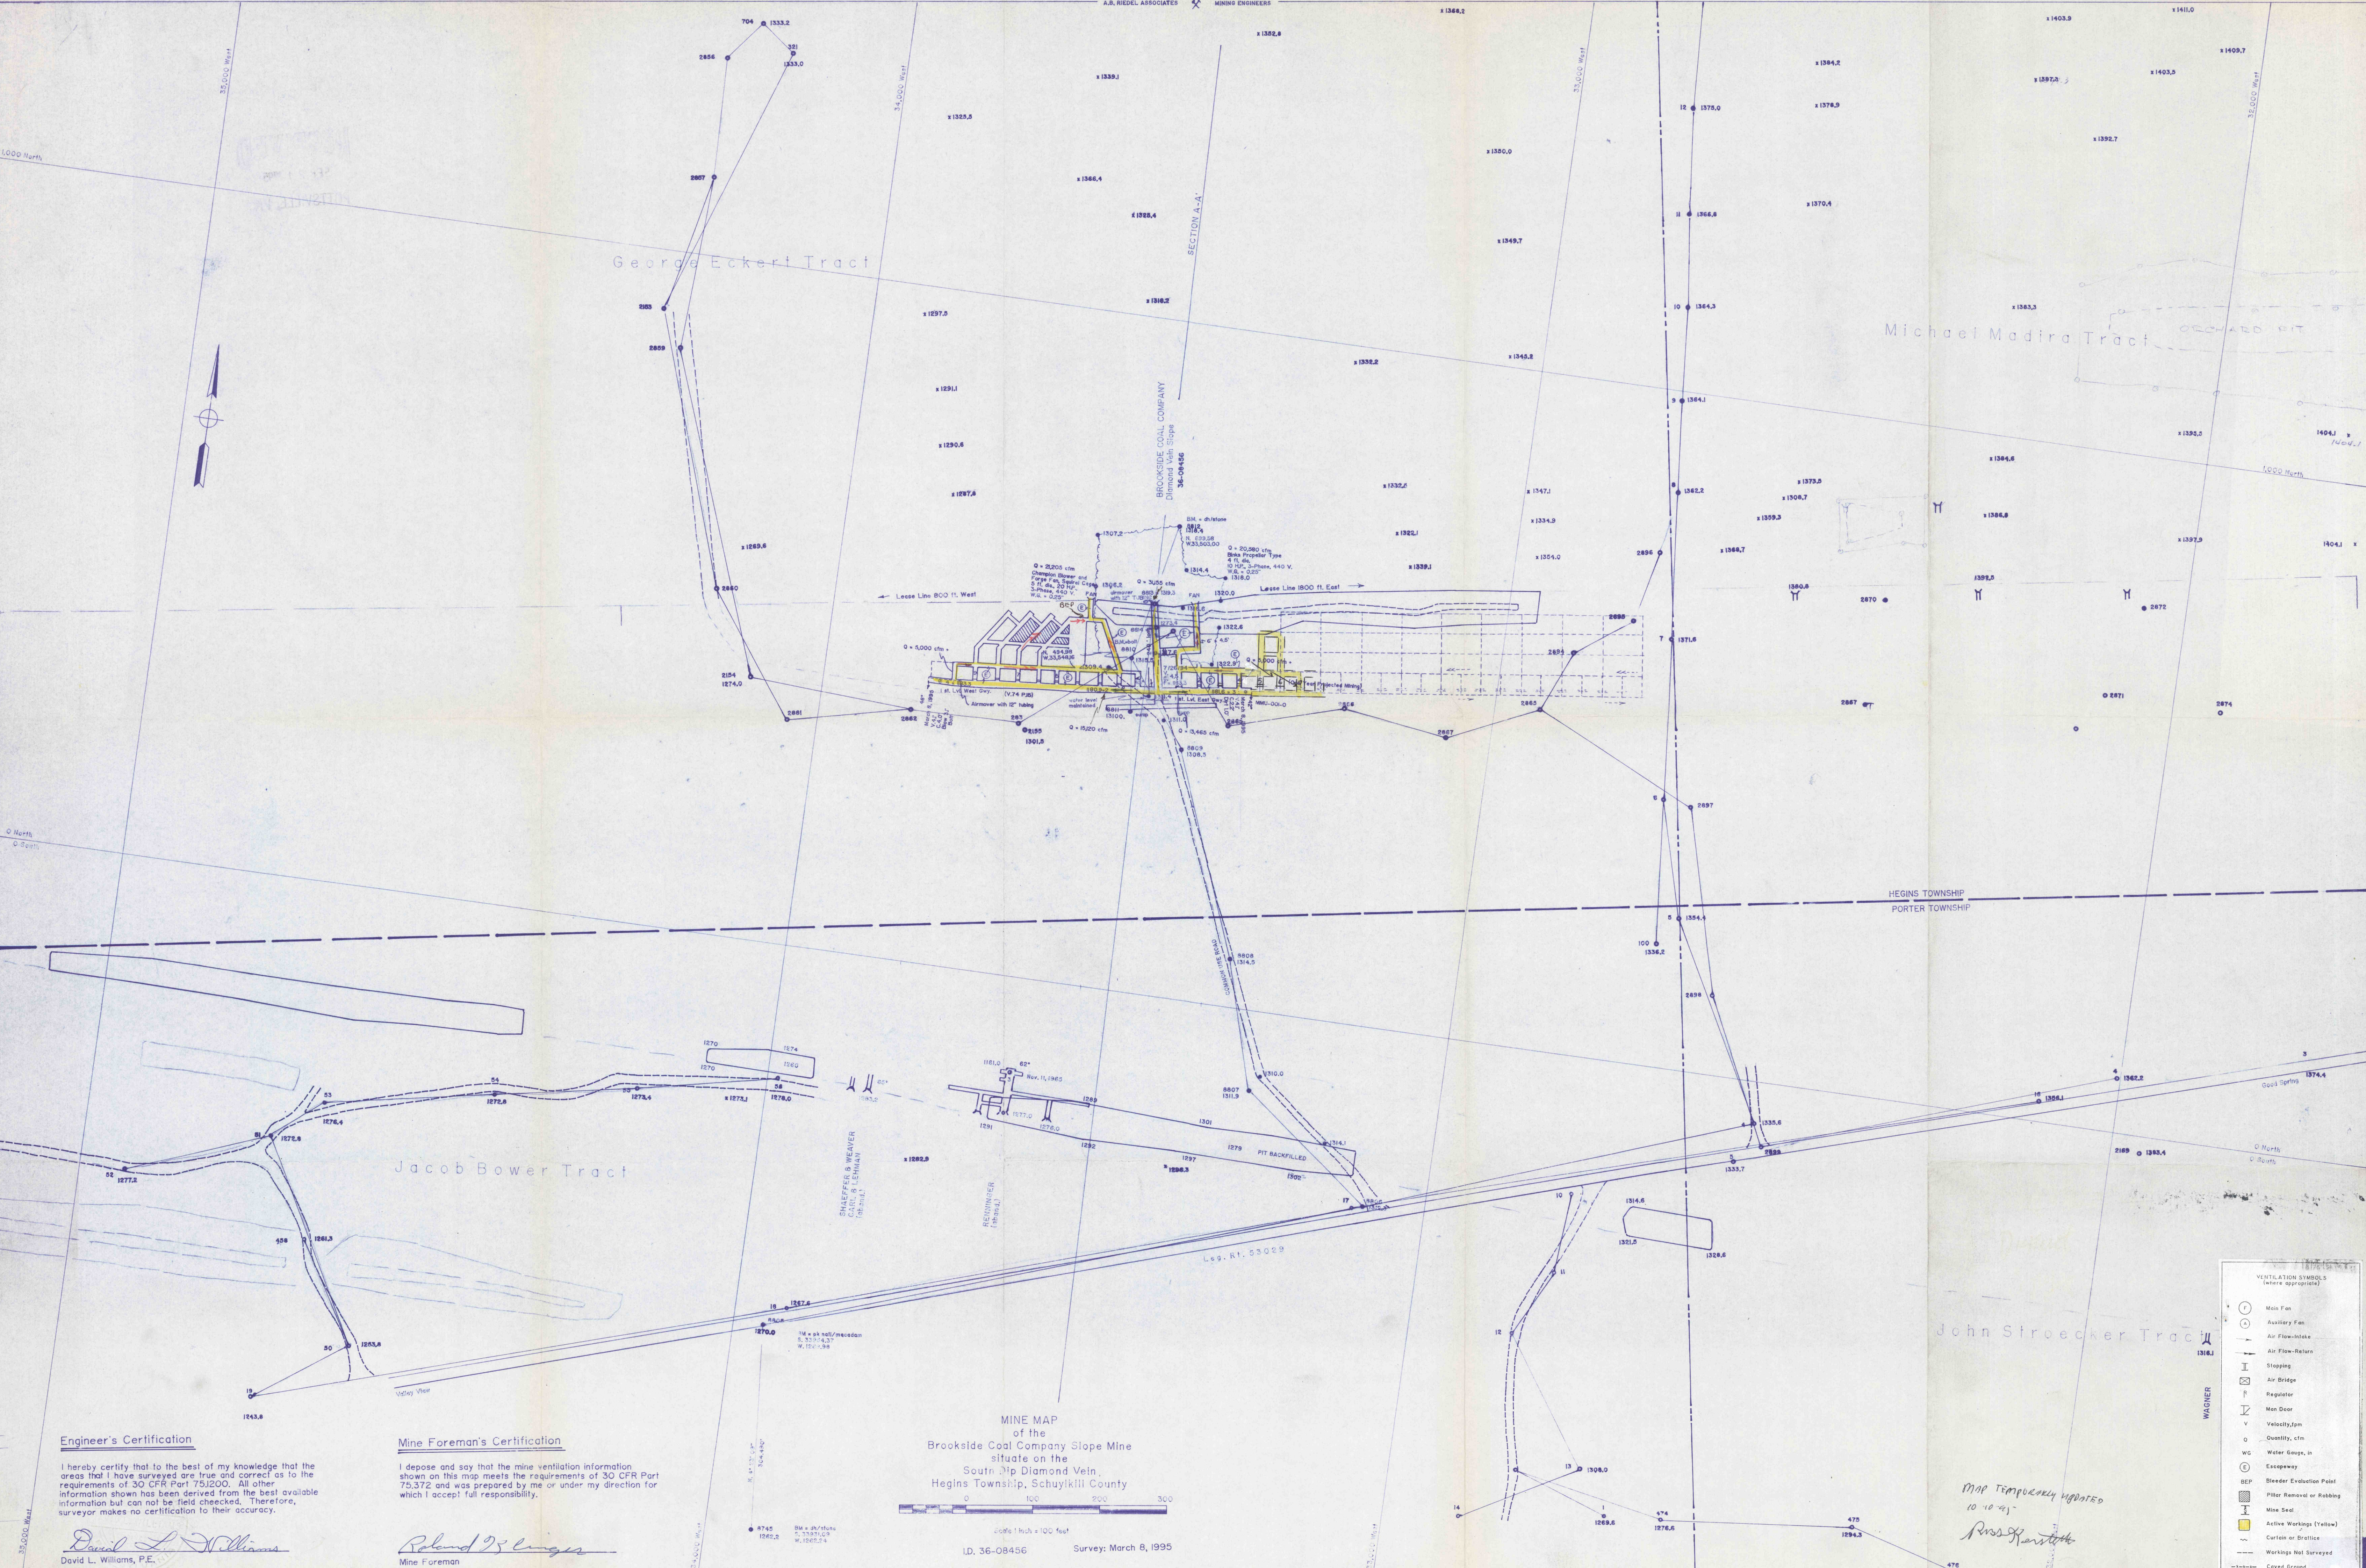

Engineer's Certification

I hereby certify that to the best of my knowledge that the areas that I have surveyed are true and correct as to the requirements of 30 CFR Part 751200. All other information shown has been derived from the best available information but can not be field checked. Therefore, surveyor makes no certification to their accuracy.

David L. Williams
David L. Williams, P.E.

Mine Foreman's Certification

I depose and say that the mine ventilation information shown on this map meets the requirements of 30 CFR Part 75.372 and was prepared by me or under my direction for which I accept full responsibility.

Robert D. Lingus
Mine Foreman

MINE MAP
of the
Brookside Coal Company Slope Mine
situate on the
South Dip Diamond Vein,
Hegns Township, Schuylkill County
I.D. 36-08456
Survey: March 8, 1995

- VENTILATION SYMBOLS
(where appropriate)
- Main Fan
 - Auxiliary Fan
 - Air Flow-Intake
 - Air Flow-Return
 - Stopping
 - Air Bridge
 - Regulator
 - Men Door
 - Velocity, fpm
 - Quantity, cfm
 - Water Gauge, in
 - Escapeway
 - BEP - Bleeder Evolution Point
 - Pillar Removal or Robbing
 - Mine Seal
 - Active Workings (Yellow)
 - Curtain or Brattice
 - Workings Not Surveyed
 - Covered Ground
- WAGNER

MAP TEMPORARILY UPDATED
10-10-91
Ross