


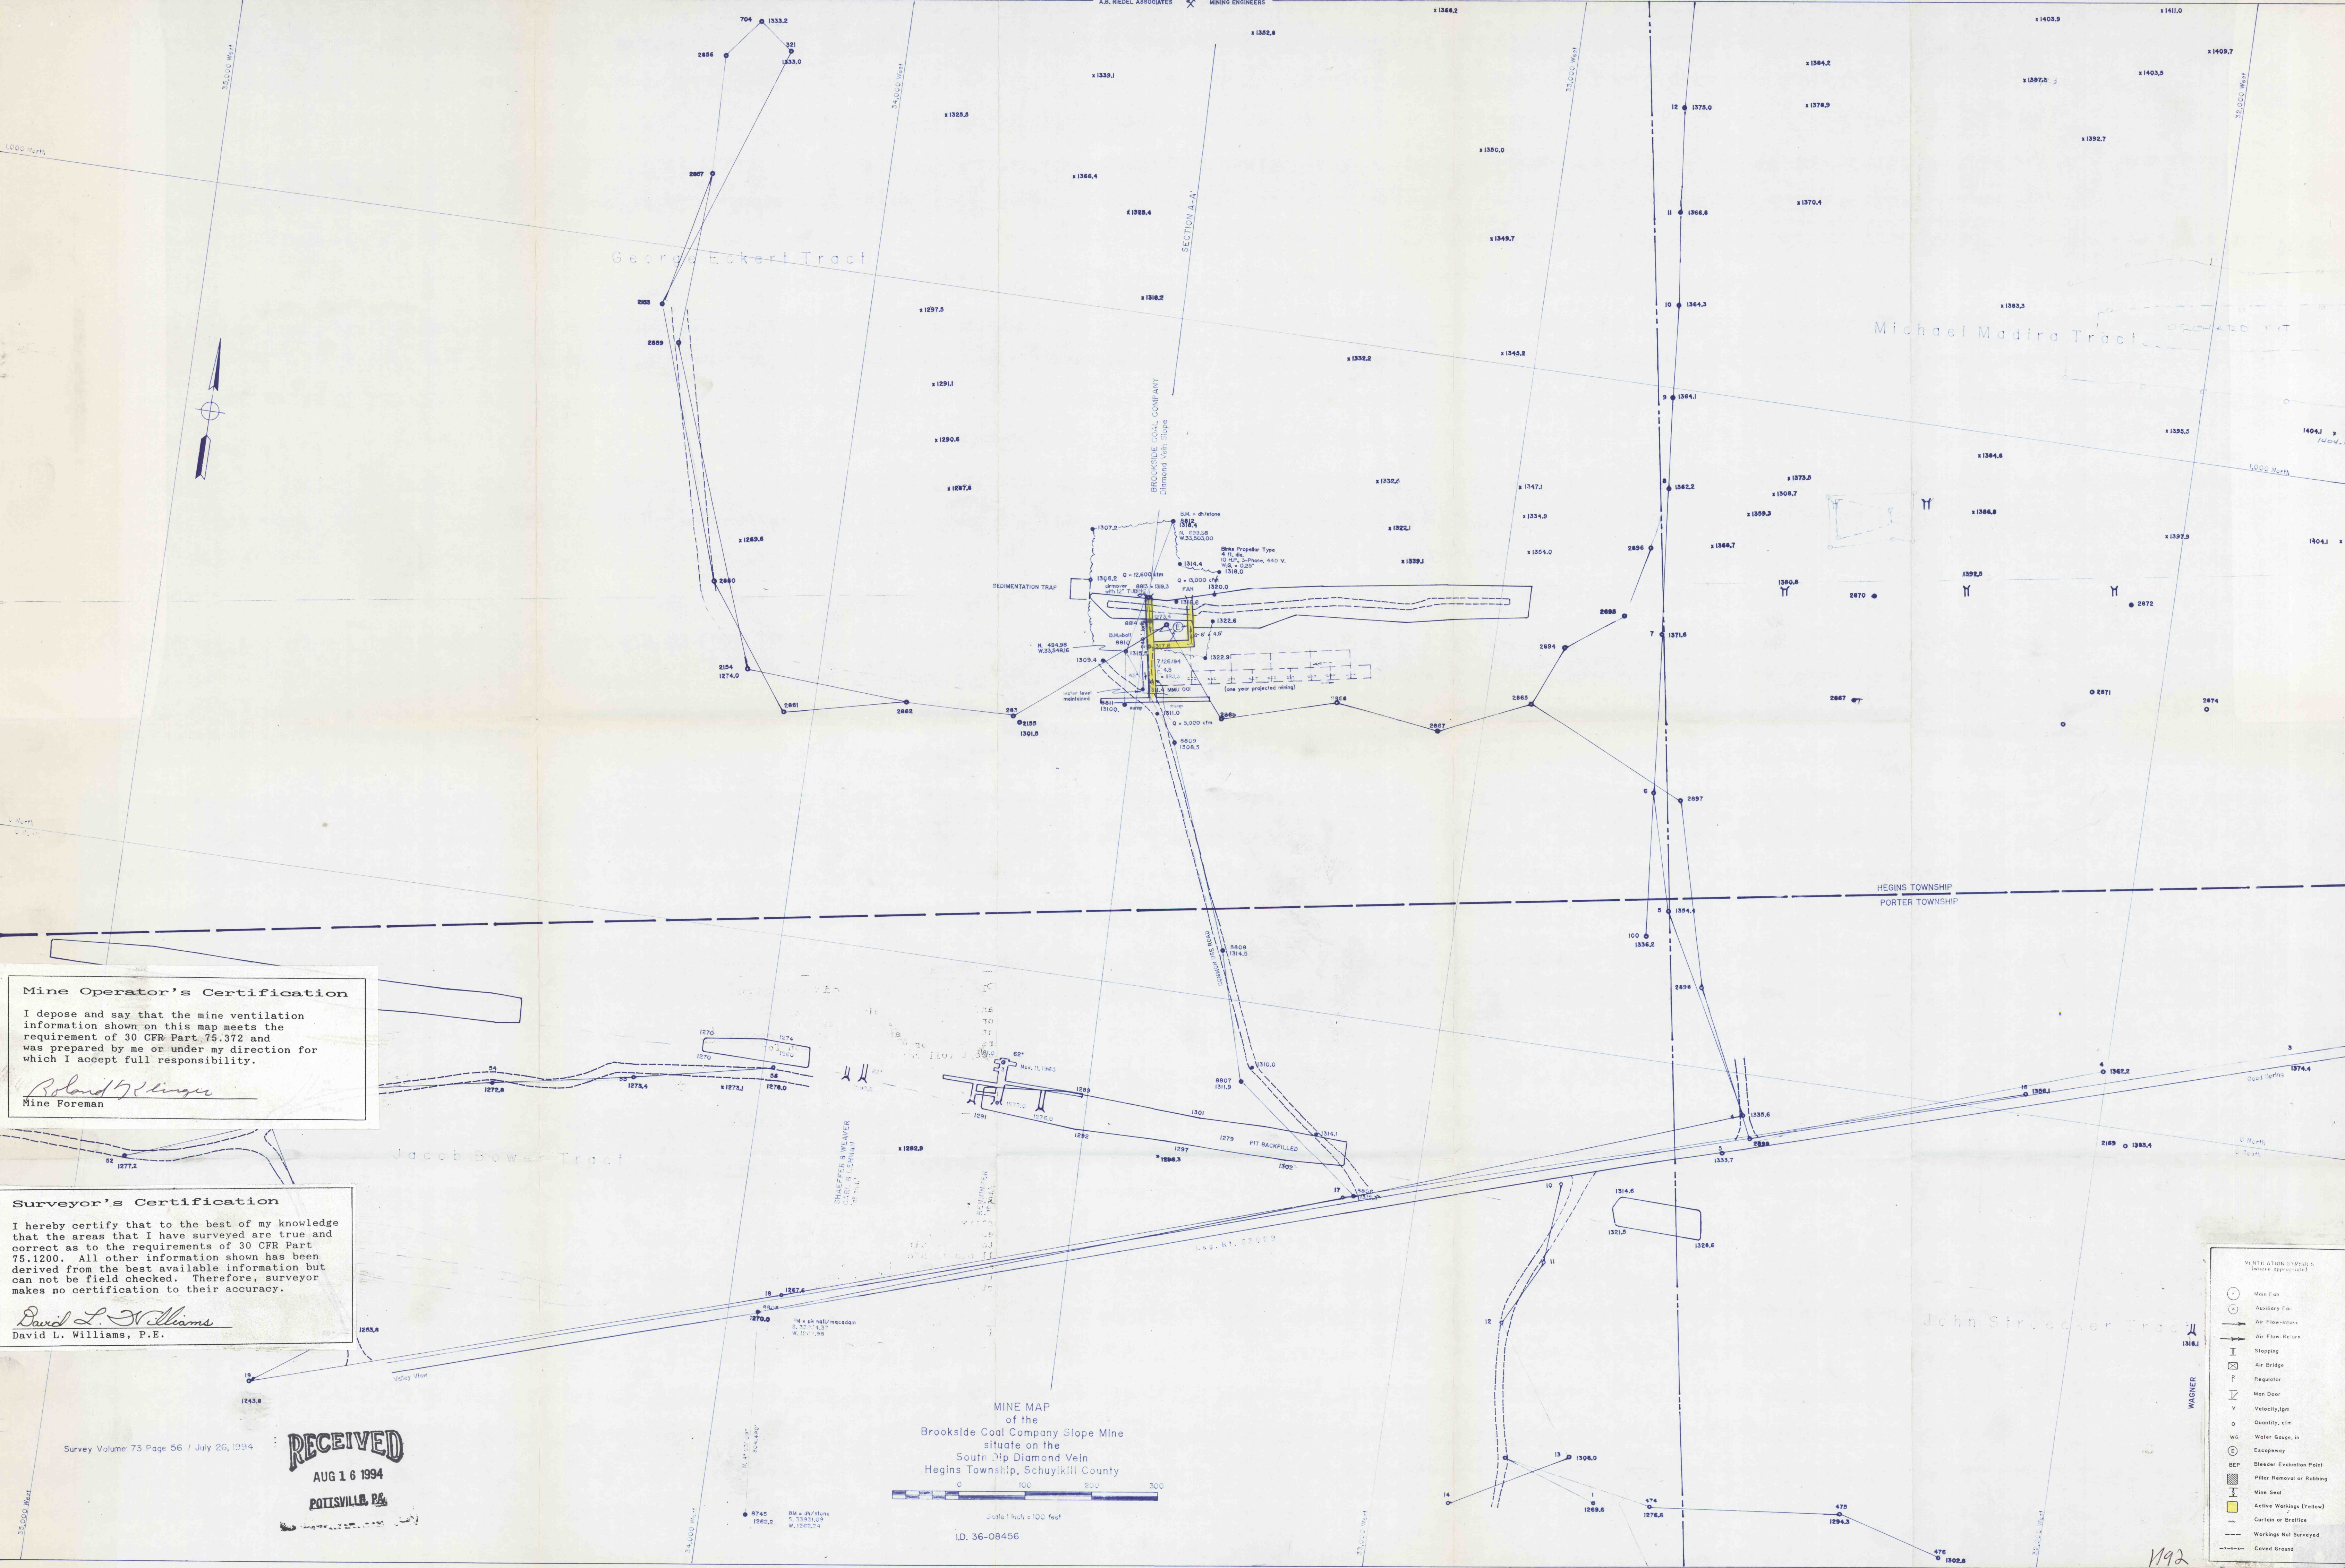

Mine Operator's Certification

I depose and say that the mine ventilation information shown on this map meets the requirement of 30 CFR Part 75.372 and was prepared by me or under my direction for which I accept full responsibility.

Roland H. Lingner
Mine Foreman

Surveyor's Certification

I hereby certify that to the best of my knowledge that the areas that I have surveyed are true and correct as to the requirements of 30 CFR Part 75.1200. All other information shown has been derived from the best available information but can not be field checked. Therefore, surveyor makes no certification to their accuracy.

David L. Williams
David L. Williams, P.E.

Survey Volume 73 Page 56 / July 26, 1994

RECEIVED
AUG 16 1994
POTTSVILLE, PA

MINE MAP
of the
Brookside Coal Company Slope Mine
situated on the
South Dip Diamond Vein
Hegins Township, Schuylkill County

Scale: 1 inch = 100 feet

I.D. 36-08456

- LEGEND**
- Main Fan
 - Auxiliary Fan
 - Air Flow Intake
 - Air Flow Return
 - Stopping
 - Air Bridge
 - Register
 - Man Door
 - Velocity/gpm
 - Quantity, cfm
 - Water Gauge, in
 - Escapeway
 - BEP
 - Bleeder Evaluation Point
 - Pillar Removal or Rabbet
 - Mine Seal
 - Active Workings (Yellow)
 - Curbin or Brattice
 - Workings Not Surveyed
 - Caved Ground