


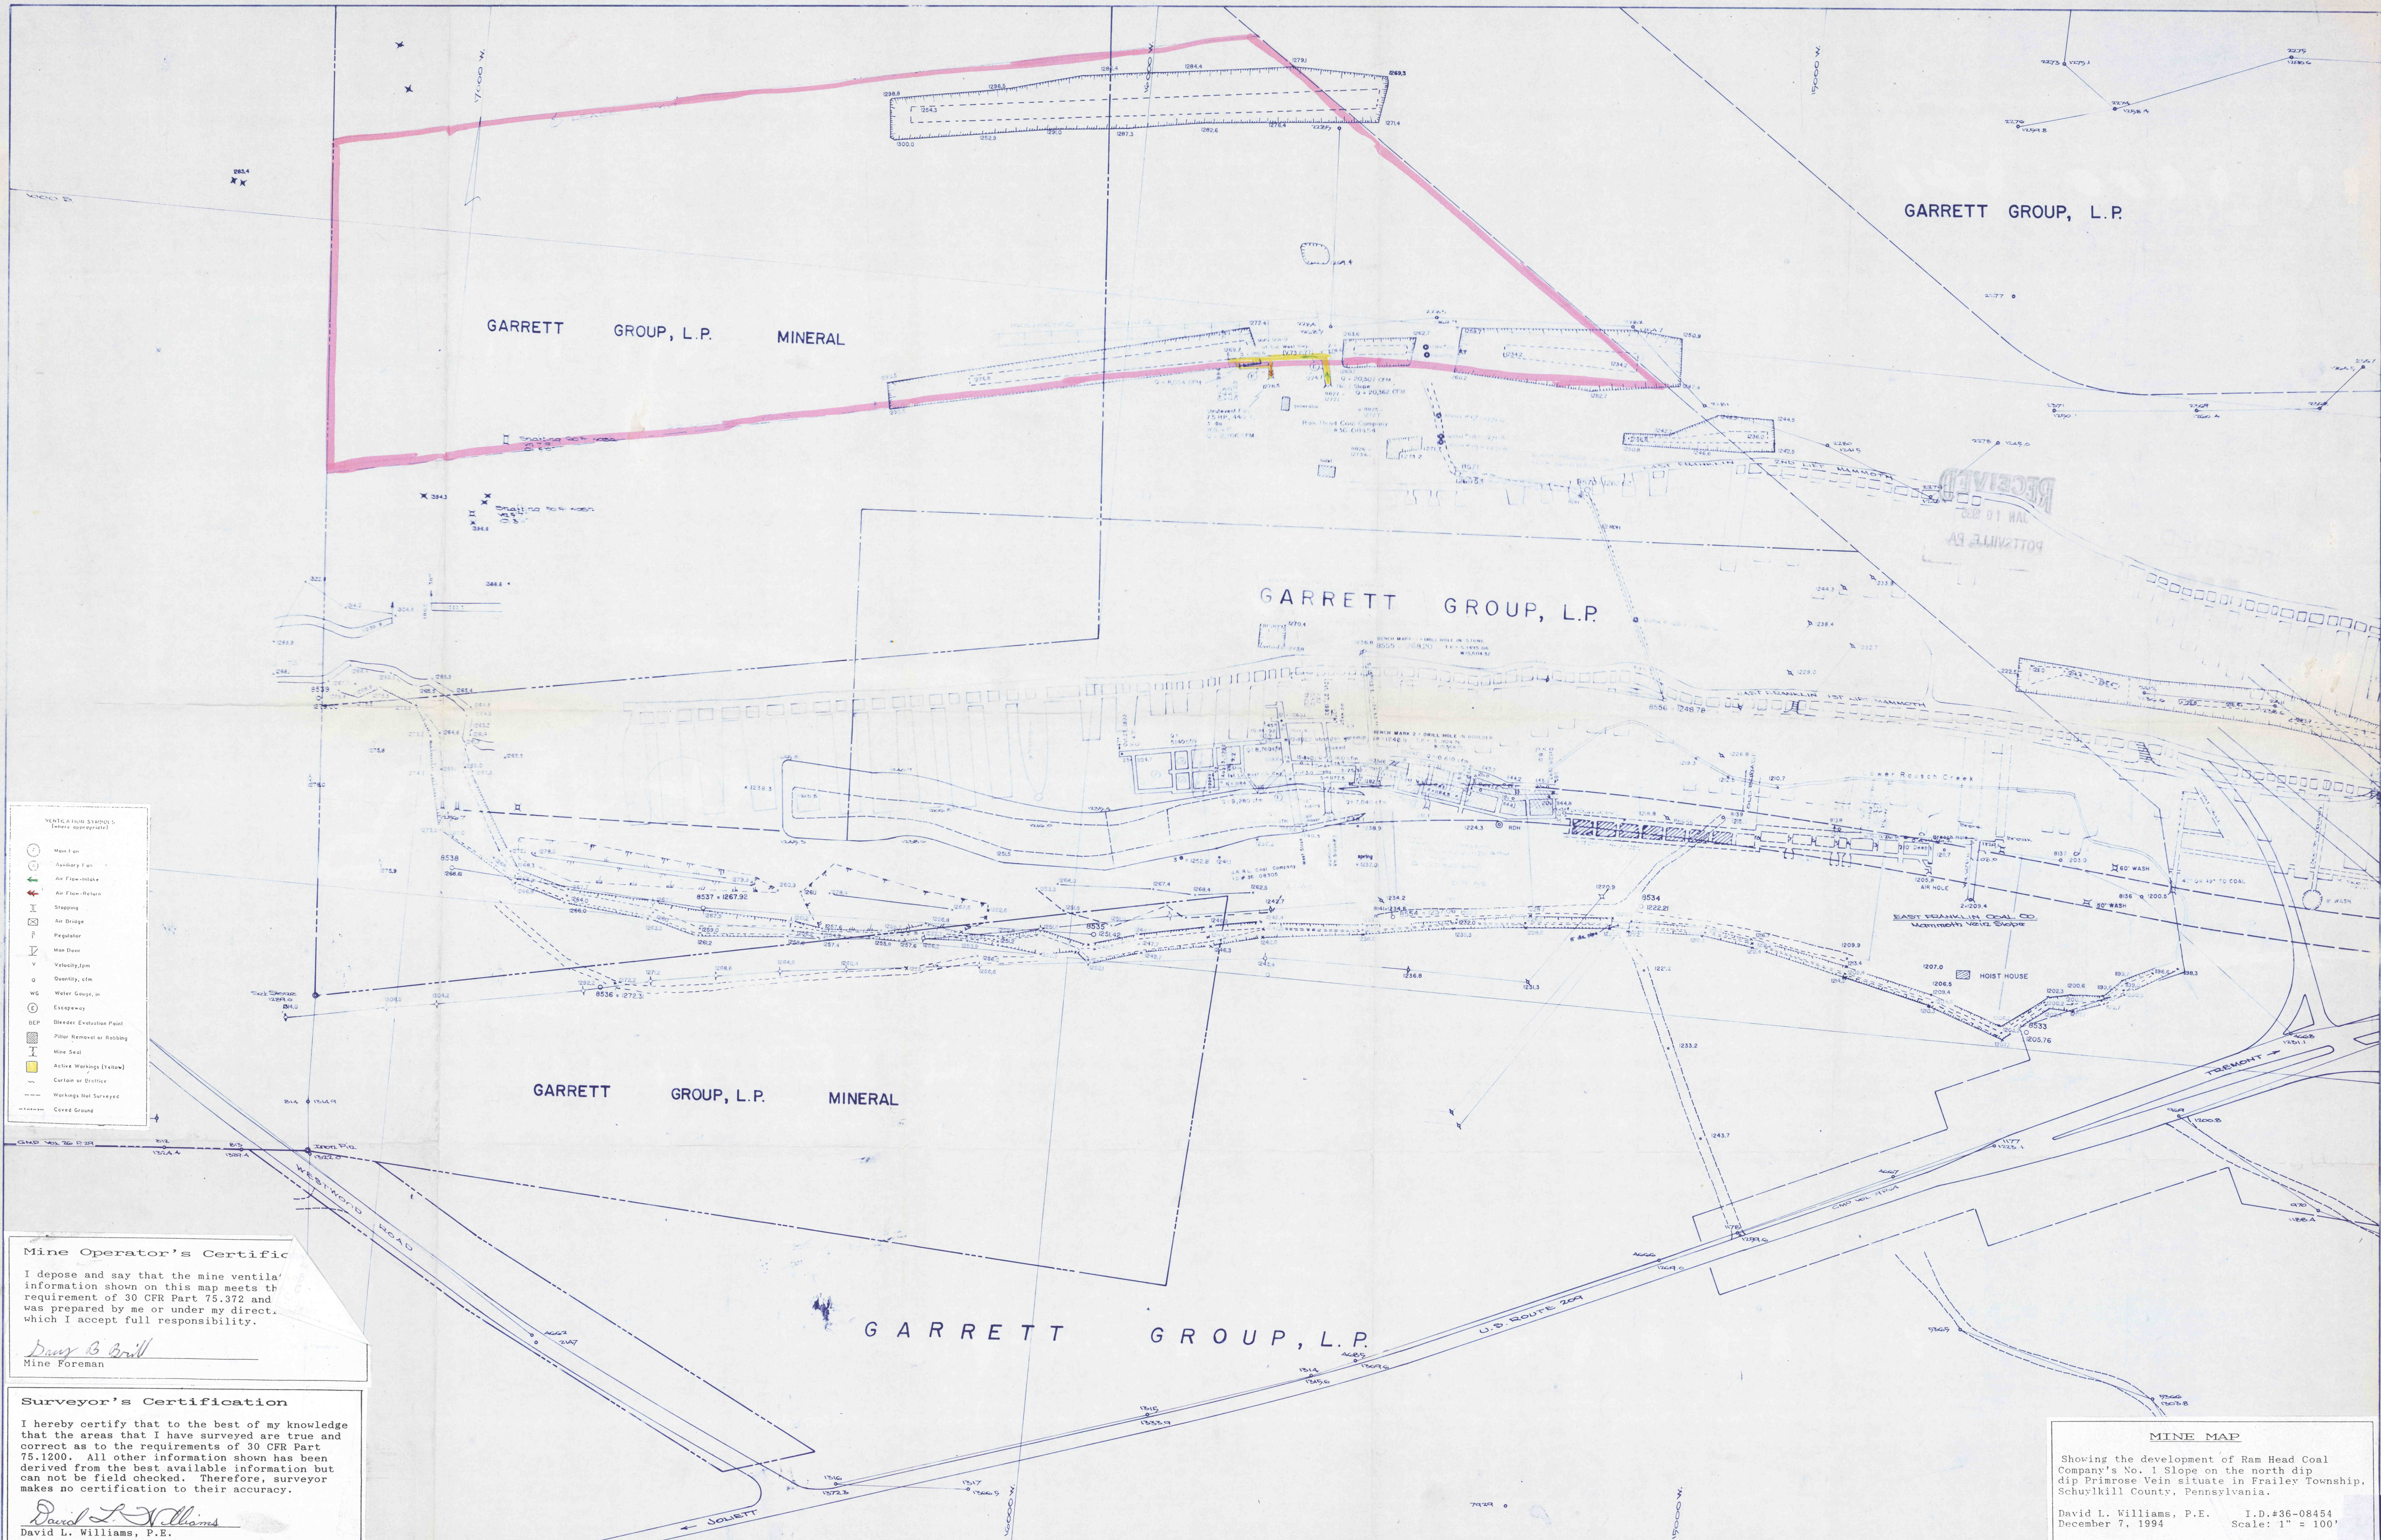

- VENTILATION SYSTEMS
(Where appropriate)
- Man Fan
 - Auxiliary Fan
 - Air Flow-Inlet
 - Air Flow-Return
 - Stopping
 - Air Bridge
 - Regulator
 - Man Door
 - Velocity Jan
 - Quantity, cfm
 - Water Gauge, in
 - Escapeway
 - Bleeder Evolution Point
 - Pillar Removal or Robbing
 - Mine Seal
 - Active Workings (Yellow)
 - Current or Electric
 - Workings Not Surveyed
 - Covered Ground

Mine Operator's Certificate

I depose and say that the mine ventilation information shown on this map meets the requirement of 30 CFR Part 75.372 and was prepared by me or under my direct supervision, which I accept full responsibility.

Darryl B. Brill
Mine Foreman

Surveyor's Certification

I hereby certify that to the best of my knowledge that the areas that I have surveyed are true and correct as to the requirements of 30 CFR Part 75.1200. All other information shown has been derived from the best available information but can not be field checked. Therefore, surveyor makes no certification to their accuracy.

David L. Williams
David L. Williams, P.E.

MINE MAP

Showing the development of Ram Head Coal Company's No. 1 Slope on the north dip of the Primrose Vein situated in Frailey Township, Schuylkill County, Pennsylvania.

David L. Williams, P.E. I.D.#36-08454
December 7, 1994 Scale: 1" = 100'