


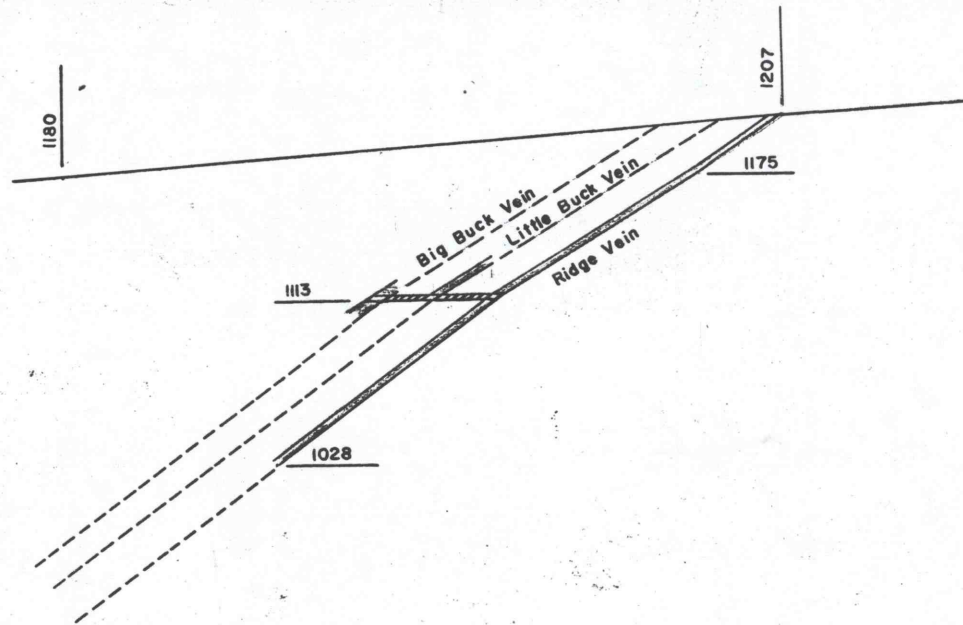

MINE POOL LEVEL = 702

DATUM 700 ft. AMT

Cass Township - Schuylkill County - PA

LOOKING WEST

Cross Section Through Threeway
Coal Company's Ridge Vein Slope

MSHA I.D. #36-08332

David L. Williams
Scale: 1" = 100'