


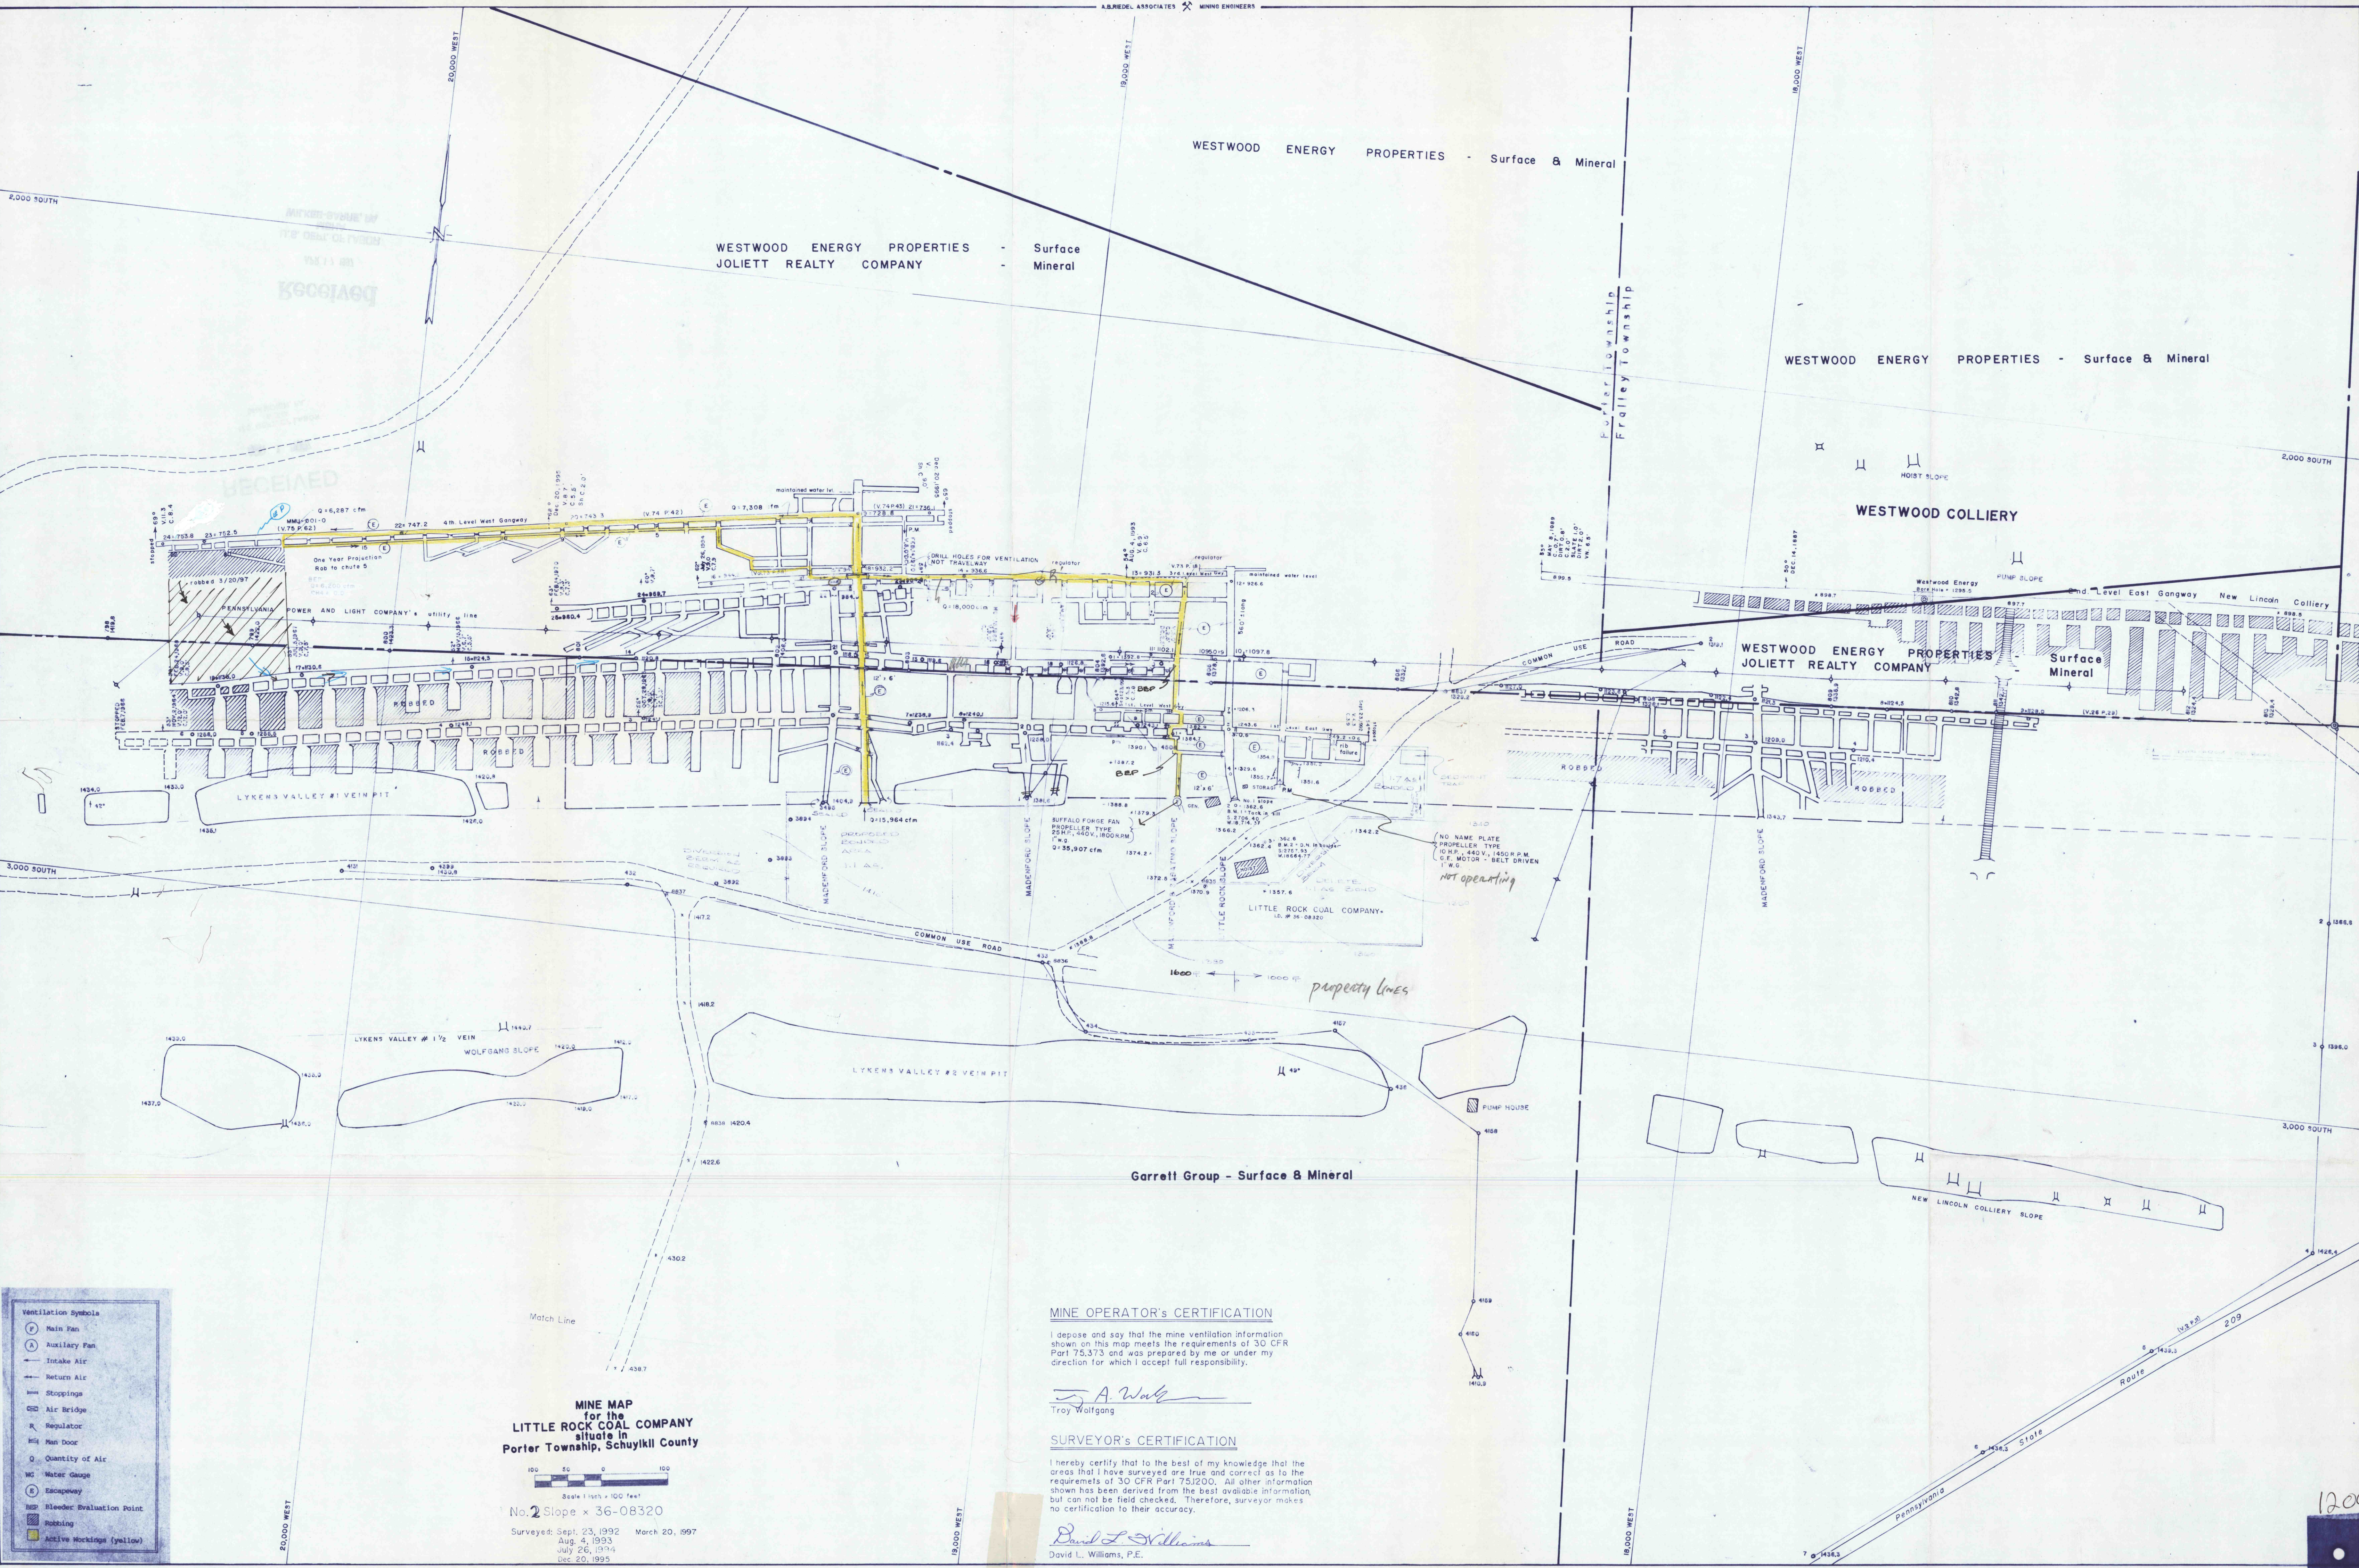

Ventilation Symbols

- Main Fan
- Auxiliary Fan
- Intake Air
- Return Air
- Stoppings
- Air Bridge
- Regulator
- Main Door
- Quantity of Air
- Water Gauge
- Escapeway
- Bleeder Evaluation Point
- Robbing
- Active Rockings (yellow)

MINE MAP
for the
LITTLE ROCK COAL COMPANY
situated in
Porter Township, Schuylkill County

No. 2 Slope x 36-08320
Surveyed: Sept. 23, 1992 March 20, 1997
Aug. 4, 1993
July 26, 1994
Dec. 20, 1995

MINE OPERATOR'S CERTIFICATION
I depose and say that the mine ventilation information shown on this map meets the requirements of 30 CFR Part 75.373 and was prepared by me or under my direction for which I accept full responsibility.

A. Wolf
Troy Wolfgang

SURVEYOR'S CERTIFICATION
I hereby certify that to the best of my knowledge that the areas that I have surveyed are true and correct as to the requirements of 30 CFR Part 75.1200. All other information shown has been derived from the best available information, but can not be field checked. Therefore, surveyor makes no certification to its accuracy.

David L. Williams
David L. Williams, P.E.