



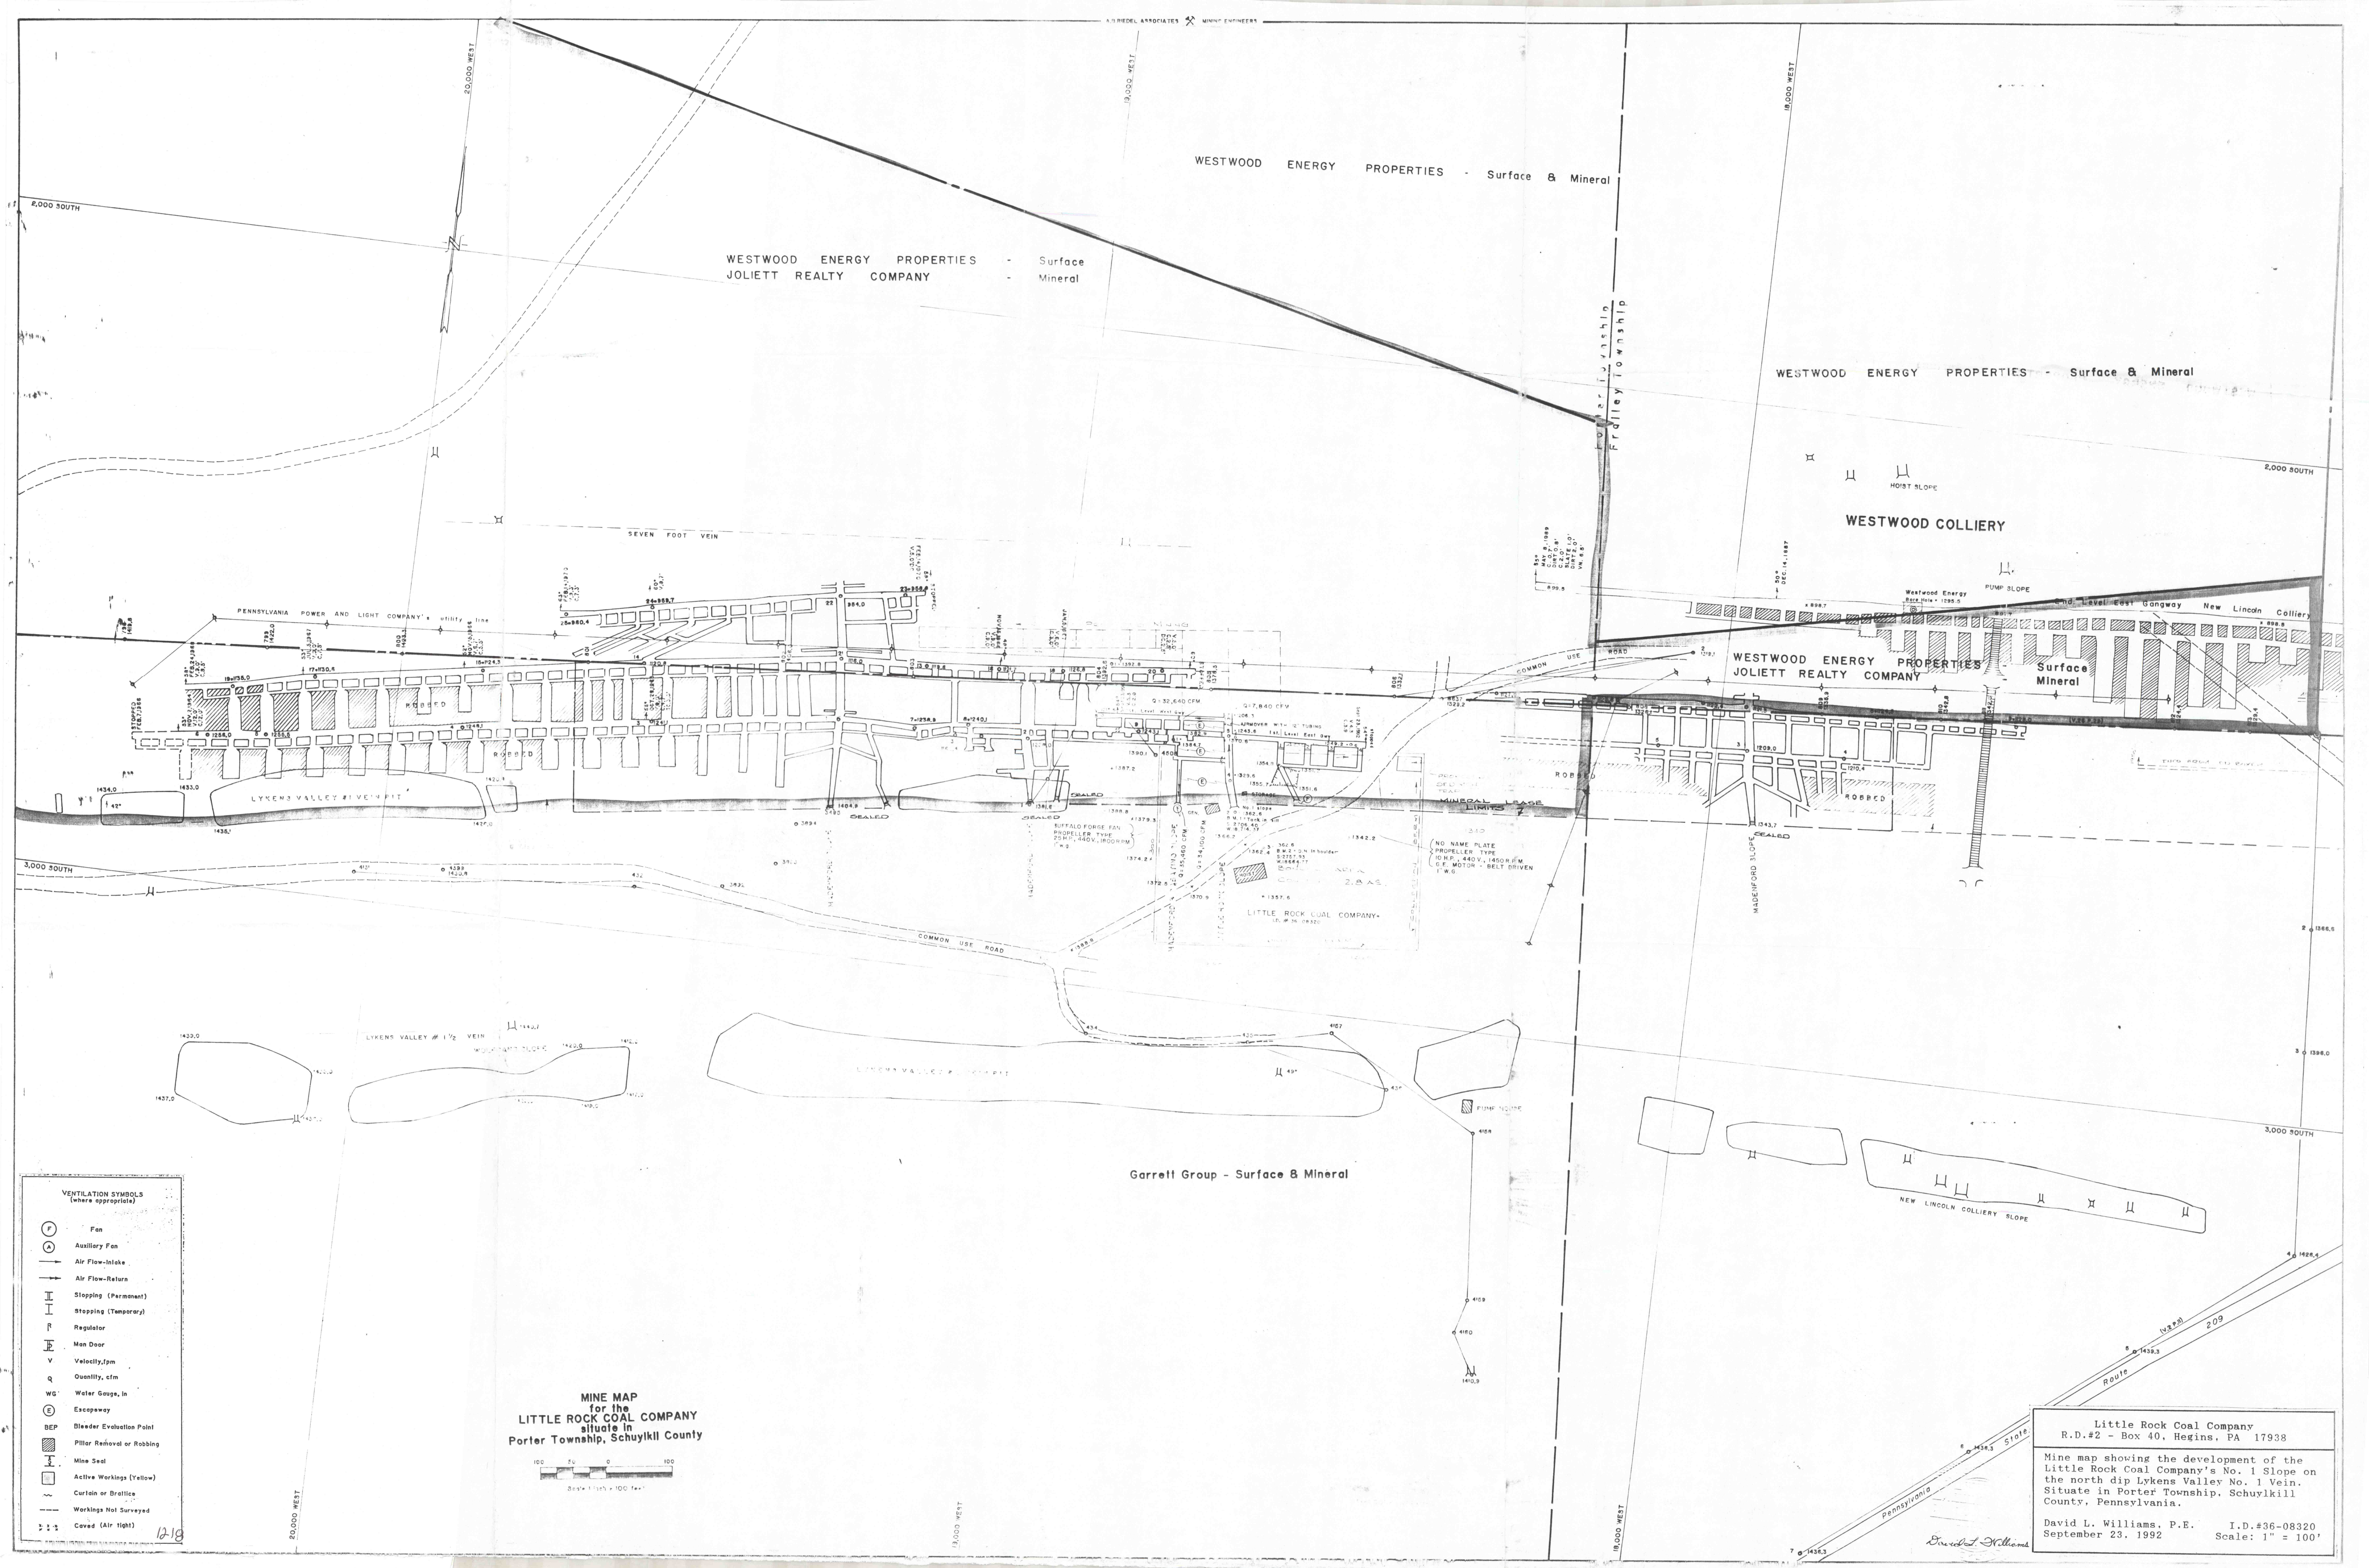

- VENTILATION SYMBOLS
(where appropriate)
- Fan
 - Auxiliary Fan
 - Air Flow-Intake
 - Air Flow-Return
 - Stopping (Permanent)
 - Stopping (Temporary)
 - Regulator
 - Man Door
 - Velocity, fpm
 - Quantity, cfm
 - Water Gauge, in
 - Escapeway
 - Bladder Evacuation Point
 - Pillar Removal or Robbing
 - Mine Seal
 - Active Workings (Yellow)
 - Curtain or Brattice
 - Workings Not Surveyed
 - Caved (Air Tight)

MINE MAP
for the
LITTLE ROCK COAL COMPANY
situate in
Porter Township, Schuylkill County

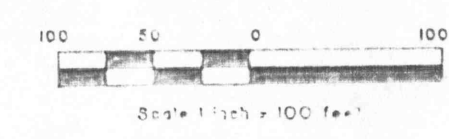

Little Rock Coal Company
R.D.#2 - Box 40, Hegins, PA 17938

Mine map showing the development of the
Little Rock Coal Company's No. 1 Slope on
the north dip Lykens Valley No. 1 Vein.
Situate in Porter Township, Schuylkill
County, Pennsylvania.

David L. Williams, P.E. I.D.#36-08320
September 23, 1992 Scale: 1" = 100'