


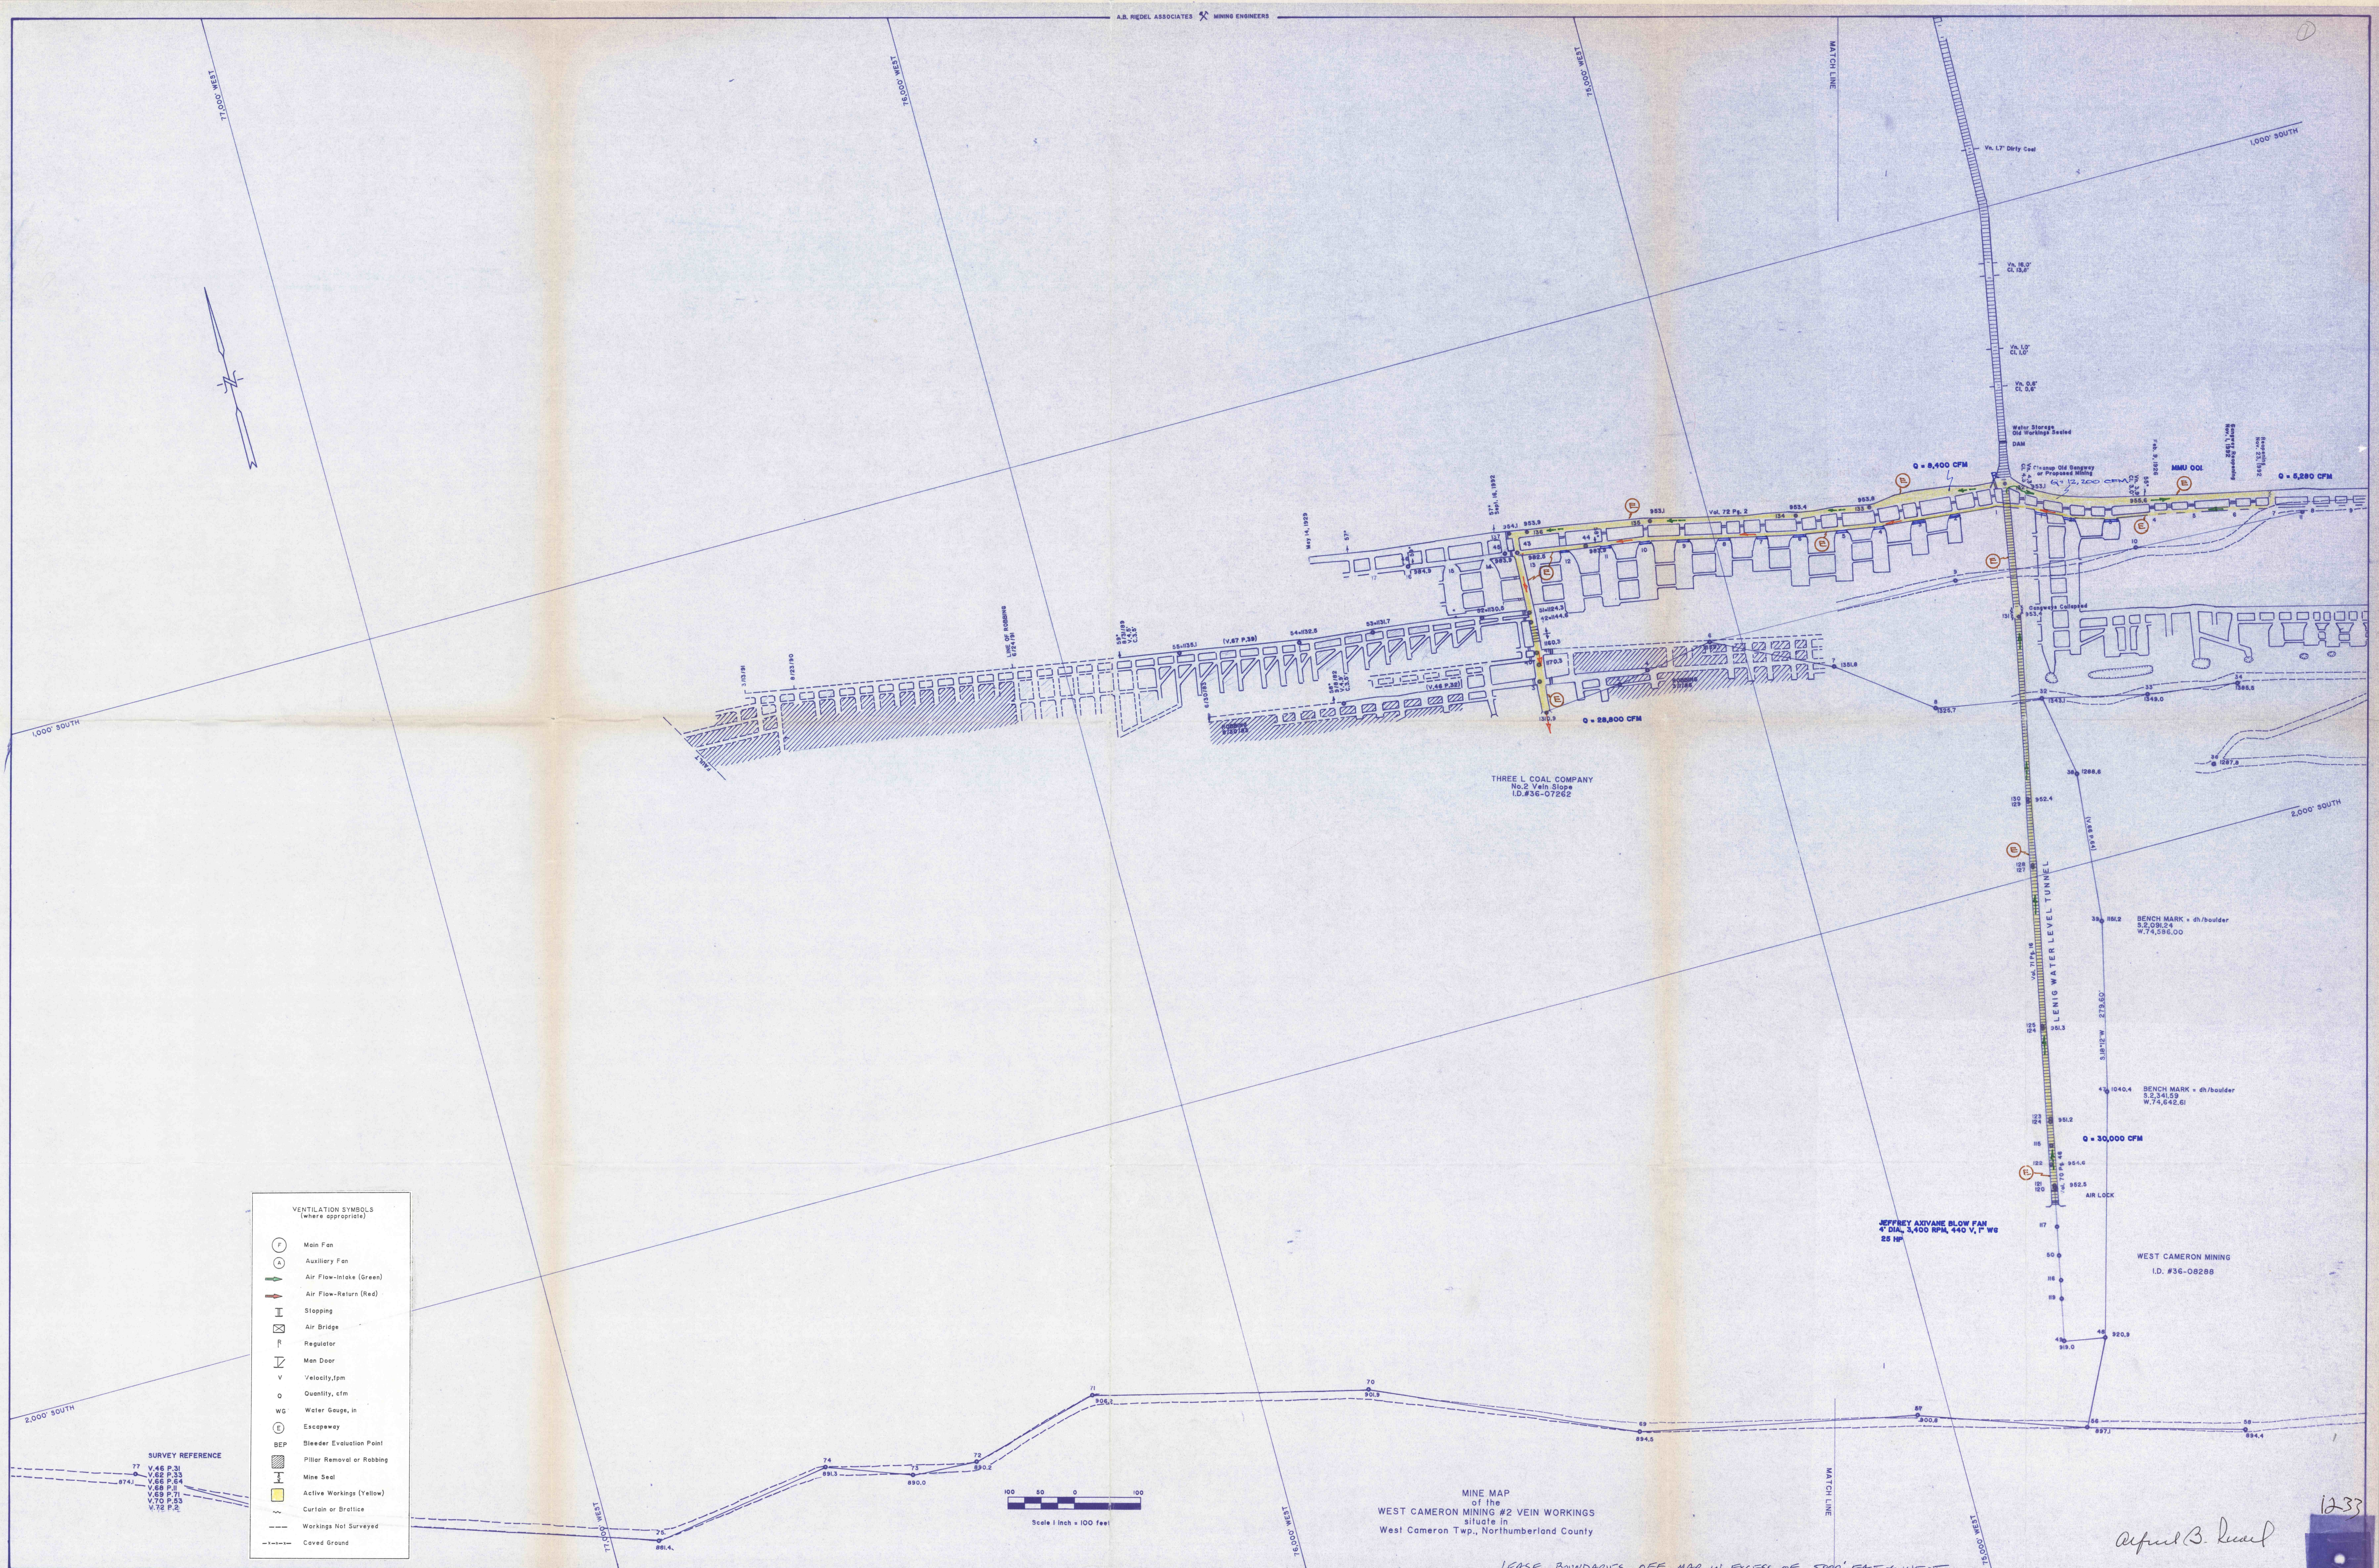

- VENTILATION SYMBOLS
(where appropriate)
- Main Fan
 - Auxiliary Fan
 - Air Flow-Intake (Green)
 - Air Flow-Return (Red)
 - Stopping
 - Air Bridge
 - Regulator
 - Man Door
 - Velocity, fpm
 - Quantity, cfm
 - WG Water Gauge, in
 - Escapeway
 - BEP Bleeder Evaluation Point
 - Pillar Removal or Robbing
 - Mine Seal
 - Active Workings (Yellow)
 - Curtain or Brattice
 - Workings Not Surveyed
 - Caved Ground

SURVEY REFERENCE
77 V.46 P.31
78 V.62 P.33
79 V.66 P.34
80 V.68 P.35
81 V.70 P.36
82 V.72 P.37

Scale 1 inch = 100 feet

MINE MAP
of the
WEST CAMERON MINING #2 VEIN WORKINGS
situated in
West Cameron Twp., Northumberland County

LEASE BOUNDARIES OFF MAP IN EXCESS OF 5000' EAST + WEST

April 3, 1961

1233