HENRY HIMMEREICH TRACT

Lease
Western Property Barrier To No. 12 Vein Slope
No. 7 Vein – South Dip

MATTHIAS ZIMMERMAN & JACOB HELLER TRACT

N –500
E –14500

N –500
E –14000

N –500.000
E –13500.000

N –500
E –13000

N –500
E –12500

N –500
E –12000

N –1000
E –14500

N –1000
E –14000

N –1000
E –13500

N –1000
E –12500

N –1000.000
E –12000.000

N –1500
E –14500

N –1500
E –14000

N –1500
E –13500

N –1500.000
E –13000.000

N –1500
E –12500

N –1500.000
E –12000.000

N

SCALE: 1 INCH = 100 FEET

Sta. #440
#5 Rebar
Elev. 1245.9'
N = –630.76'
E = –13,095.67'

Sta. #410
#5 Rebar
Elev. 1244.3'
N = –691.64'
E = –13,135.69'

Sta. #438
#5 Rebar
Elev. 1236.4'
N = –642.93'
E = –12,985.79'

5' Centrifugal Fan
Unknown Manufacturer
25 HP – 460 Volt – Elec. Motor
1750 RPM
25000 CFM
N –500
E –13000

INTAKE @
SLOPE
14400 CFM

Tipple

2nd Opening
Fan

AC-Generator
General Motors Diesel
460 Volt

#462

Holst

SLOPE

Access Road

To State Route 225

#900

#902

#903

#904

#905

#906

#909

#914

#950

DOOR

SEE SHEET NO. 3
GLEN BURN COLLIERY
NO. 7 VEIN WORKINGS

SEE SHEET NO. 3
GLEN BURN COLLIERY
NO. 7 VEIN WORKINGS

GANGWAY

WORKING FACE
6/26/92

9350 CFM

10560 CFM

FL. ELEV. 775.0

MMU-001

TUNNEL

TUNNEL

Legend:

ESCAPWAY Ⓔ

INTAKE AIR I

RETURN AIR R

PERMANENT STOPPING

PERMANENT STOPPING WITH DOOR D

TEMPORARY STOPPING

BLEEDER EVALUATION POINT BEP

SURVEY STATION #452

ROBBED

OLD WORKING MAPPED BY OTHERS AND/OR INACCESSABLE

AIR READING – CUBIC FEET PER MINUTE 25000 CFM

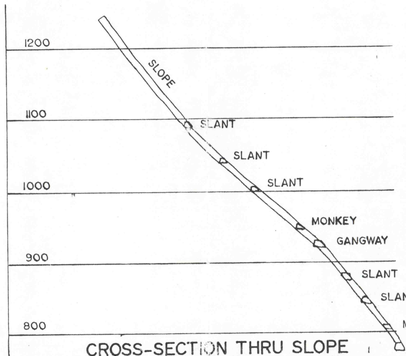

CROSS-SECTION THRU SLOPE
LOOKING EAST

COMMONWEALTH OF PENNSYLVANIA
REGISTERED
HOWARD D. TAYLOR
SURVEYOR
NO. 27521-E

Howard D. Taylor

MINE & VENTILATION MAP

RED BRUSH COAL CO.
No. 7 Vein – South Dip

LOCATED IN
COAL TOWNSHIP
NORTHUMBERLAND COUNTY
PENNSYLVANIA

SCALE: 1 INCH = 100 FEET, MAY 27, 1992

MSHA ID #36-08246 DER PERMIT #49861307

GRAPHIC SCALE

100 0 100 200 400

(IN FEET)
1 inch = 100 ft.

PREPARED FOR:
RED BRUSH COAL CO.
C/O FRANK J. STANKIEWICZ, SR.
1168 MAPLE AVENUE
SHAMOKIN, PA. 17872
(717) 648-3496

PREPARED BY:
TAYLOR-DOBECK ASSOCIATES
PROFESSIONAL LAND SURVEYORS
RD #1, BOX 659
SHAMOKIN, PA. 17872
(717) 648-1976

NO.	DATE	DESCRIPTION	BY

Sub-Surface
Sheet No. 2

1240