


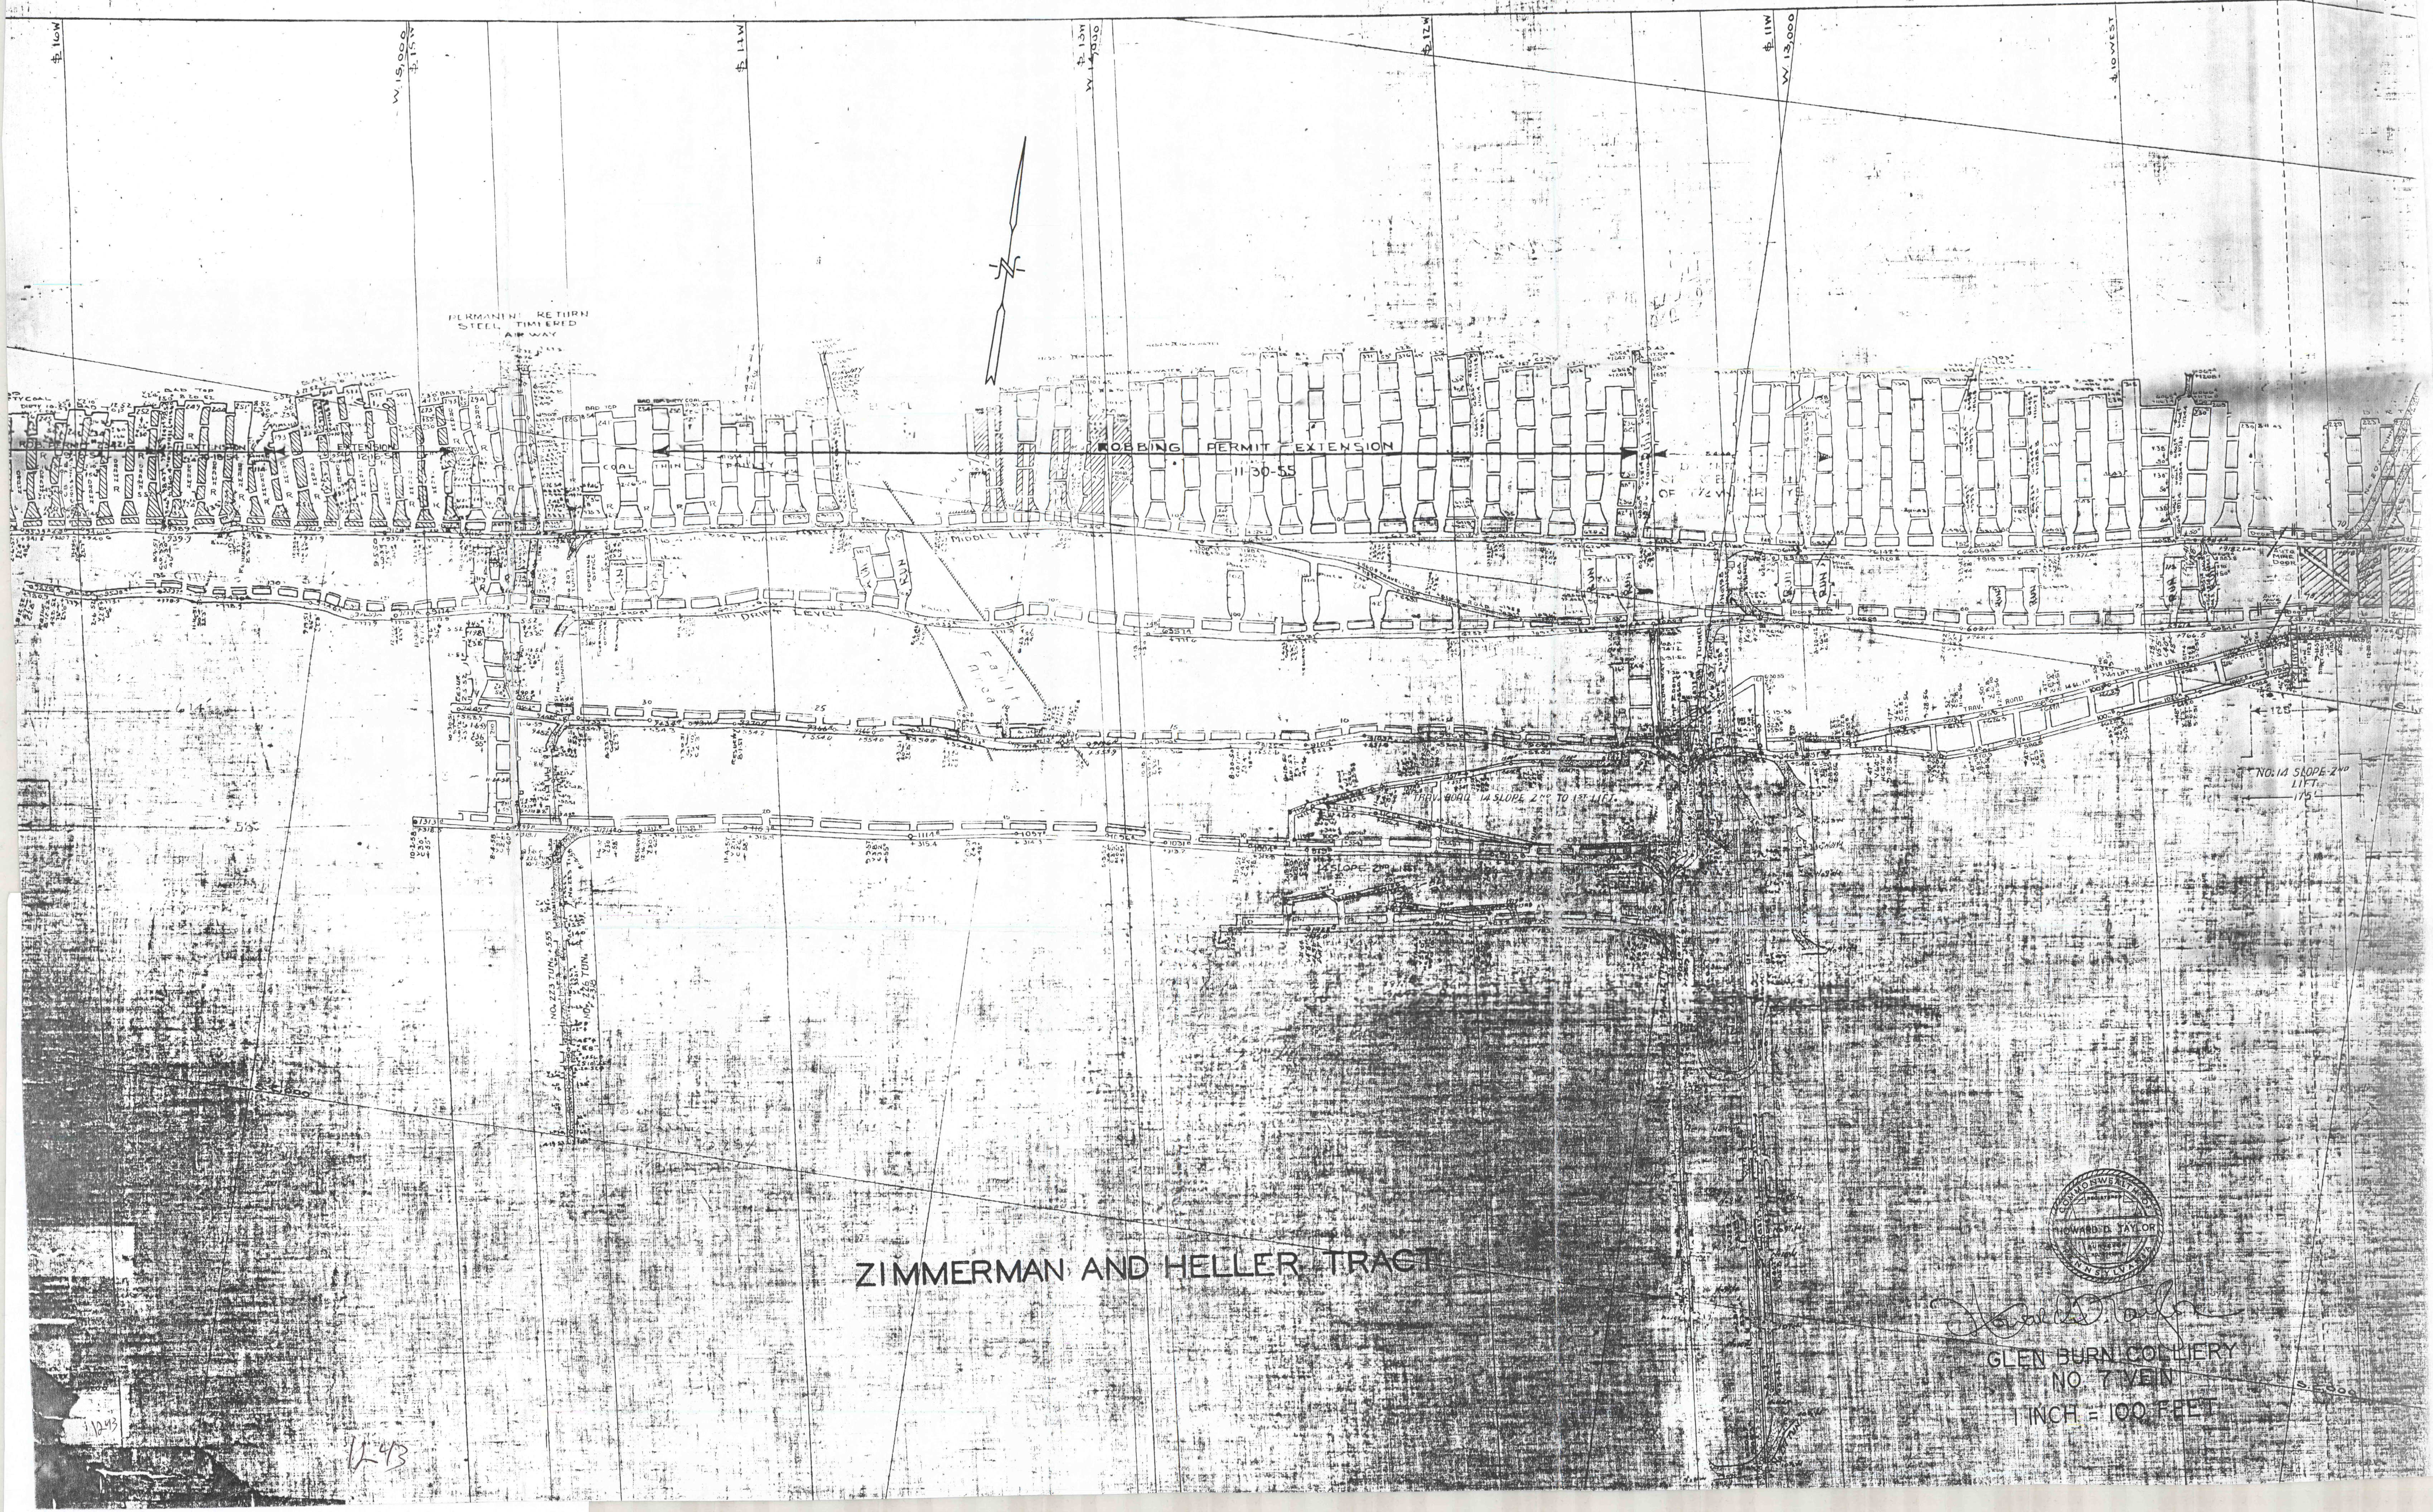

ZIMMERMAN AND HELLER TRACT



Howard D. Taylor
GLEN BURN COLLIERY
NO. 7 VEIN

1 INCH = 100 FEET

1243

U-43