


HENRY HIMMELREICH TRACT



ZIMMERMAN AND HELLER TRACT

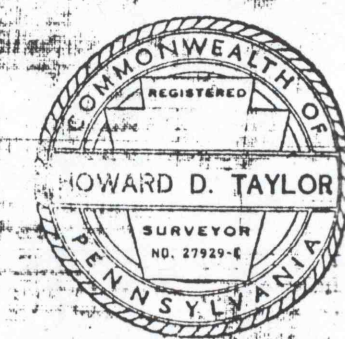

Howard D. Taylor

GLEN BURN COLLIERY
NO. 4 VEIN
1 INCH = 100 FEET

1246