


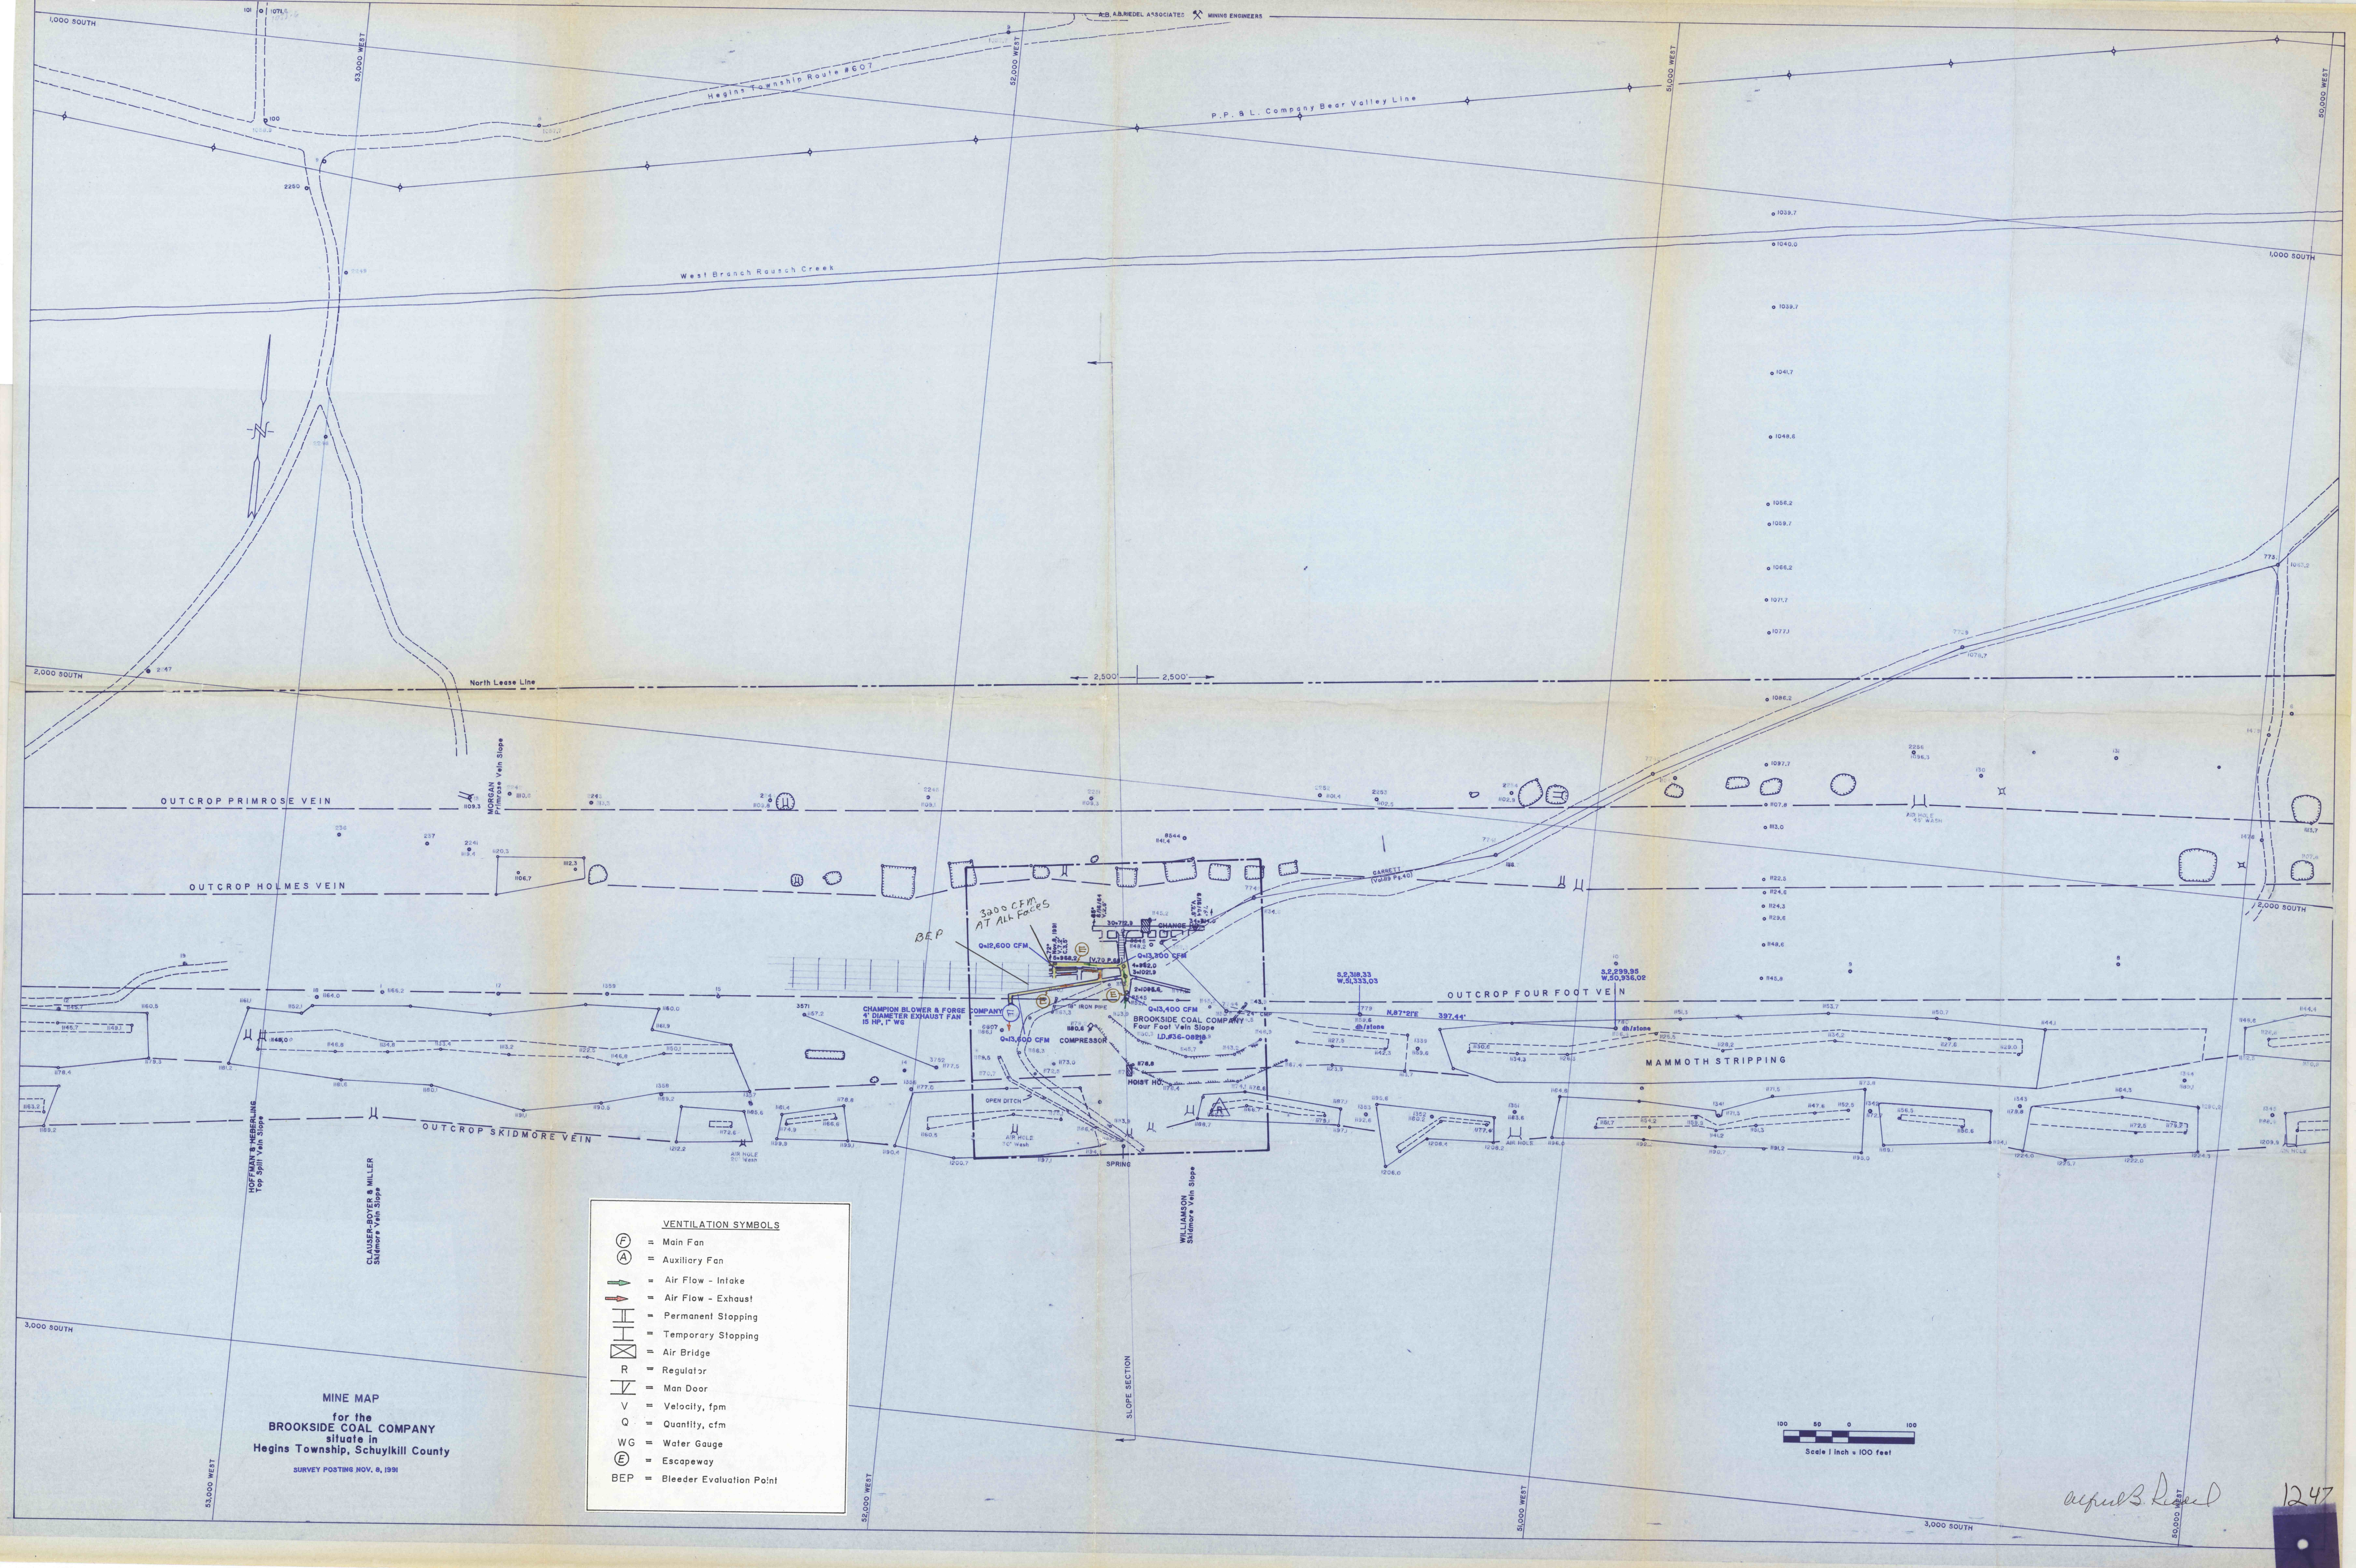

MINE MAP
for the
BROOKSIDE COAL COMPANY
situate in
Hegins Township, Schuylkill County
SURVEY POSTING NOV. 8, 1991

- VENTILATION SYMBOLS**
- (F) = Main Fan
 - (A) = Auxiliary Fan
 - = Air Flow - Intake
 - ← = Air Flow - Exhaust
 - |—|—| = Permanent Stopping
 - - -| - - -| - - -| = Temporary Stopping
 - ⊠ = Air Bridge
 - R = Regulator
 - ∇ = Man Door
 - V = Velocity, fpm
 - Q = Quantity, cfm
 - WG = Water Gauge
 - ⊕ = Escapeway
 - BEP = Bleeder Evaluation Point

100 50 0 50 100
Scale 1 inch = 100 feet

april 3 1992 1247