


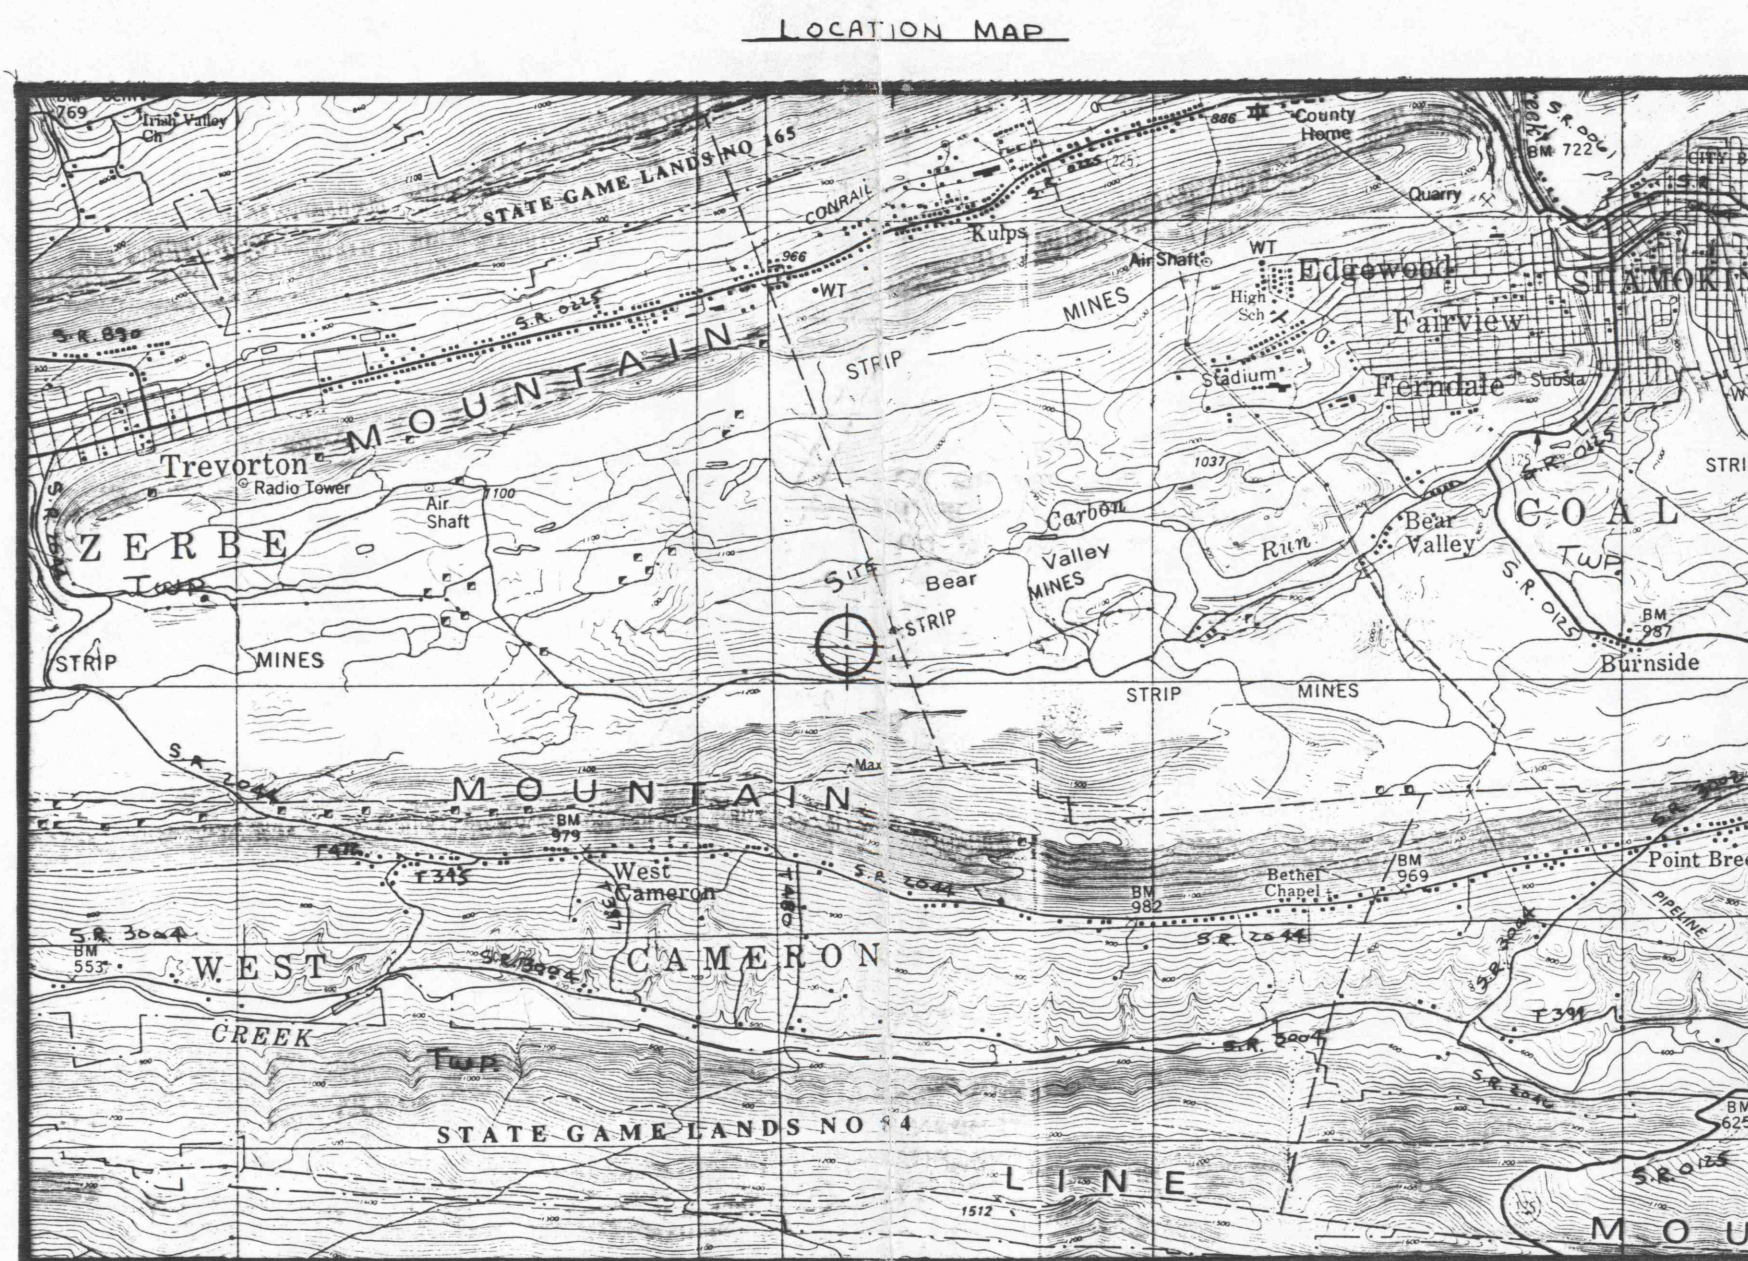

- * NO NEWER MINE MAPS HAVE BEEN DISCOVERED.
- * NO CERTIFICATION IS EXPRESSED OR IMPLIED AS TO THE ACCURACY, EXISTENCE OR NONEXISTENCE OF THE WORKINGS OF THE BEAR VALLEY COLLIARY, VEINS #11 OR #14 MINE MAPS.

- * COORDINATES AND ELEVATIONS BASED ON DATUM OF MINE MAP OF JORDAN COAL COMPANY BY TAYLOR-DOBECK ASSOCIATES, MAY 15, 1990.
- * VENTILATION INFORMATION SUPPLIED BY MINE OPERATOR.
- * COAL VEIN INFORMATION SUPPLIED BY MINE OPERATOR.
- * PROPOSED WORKINGS SUPPLIED BY MINE OPERATOR.



Station No. 11 - Spad in Ceiling
N = -1324.05 (S)
E = -50357.14 (W)
Elev. = 999.5

Station No. 12 - Spad in Ceiling
N = -1301.31 (S)
E = -50359.36 (W)
Elev. = 964.6

Station No. 14 - Spad in Ceiling
N = -1307.32 (S)
E = -50379.16 (W)
Elev. = 965.4
Floor = 960.1

Station No. 58 - Spad in Ceiling
N = -1285.62 (S)
E = -50361.56 (W)
Elev. = 934.37

Station No. 59 - Spad in Ceiling
N = -1265.06 (S)
E = -50363.48 (W)
Elev. = 899.24

Station No. 60 - Spad in Ceiling
N = -1259.18 (S)
E = -50297.04 (W)
Elev. = 901.9

Station No. 61 - Spad in Ceiling
N = -1256.03 (S)
E = -50259.65 (W)
Elev. = 903.3
Floor = 897.9

No. 63 - Top of Shute No. 1
N = -1308+/- (S)
E = -50288+/- (W)
Elev. = 990+/-

Station No. 64 - Spad in Ceiling
N = -1290.84 (S)
E = -50397.65 (W)
Elev. = 937.3
Floor = 932.3


WARNING: ENTERING UNMAPPED WORKINGS MAY BE HAZARDOUS

SEE SPECIAL NOTES

WILLIAM J. MESSNER, P.L.S.
R.D. #1 BOX 1523
HERNDON, PA. 17830
(717) 758-9266
SU-28849-E

LEGEND

(E) ESCAPEWAY
 FALL & EXHAUSTING
 TRAVERSE
 0
 TEMPORARY AIR BATTERIES
 "PLANK" AIR BATTERIES
 (PERMANENT)
 ———— DIRECTION OF AIR FLOW IN
 ———— DIRECTION OF AIR FLOW OUT
 C.F.M. CUBIC FEET PER MINUTE
 OPEN SLOPE
 CLOSED SLOPE
 OVERCAST
 GUY GALVANIZING
 1/4" VENT
 PROPOSED WORKINGS
 FOR ONE YEAR
 I.P. IRON PIN
 DAM
 ELEV. ELEVATION
 OLD WORKINGS
NOT LOCATED BY SURVEY
 H.P. HORSE POWER
 AMPS. AMPERES

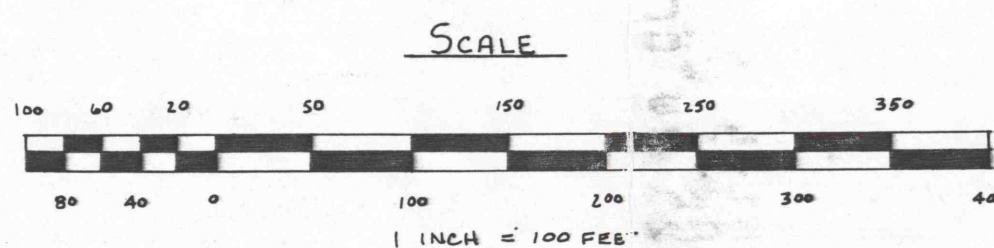

PLAN OF
MINE
AND
VENTILATION
FOR
D.K.D. COAL COMPANY
MSHA I.D. #36-08220
DER I.D. #49881304
715 MAHANDY STREET
TREVORTON, PA. 17881
(717) 797-3050
LOCATED IN
NO. 1 SLOPE
NO. 13 VEIN - NORTH DIP
BEAR VALLEY
TOWNSHIP OF ZERBY
COUNTY OF NORTHUMBERLAND
COMMONWEALTH OF PENNSYLVANIA
SCALE AS NOTED
DATE: NOVEMBER 8, 1991
FILE: D.K.D. COAL

REVISED: NOV. 14, 1991